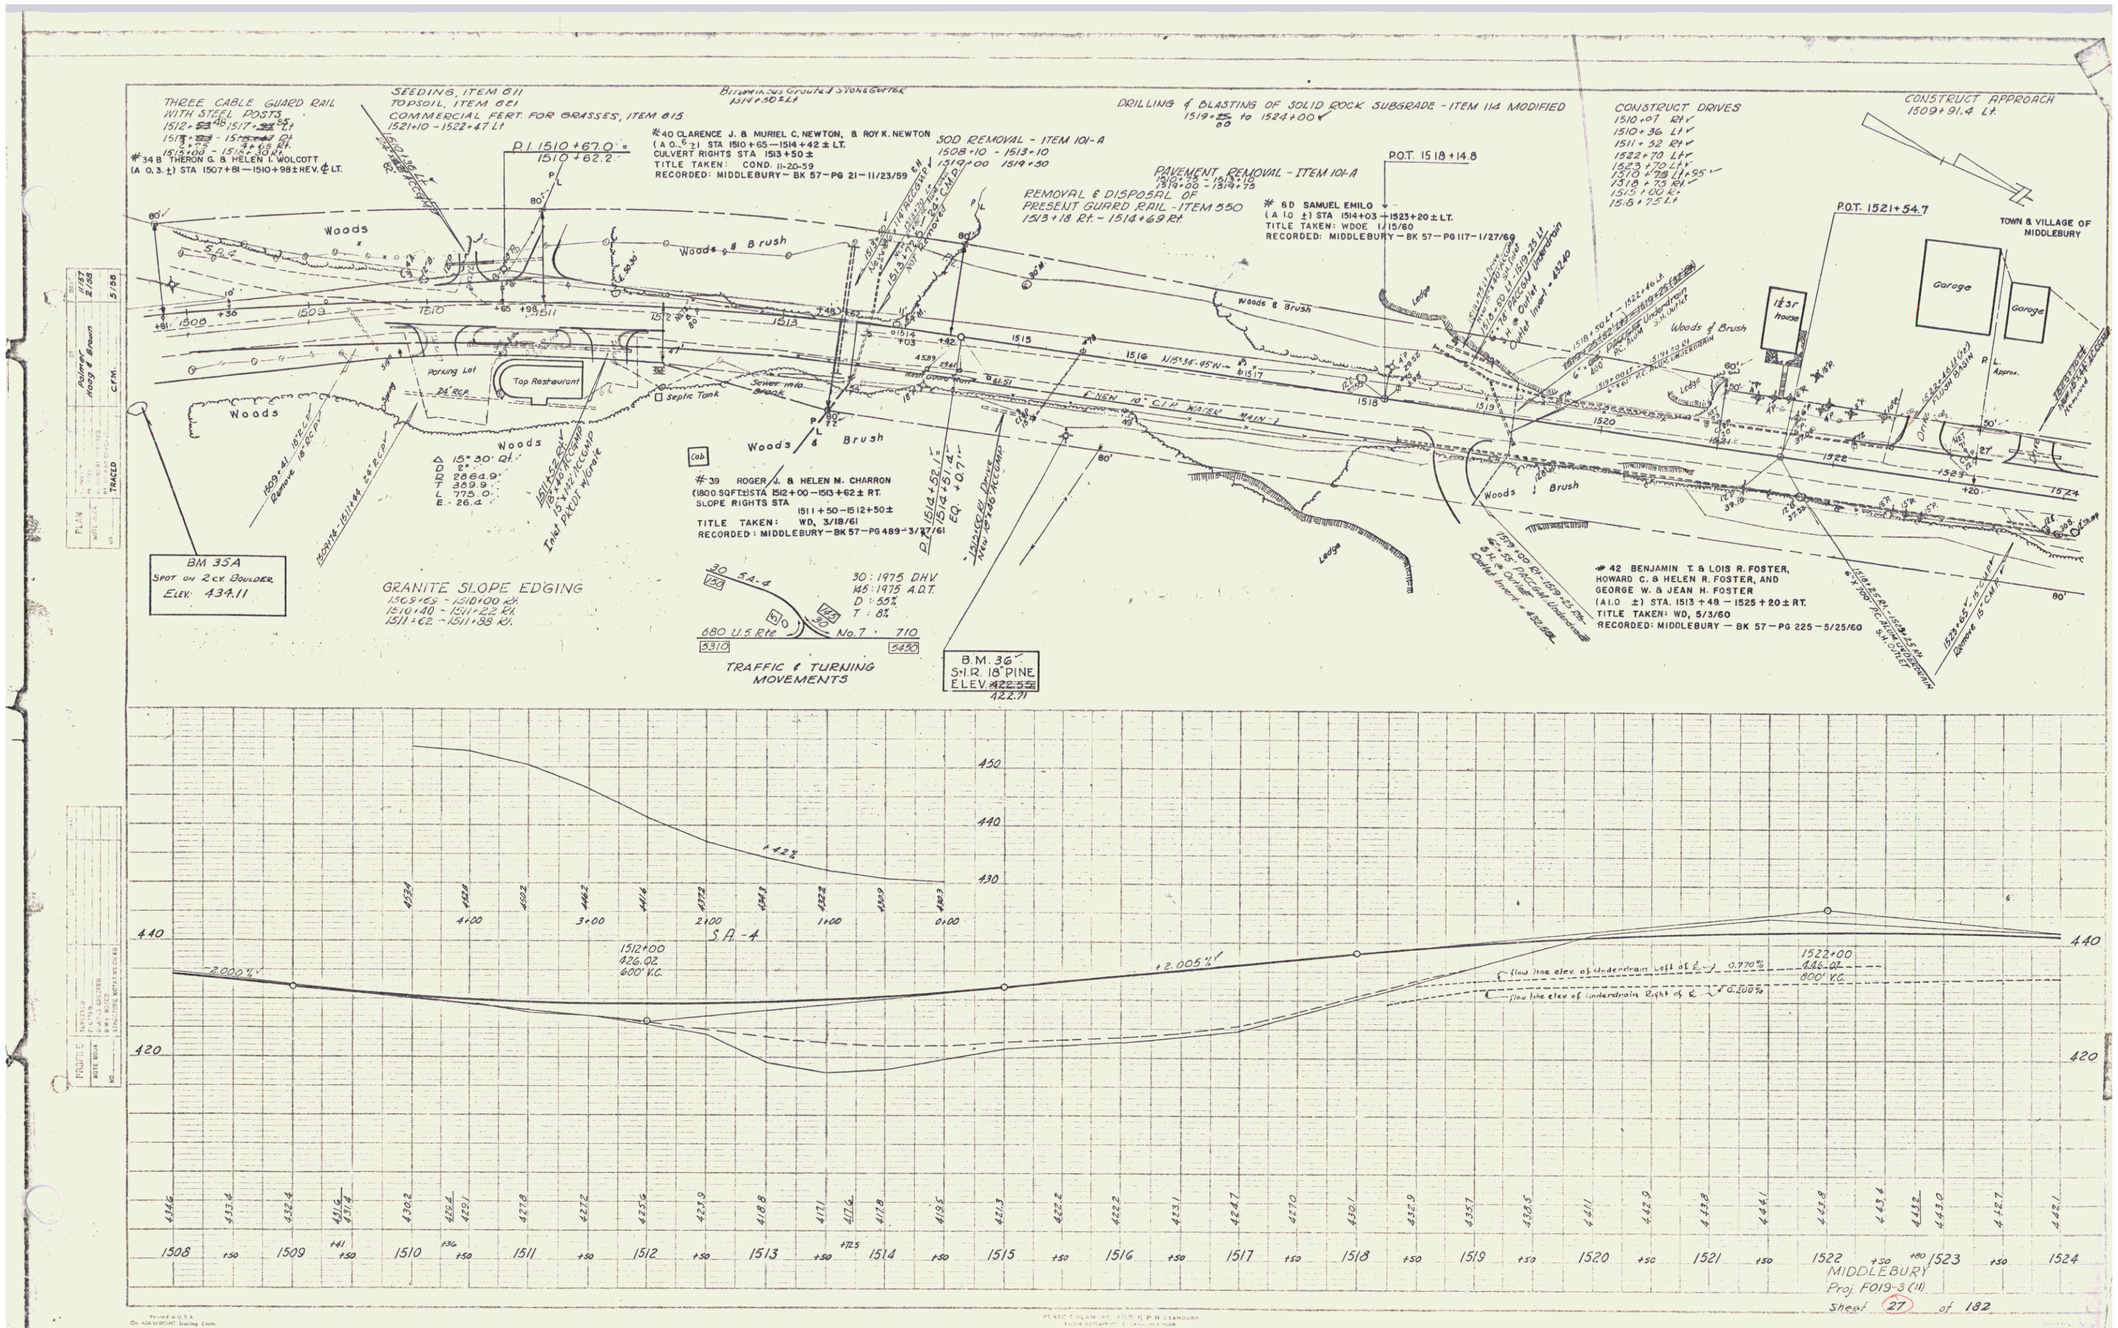
THREE CABLE GUARD RAIL WITH STEEL POSTS
SEEDING, ITEM 611
TOPSOIL, ITEM 621
COMMERCIAL FERT. FOR GRASSES, ITEM 615
1521+10 - 1522+47 Lt
#40 CLARENCE J. & MURIEL C. NEWTON, & ROY K. NEWTON
(A 0.5 ±) STA 1510+65 - 1514+42 ± LT.
CULVERT RIGHTS STA 1513+50 ±
TITLE TAKEN: COND. 11-20-59
RECORDED: MIDDLEBURY - BK 57 - PG 21 - 11/23/59
#34 B THERON G. & HELEN I. WOLCOTT
(A 0.3 ±) STA 1507+81 - 1510+98 ± HEV. ℄ LT.
SOD REMOVAL - ITEM 101-A
1508+10 - 1513+10
1519+00 - 1519+50
DRILLING & BLASTING OF SOLID ROCK SUBGRADE - ITEM 114 MODIFIED
1519+55 to 1524+00
CONSTRUCT DRIVES
1510+97 Rt
1510+36 Lt
1511+52 Rt
1522+70 Lt
1523+70 Lt
1519+75 Rt
1515+00 Rt
1516+75 Lt
CONSTRUCT APPROACH
1509+91.4 Lt
PAVEMENT REMOVAL - ITEM 101-A
1519+55 - 1519+75
REMOVAL & DISPOSAL OF PRESENT GUARD RAIL - ITEM 550
1513+18 Rt. - 1514+69 Rt.
#60 SAMUEL EMILO
(A 1.0 ±) STA 1514+03 - 1523+20 ± LT.
TITLE TAKEN: WDOE 11/15/60
RECORDED: MIDDLEBURY - BK 57 - PG 117 - 1/27/60
P.I. 1510+67.0
1510+62.2
P.O.T. 1518+14.8
P.O.T. 1521+54.7
TOWN & VILLAGE OF MIDDLEBURY
Woods
Woods & Brush
Parking Lot
Top Restaurant
Septic Tank
Sewer into Brook
Ledge
Garage
Garage
Lodge
Approx.
#39 ROGER J. & HELEN M. CHARRON
(1800 SQFT ± STA 1512+00 - 1513+62 ± RT.
SLOPE RIGHTS STA 1511+50 - 1512+50 ±
TITLE TAKEN: WD, 3/18/61
RECORDED: MIDDLEBURY - BK 57 - PG 489 - 3/27/61
BM 35A
SPOT ON 2 CY BOULDER
ELEV. 434.11
GRANITE SLOPE EDGING
1509+65 - 1510+00 Rt
1510+40 - 1511+22 Rt
1511+62 - 1511+88 Rt
680 U.S. Rte No. 7 710
30 : 1975 D.H.V.
145 : 1975 A.D.T.
D : 55%
T : 8%
TRAFFIC & TURNING MOVEMENTS
B.M. 36
5" I.R. 18" PINE
ELEV. 422.71
#42 BENJAMIN T. & LOIS R. FOSTER, HOWARD C. & HELEN R. FOSTER, AND GEORGE W. & JEAN H. FOSTER
(A 1.0 ±) STA. 1513+48 - 1525+20 ± RT.
TITLE TAKEN: WD, 5/3/60
RECORDED: MIDDLEBURY - BK 57 - PG 225 - 5/25/60
S.A.-4
1512+00
426.02
600' V.C.
-2.000%
+2.005%
+1.42%
1522+00
flow line elev. of underdrain Left of ℄ 0.770%
flow line elev. of underdrain Right of ℄ 0.200%
1508 1509 1510 1511 1512 1513 1514 1515 1516 1517 1518 1519 1520 1521 1522 1523 1524
MIDDLEBURY
Proj F019-3(11)
Sheet 27 of 182

