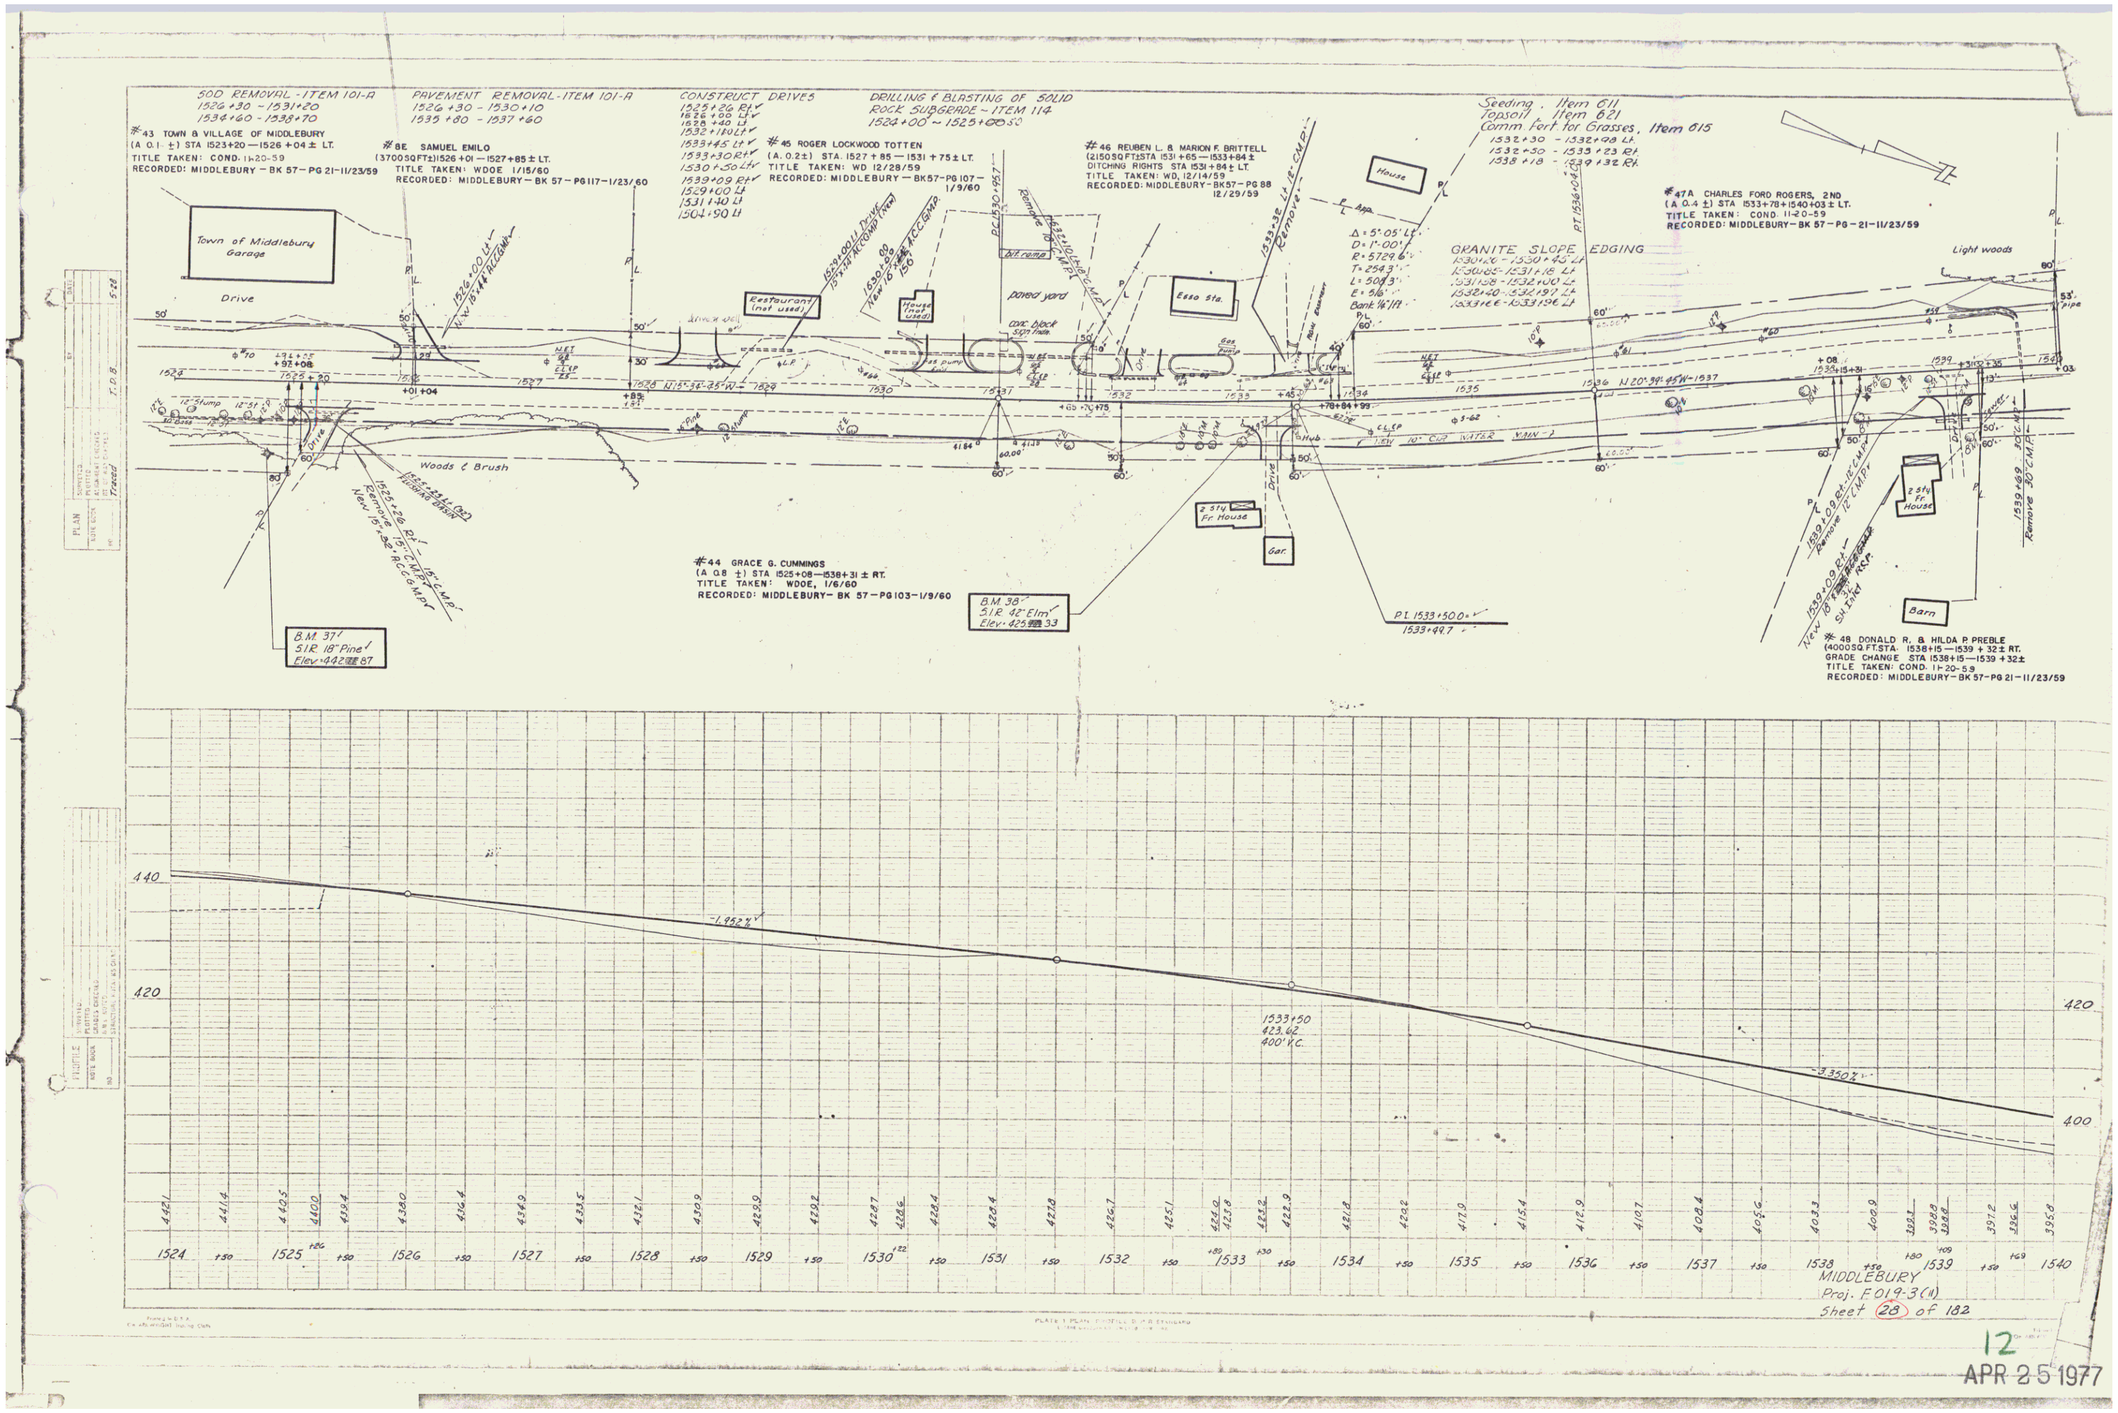

12

APR 25 1977