POOR ORIGINAL COPY

STATE OF VERMONT
AGENCY OF TRANSPORTATION

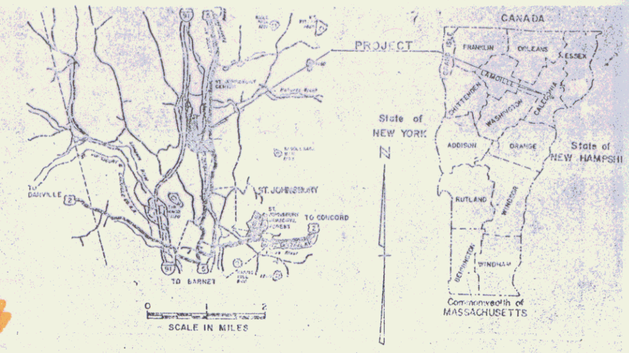

PROPOSED IMPROVEMENT
TOWN OF ST. JOHNSBURY
COUNTY OF CALEDONIA
INTERSTATE CONNECTOR

R.O.W. PLANS

BEGINNING AT THE INTERSECTION OF U.S. ROUTE 5 AND THE NORTHEAST VERMONT REGIONAL HOSPITAL ROAD AND EXTENDING WESTERLY AND THEN NORTHERLY MILES TO THE I 91 ST. JOHNSBURY NORTH INTERCHANGE.

LENGTH OF ROADWAY 3213.44 FEET = 0.609 MILES
LENGTH OF BRIDGE 365.00 FEET = 0.073 MILES
LENGTH OF PROJECT 3578.44 FEET = 0.682 MILES
LENGTH OF R.O.W. PROJ. 3600.00 FEET = 0.682 MILES

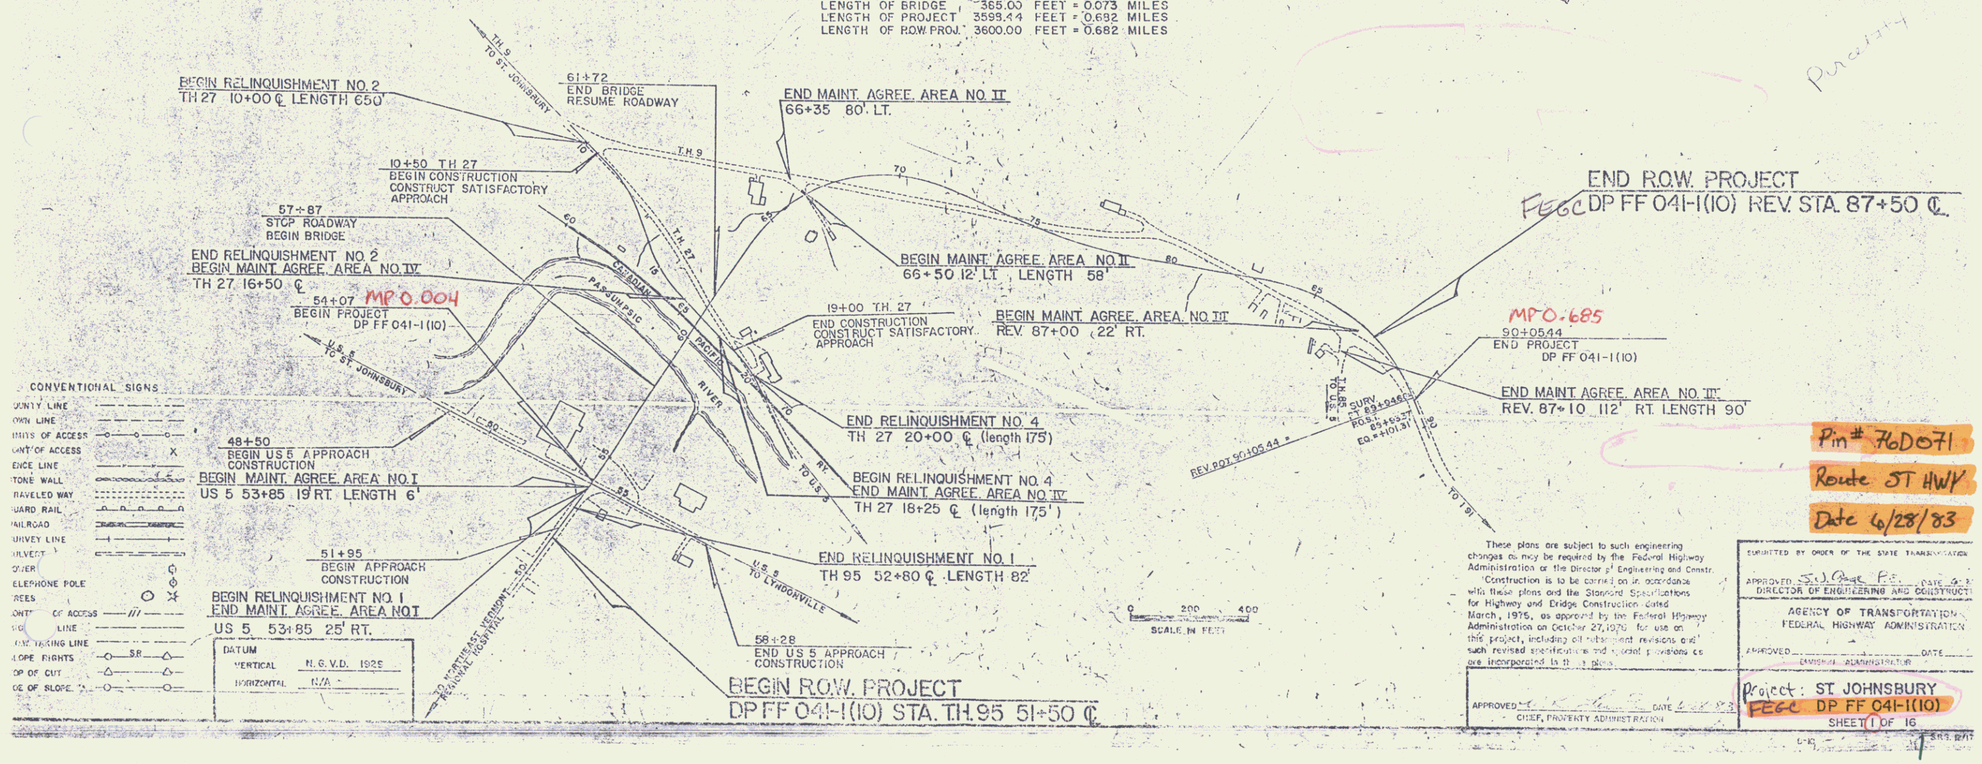

CONVENTIONAL SIGNS

COUNTY LINE
TOWN LINE
LIMITS OF ACCESS
POINT OF ACCESS
FENCE LINE
STONE WALL
TRAVELED WAY
GUARD RAIL
RAILROAD
SURVEY LINE
CULVERT
POWER
TELEPHONE POLE
TREES
POINT OF ACCESS
SIGN
CLEARING LINE
SLOPE RIGHTS
TOP OF CUT
TOE OF SLOPE

DATUM
VERTICAL N.G.V.D. 1929
HORIZONTAL N/A

These plans are subject to such engineering changes as may be required by the Federal Highway Administration or the Director of Engineering and Constr. Construction is to be carried on in accordance with these plans and the Standard Specifications for Highway and Bridge Construction dated March, 1976, as approved by the Federal Highway Administration on October 27, 1976 for use on this project, including all subsequent revisions and such revised specifications and special provisions as are incorporated in the plans.

APPROVED _____ DATE _____
CHIEF, PROPERTY ADMINISTRATION

SUBMITTED BY ORDER OF THE STATE TRANSPORTATION
APPROVED S.J. Page P.E. DATE 6-2-83
DIRECTOR OF ENGINEERING AND CONSTRUCTION

AGENCY OF TRANSPORTATION
FEDERAL HIGHWAY ADMINISTRATION
APPROVED _____ DATE _____
DIVISION ADMINISTRATOR

Pin # 76D071
Route ST HWY
Date 6/28/83

Project: ST JOHNSBURY
FEGC DP FF 041-1(10)
SHEET 1 OF 16