POOR ORIGINAL COPY

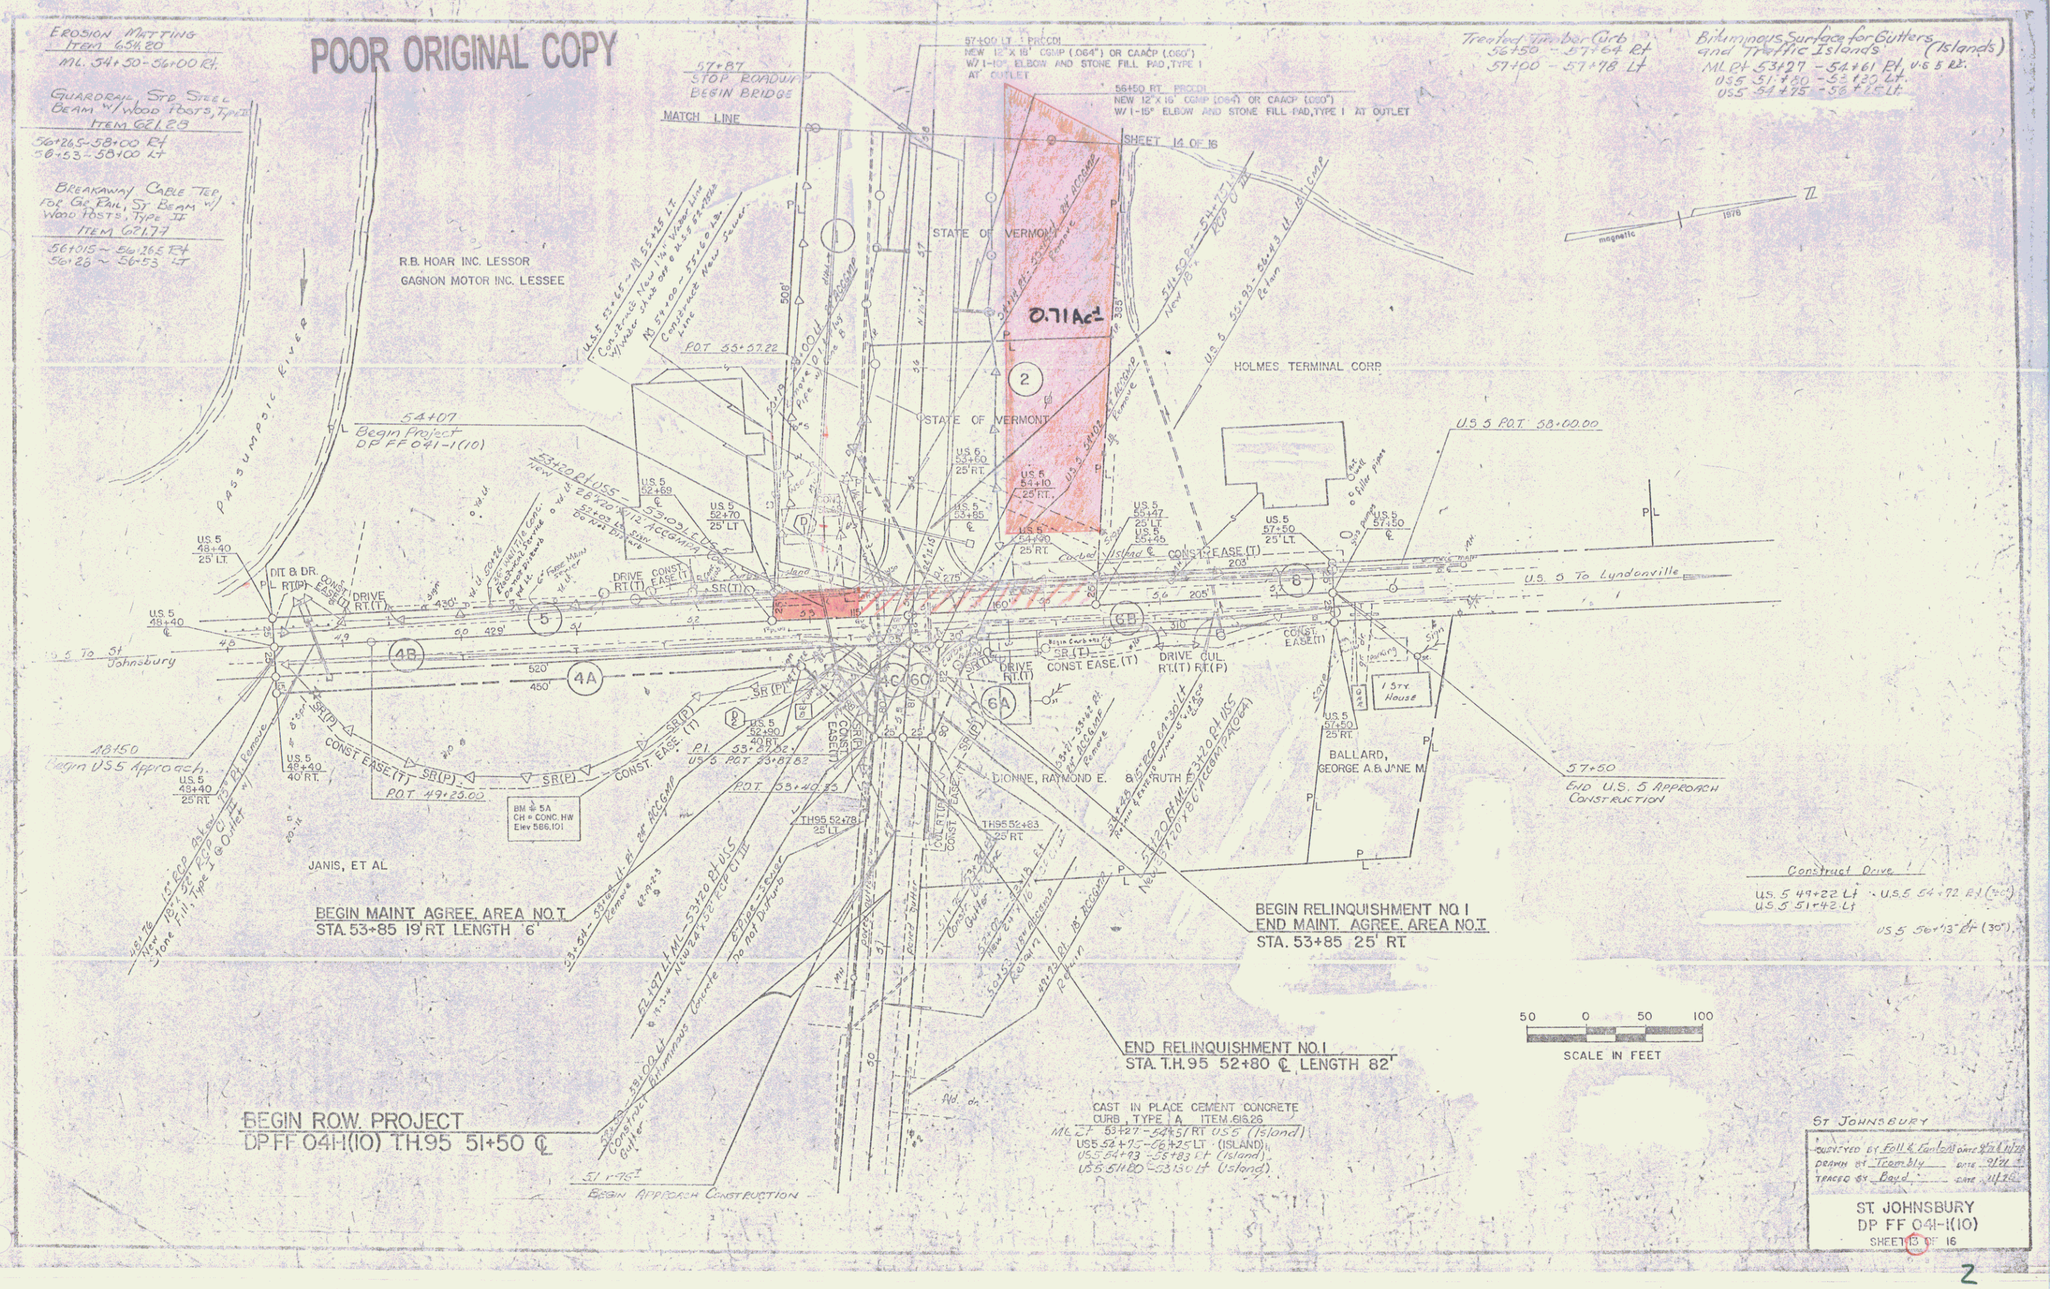

2