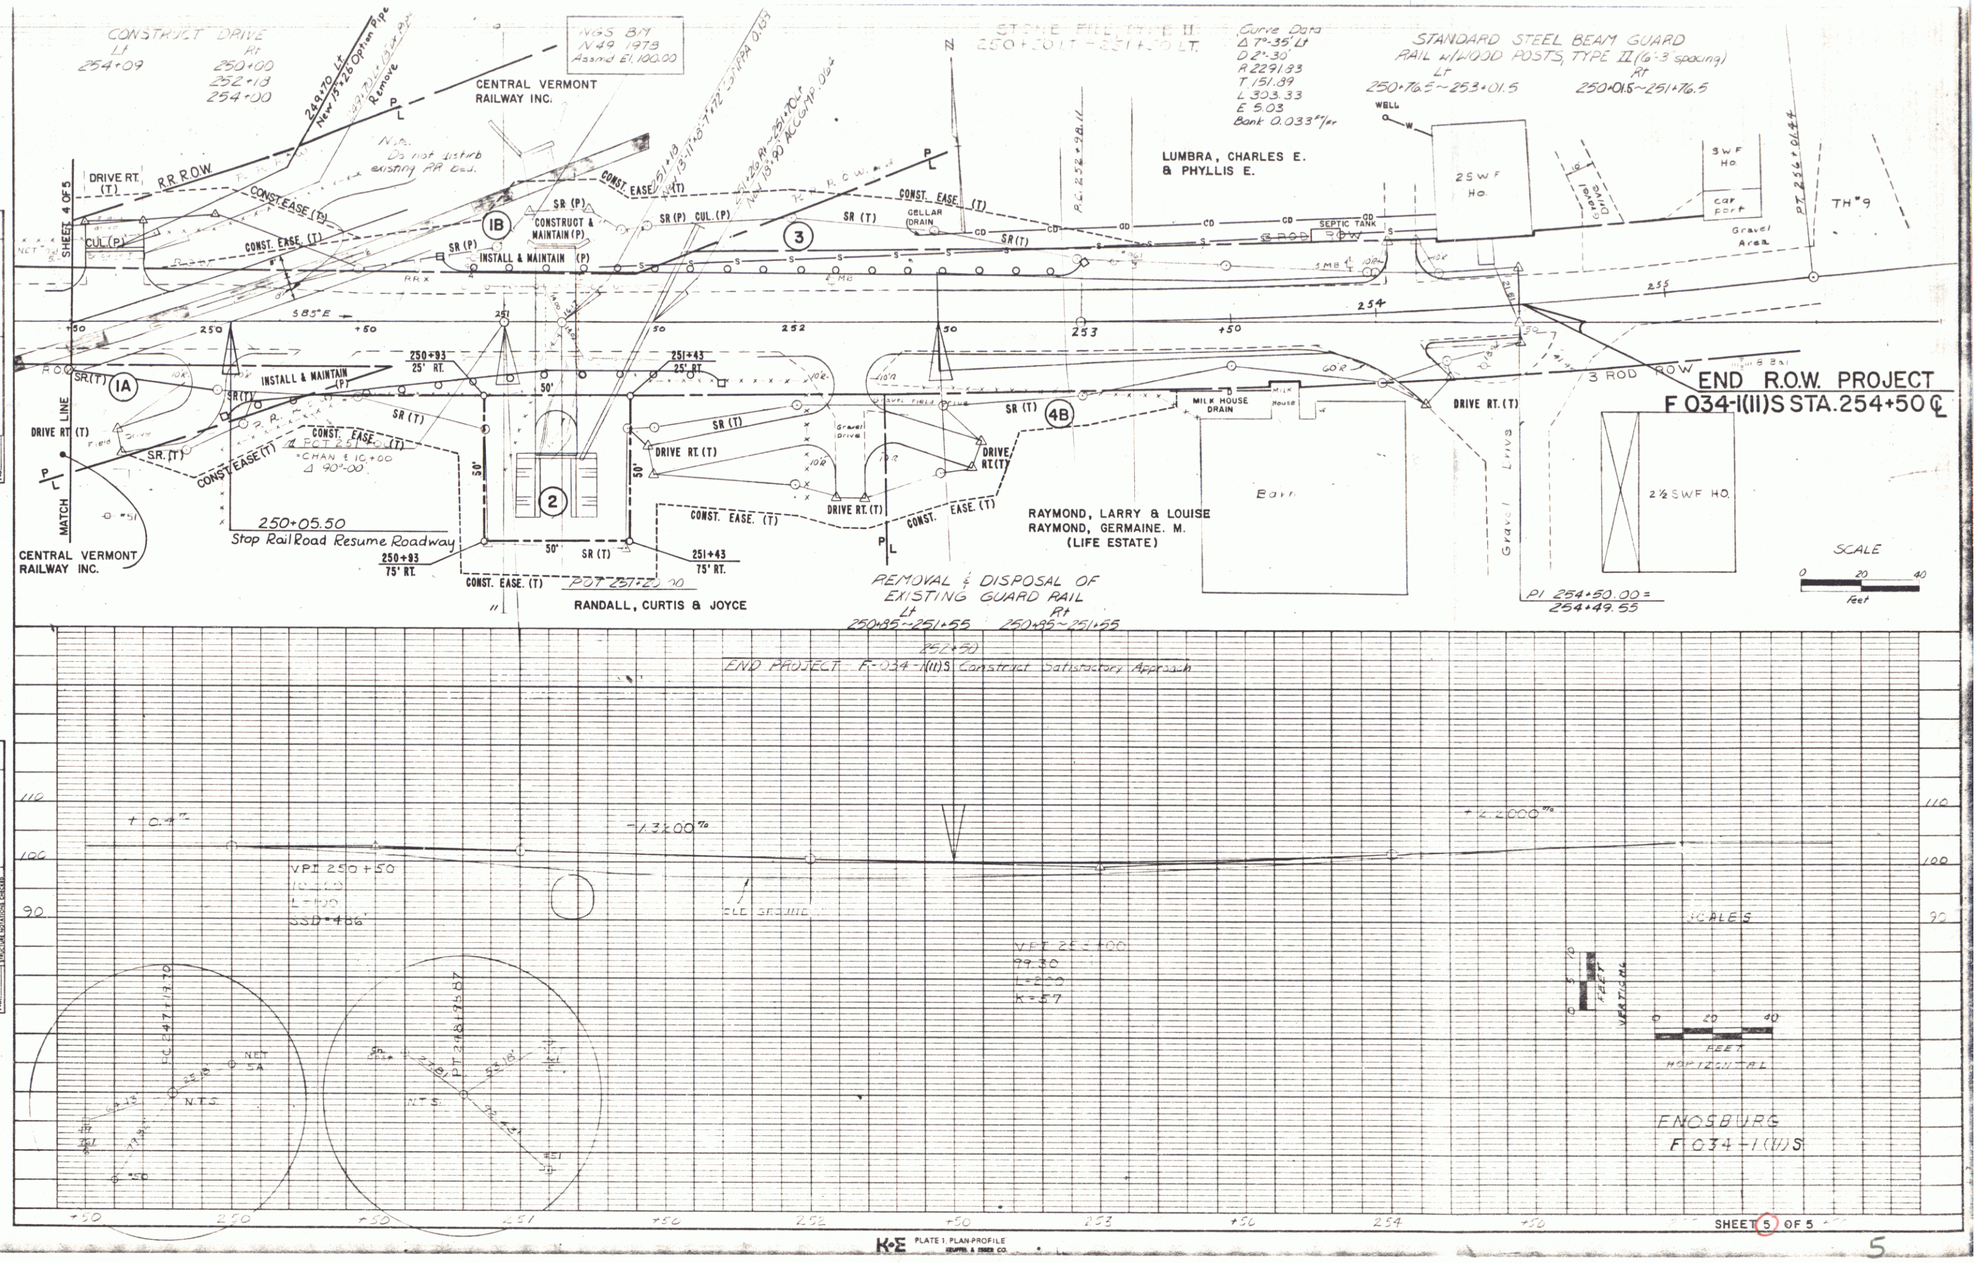

SHEET 5 OF 5

K+E PLATE 1. PLAN-PROFILE KEUFFEL & ESSER CO.

5