


Existing Bridge  
Concrete Slab (Built in 1922)  
Solid Concrete Guard Rail

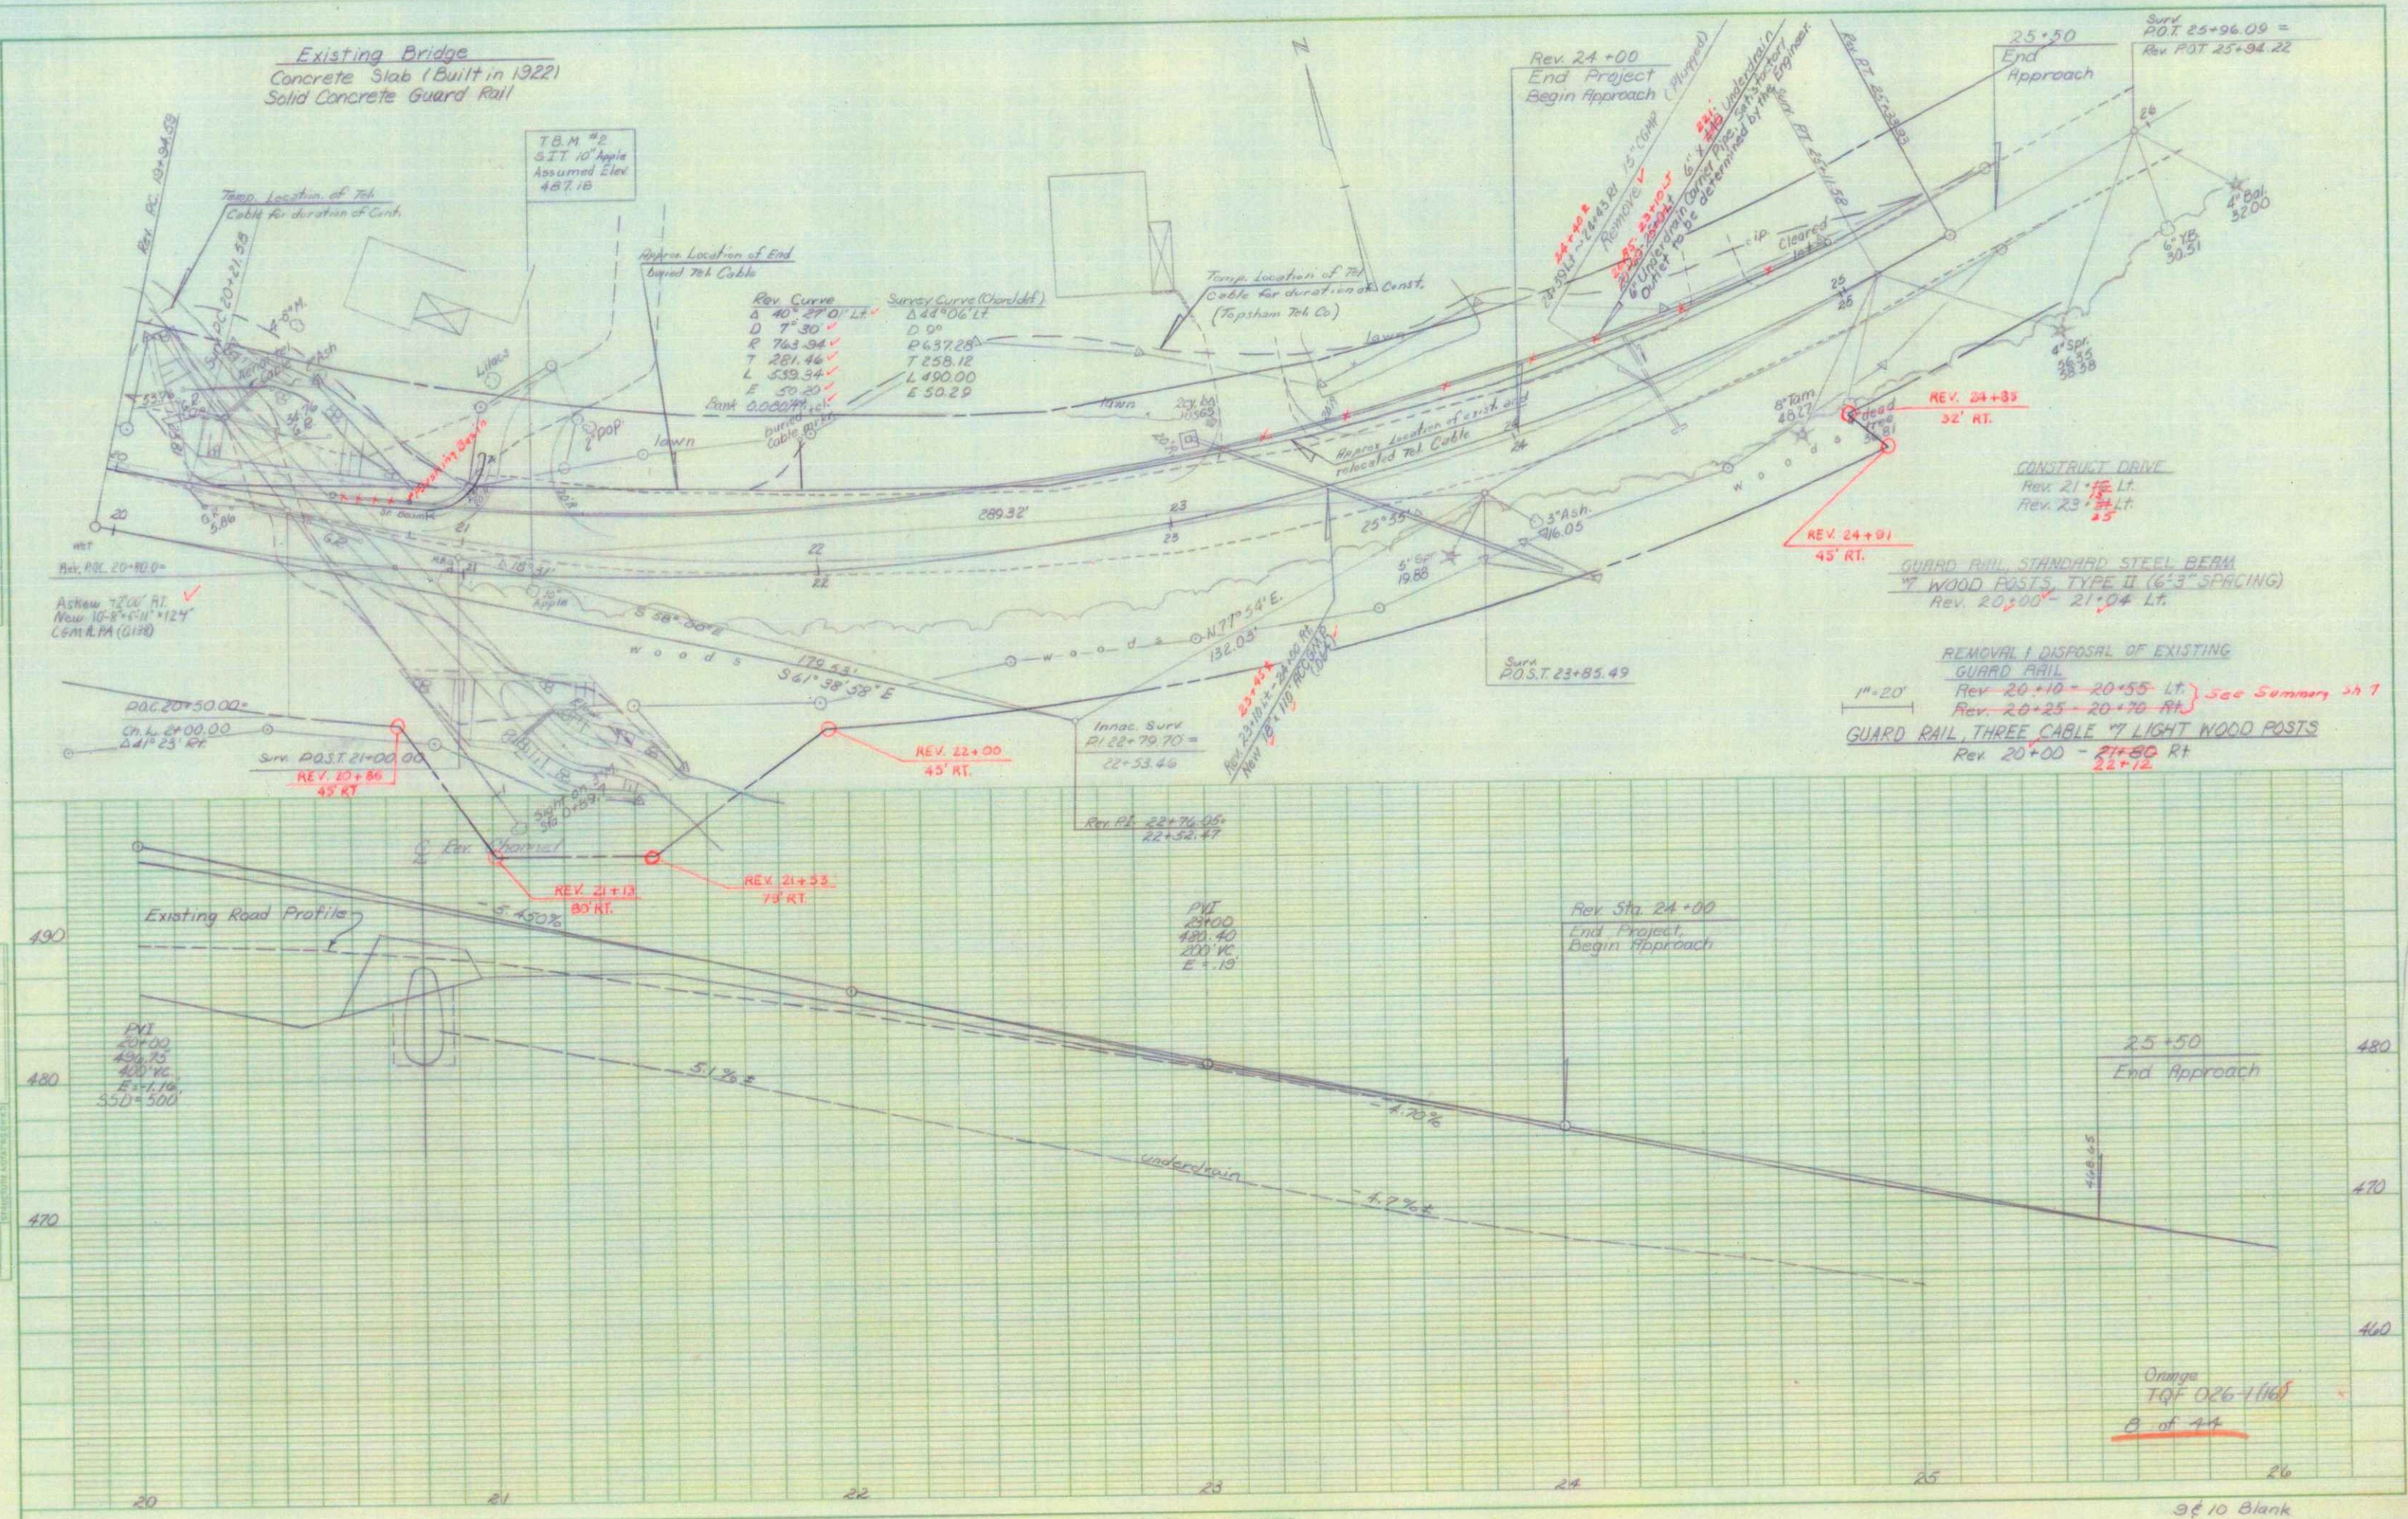

Survey Curve (Chorded)

Δ	40° 27' 01" LT	Δ	43° 06' 11" LT
D	7' 30"	D	0"
R	763.94'	P	637.28'
T	281.46'	T	258.12'
L	539.34'	L	490.00'
E	50.29'	E	50.29'

CONSTRUCT DRIVE  
Rev. 21+10 - 21+15 LT.  
Rev. 23+10 - 23+15 LT.

GUARD RAIL, STANDARD STEEL BERM  
"Y" WOOD POSTS, TYPE II (6'3" SPACING)  
Rev. 20+00 - 21+04 LT.

REMOVAL / DISPOSAL OF EXISTING  
GUARD RAIL  
Rev. 20+10 - 20+55 LT. See Summary on 7  
Rev. 20+25 - 20+76 RT.

GUARD RAIL, THREE CABLE "Y" LIGHT WOOD POSTS  



Orange  
TQF 026-1168  
A of 44