REMOVAL AND DISPOSAL OF EXISTING GUARD RAIL
338+10 ~ 341+06 Rt

GUARD RAIL, STD. STEEL BEAM w/ WOOD POSTS, TYPE II
338+10 - 346+00 Rt

CONSTRUCT DRIVE
Rev 343+50 Lt
Rev 345+68 Lt
Rev 344+50 ~ 346+00 Rt

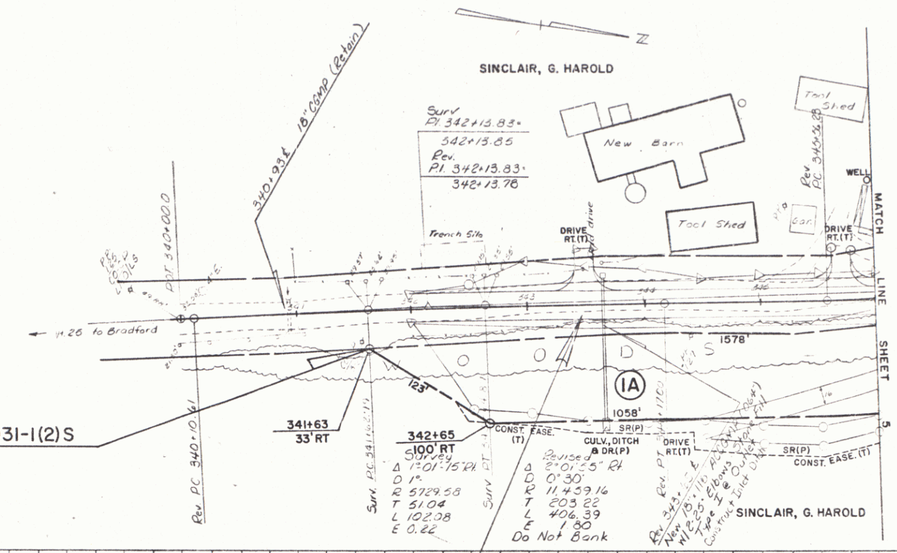

BEGIN R.O.W. PROJECT F-TQF 031-1(2)S
STA. 341+63 RT.

PLAN
NOTE BOOK No.
SURVEYED
PLOTTED
ALIGNMENT CHECKED
R.O.W. NOTED
ST. OF WAY CHECKED
DATE 6-22

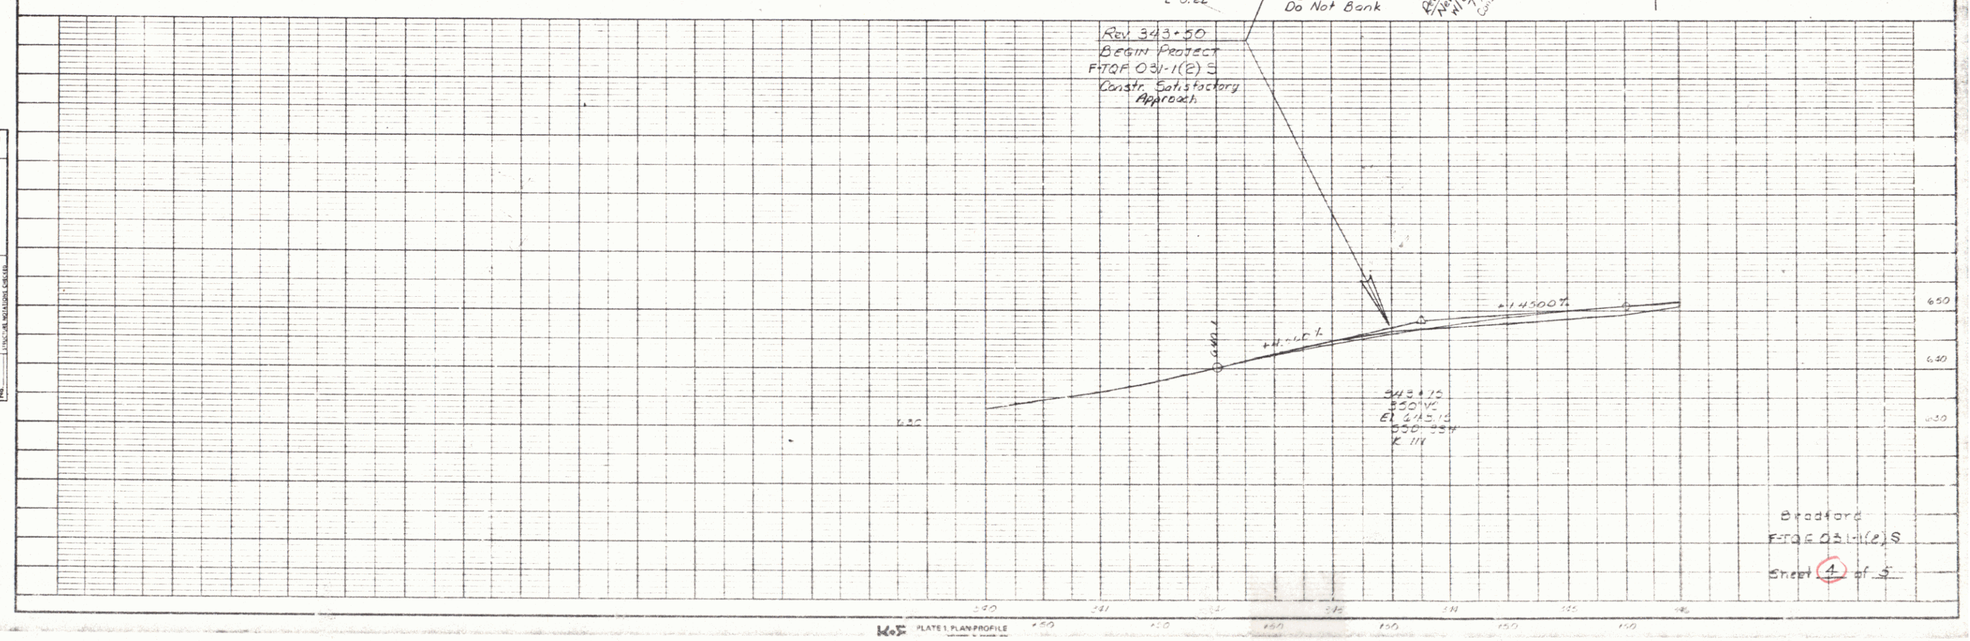

PROFILE
NOTE BOOK No.
SURVEYED
PLOTTED
VERTICAL
R.O.W. NOTED
LEVELS, BENCHMARKS, CHECKED
DATE 6-22

Bradford
F-TQF 031-1(2)S
Sheet 4 of 5

K+F PLATE 1, PLAN-PROFILE