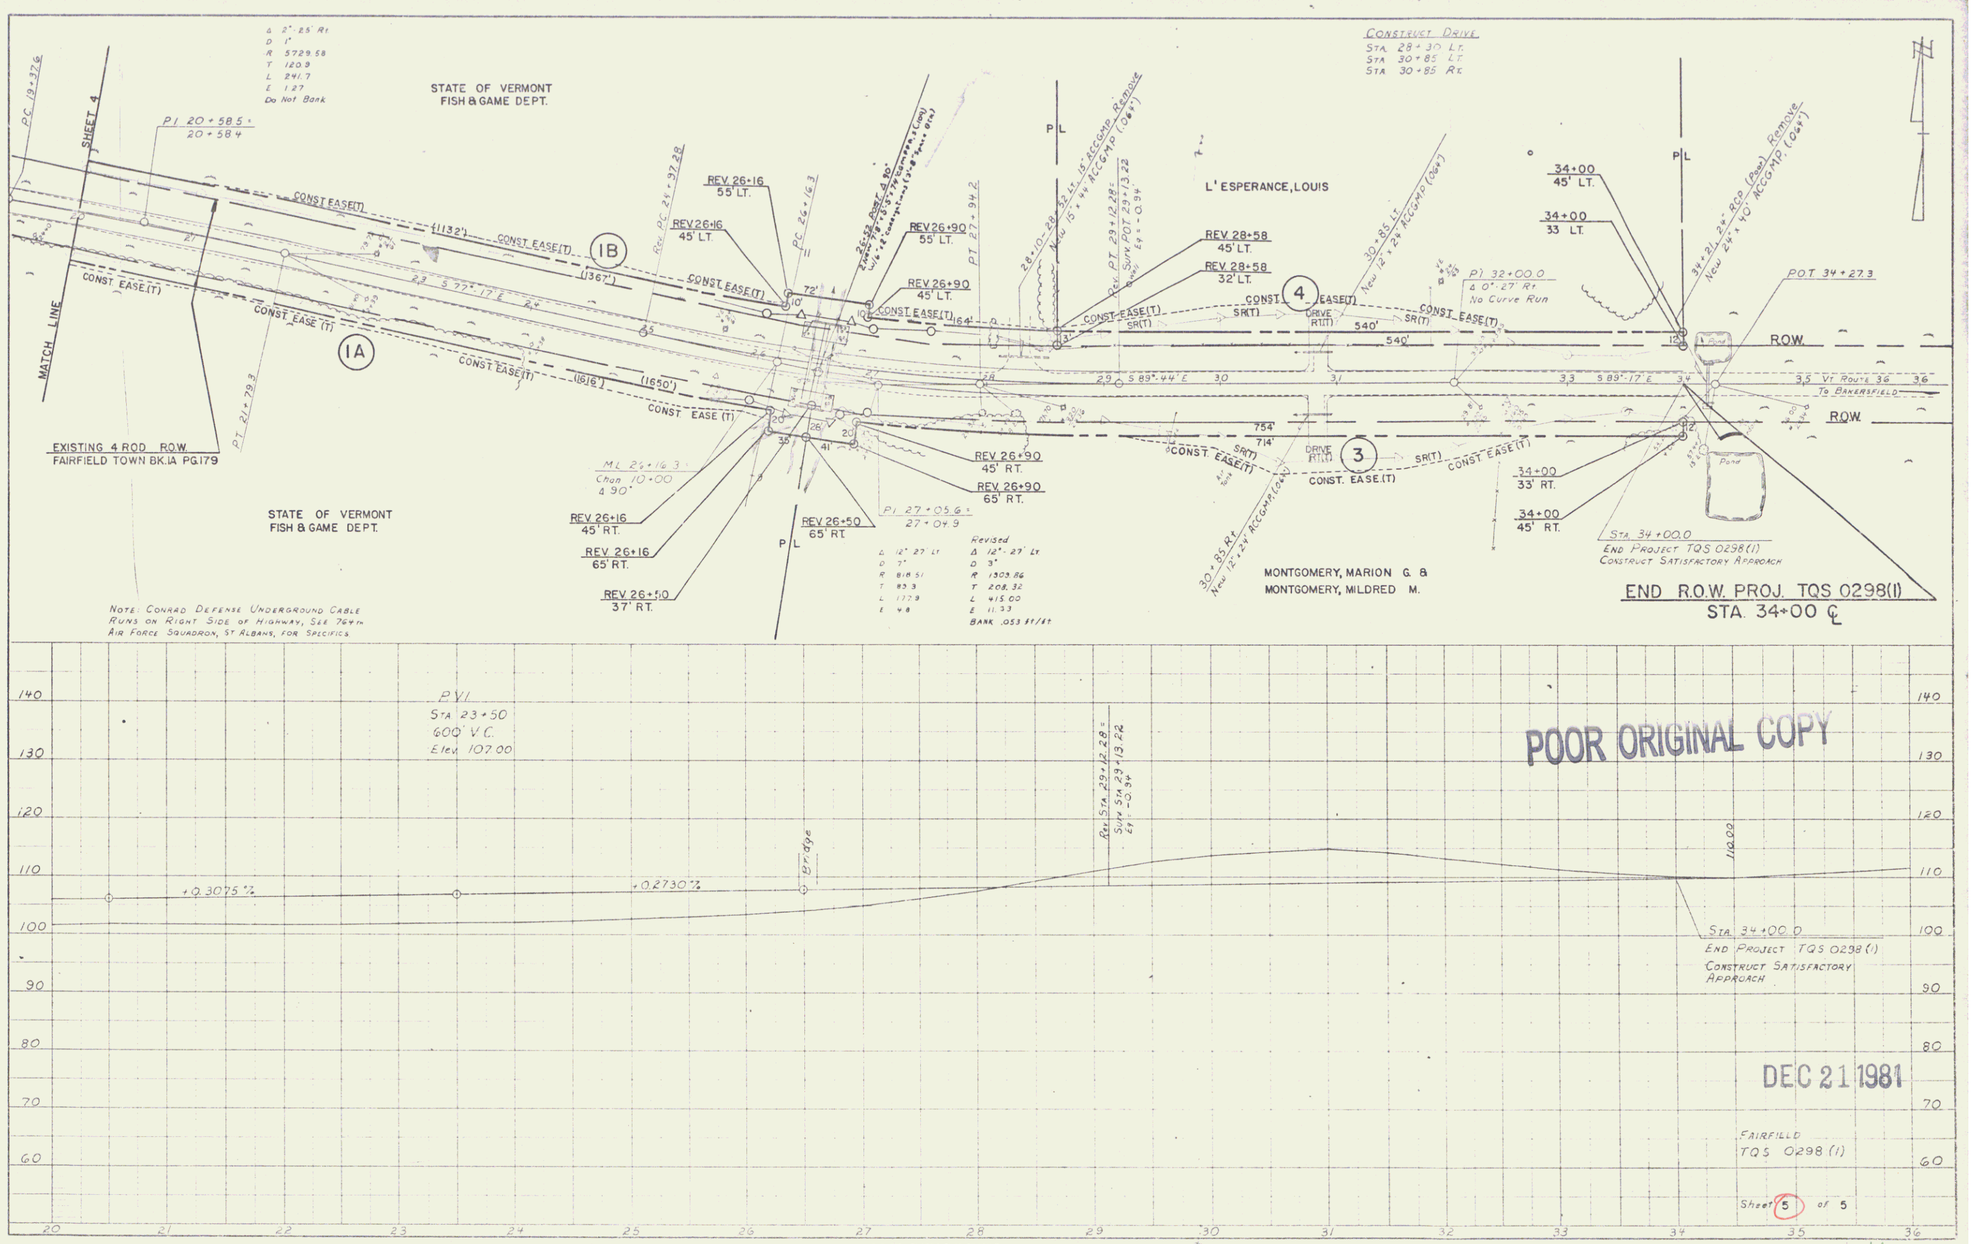

POOR ORIGINAL COPY

DEC 21 1981

FAIRFIELD
TQS 0298 (1)

Sheet 5 of 5

K+E PLATE 1. PLAN PROFILE KEUFFEL & ESSER CO.

4