



**POOR ORIGINAL COPY**

TOWN OF HANCOCK  



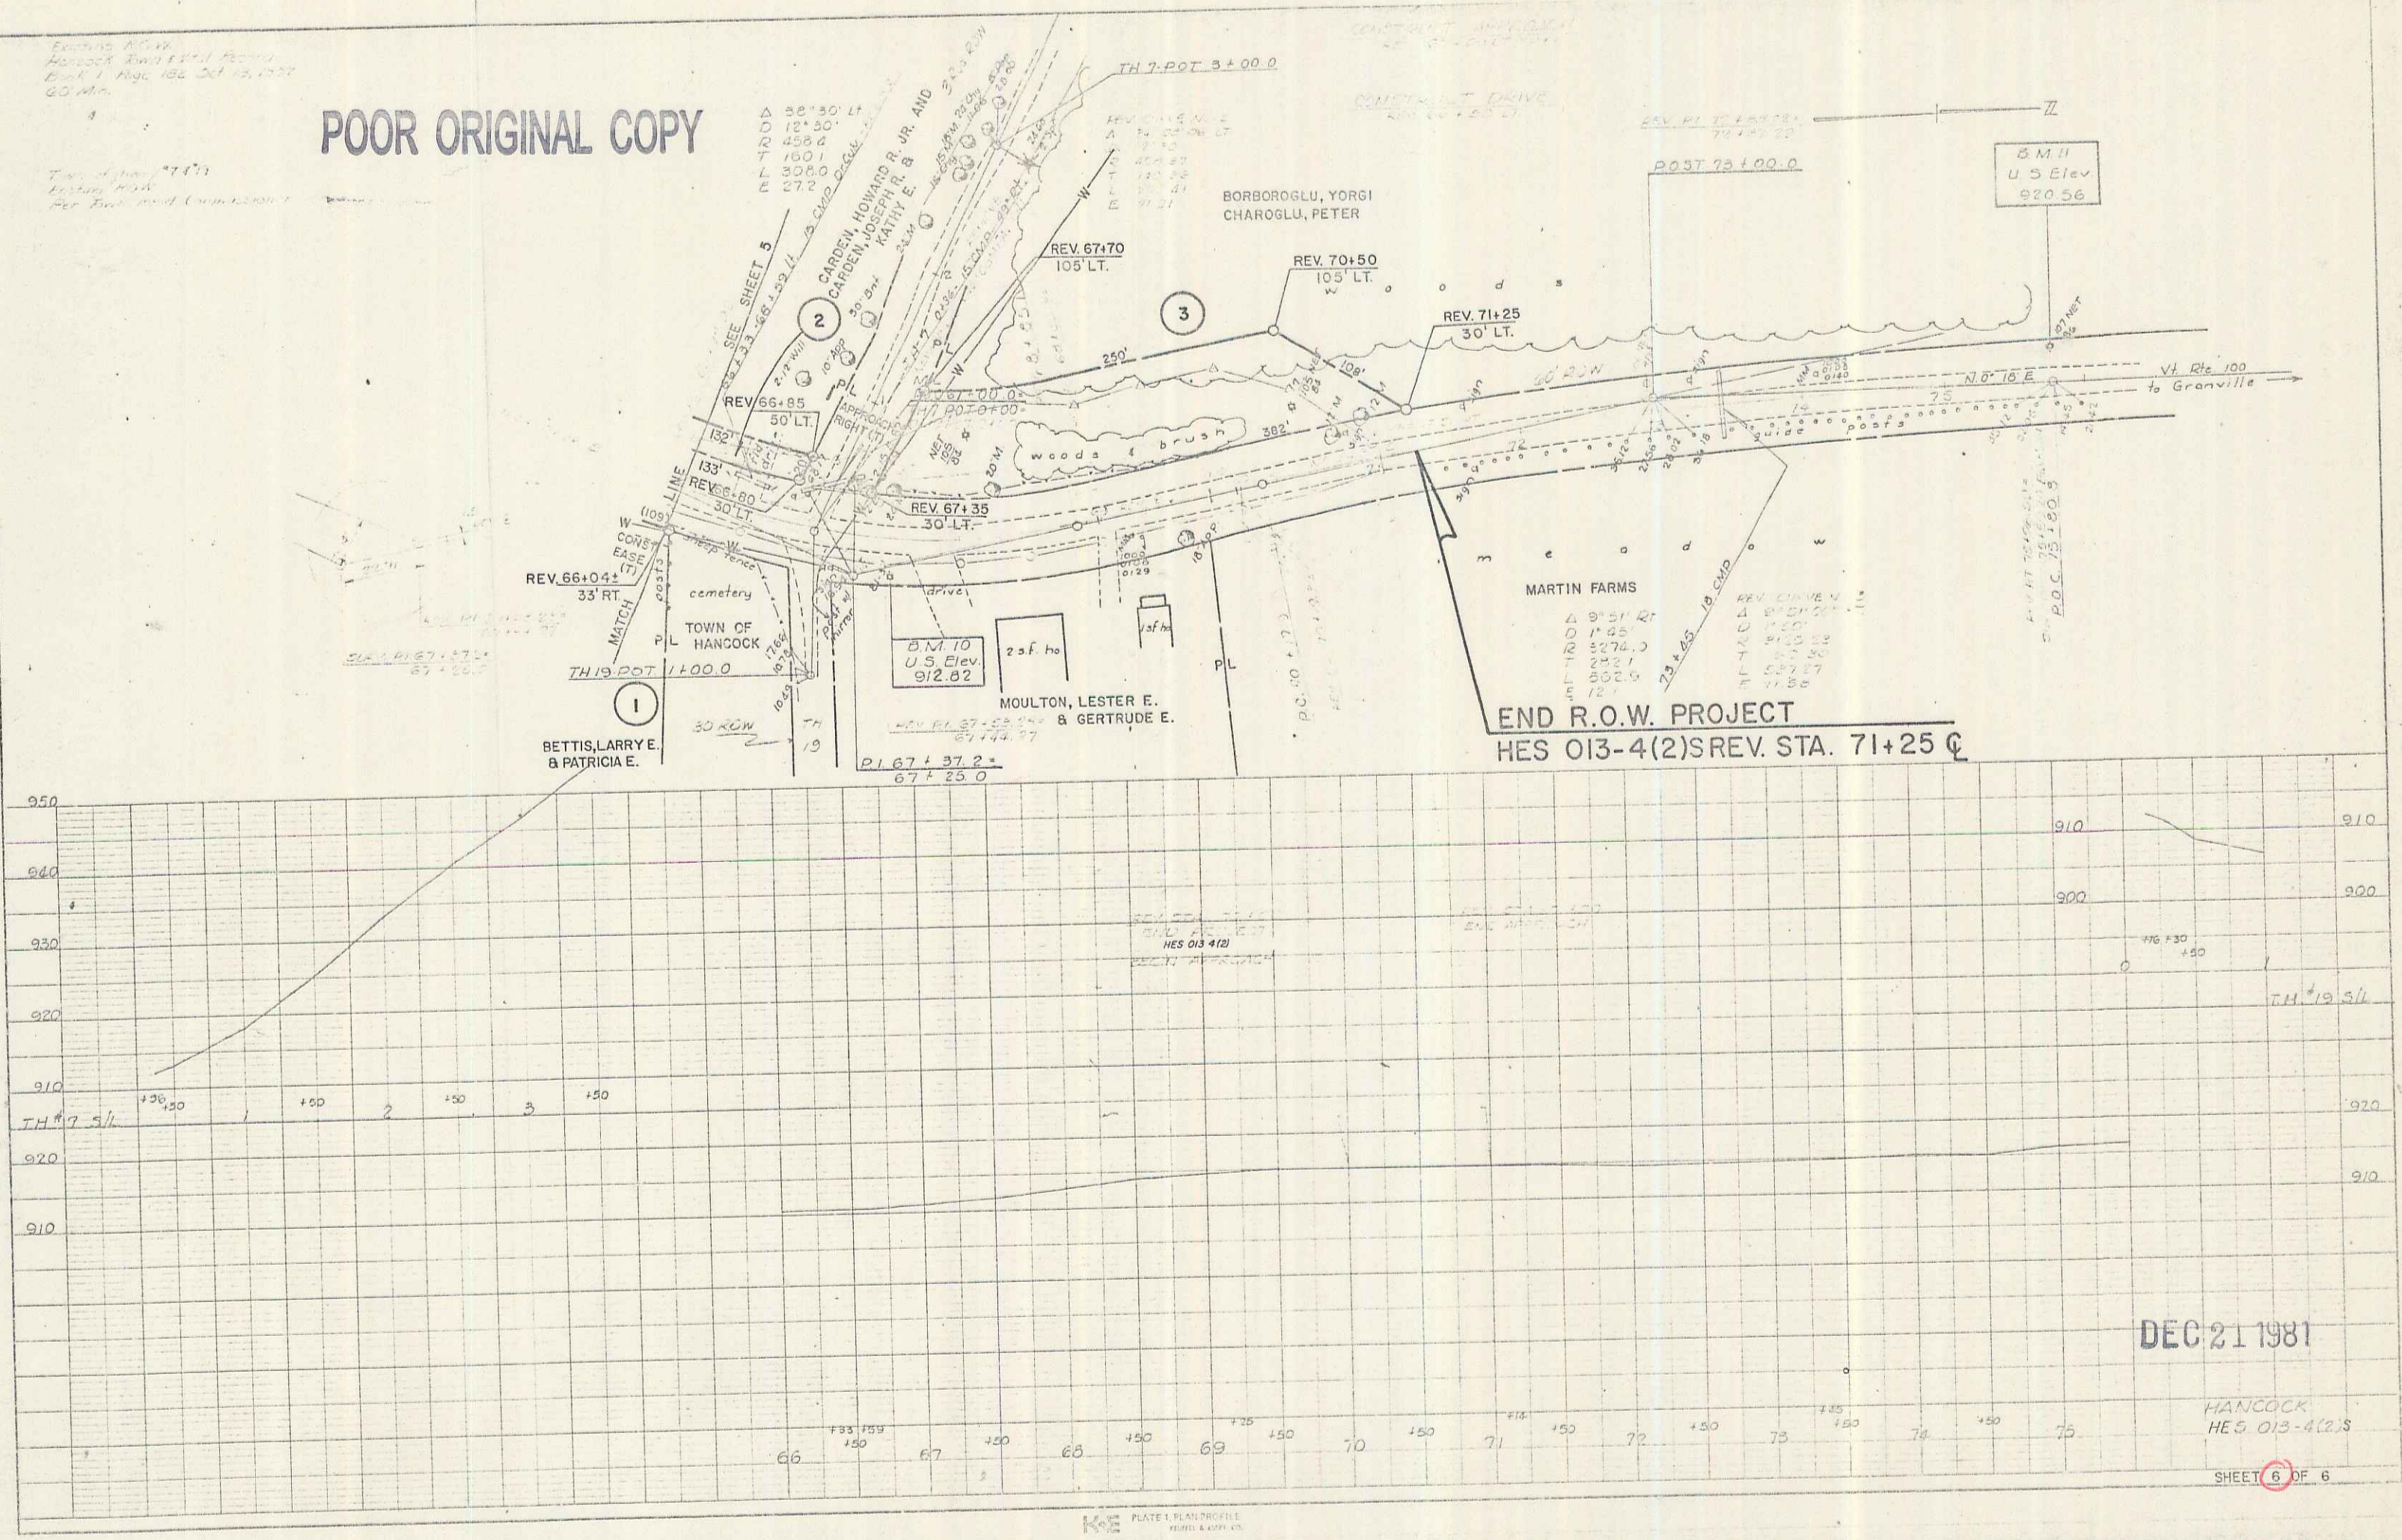

DEC 21 1981

HANCOCK  
HE 5 013-4(2)S

SHEET 6 OF 6

PLATE 1, PLAN PROFILE  
 43 7024 MADE IN U.S.A.

3