


PLAN
 SHEET NO. 5 OF 7

PROFILE
 SHEET NO. 5 OF 7

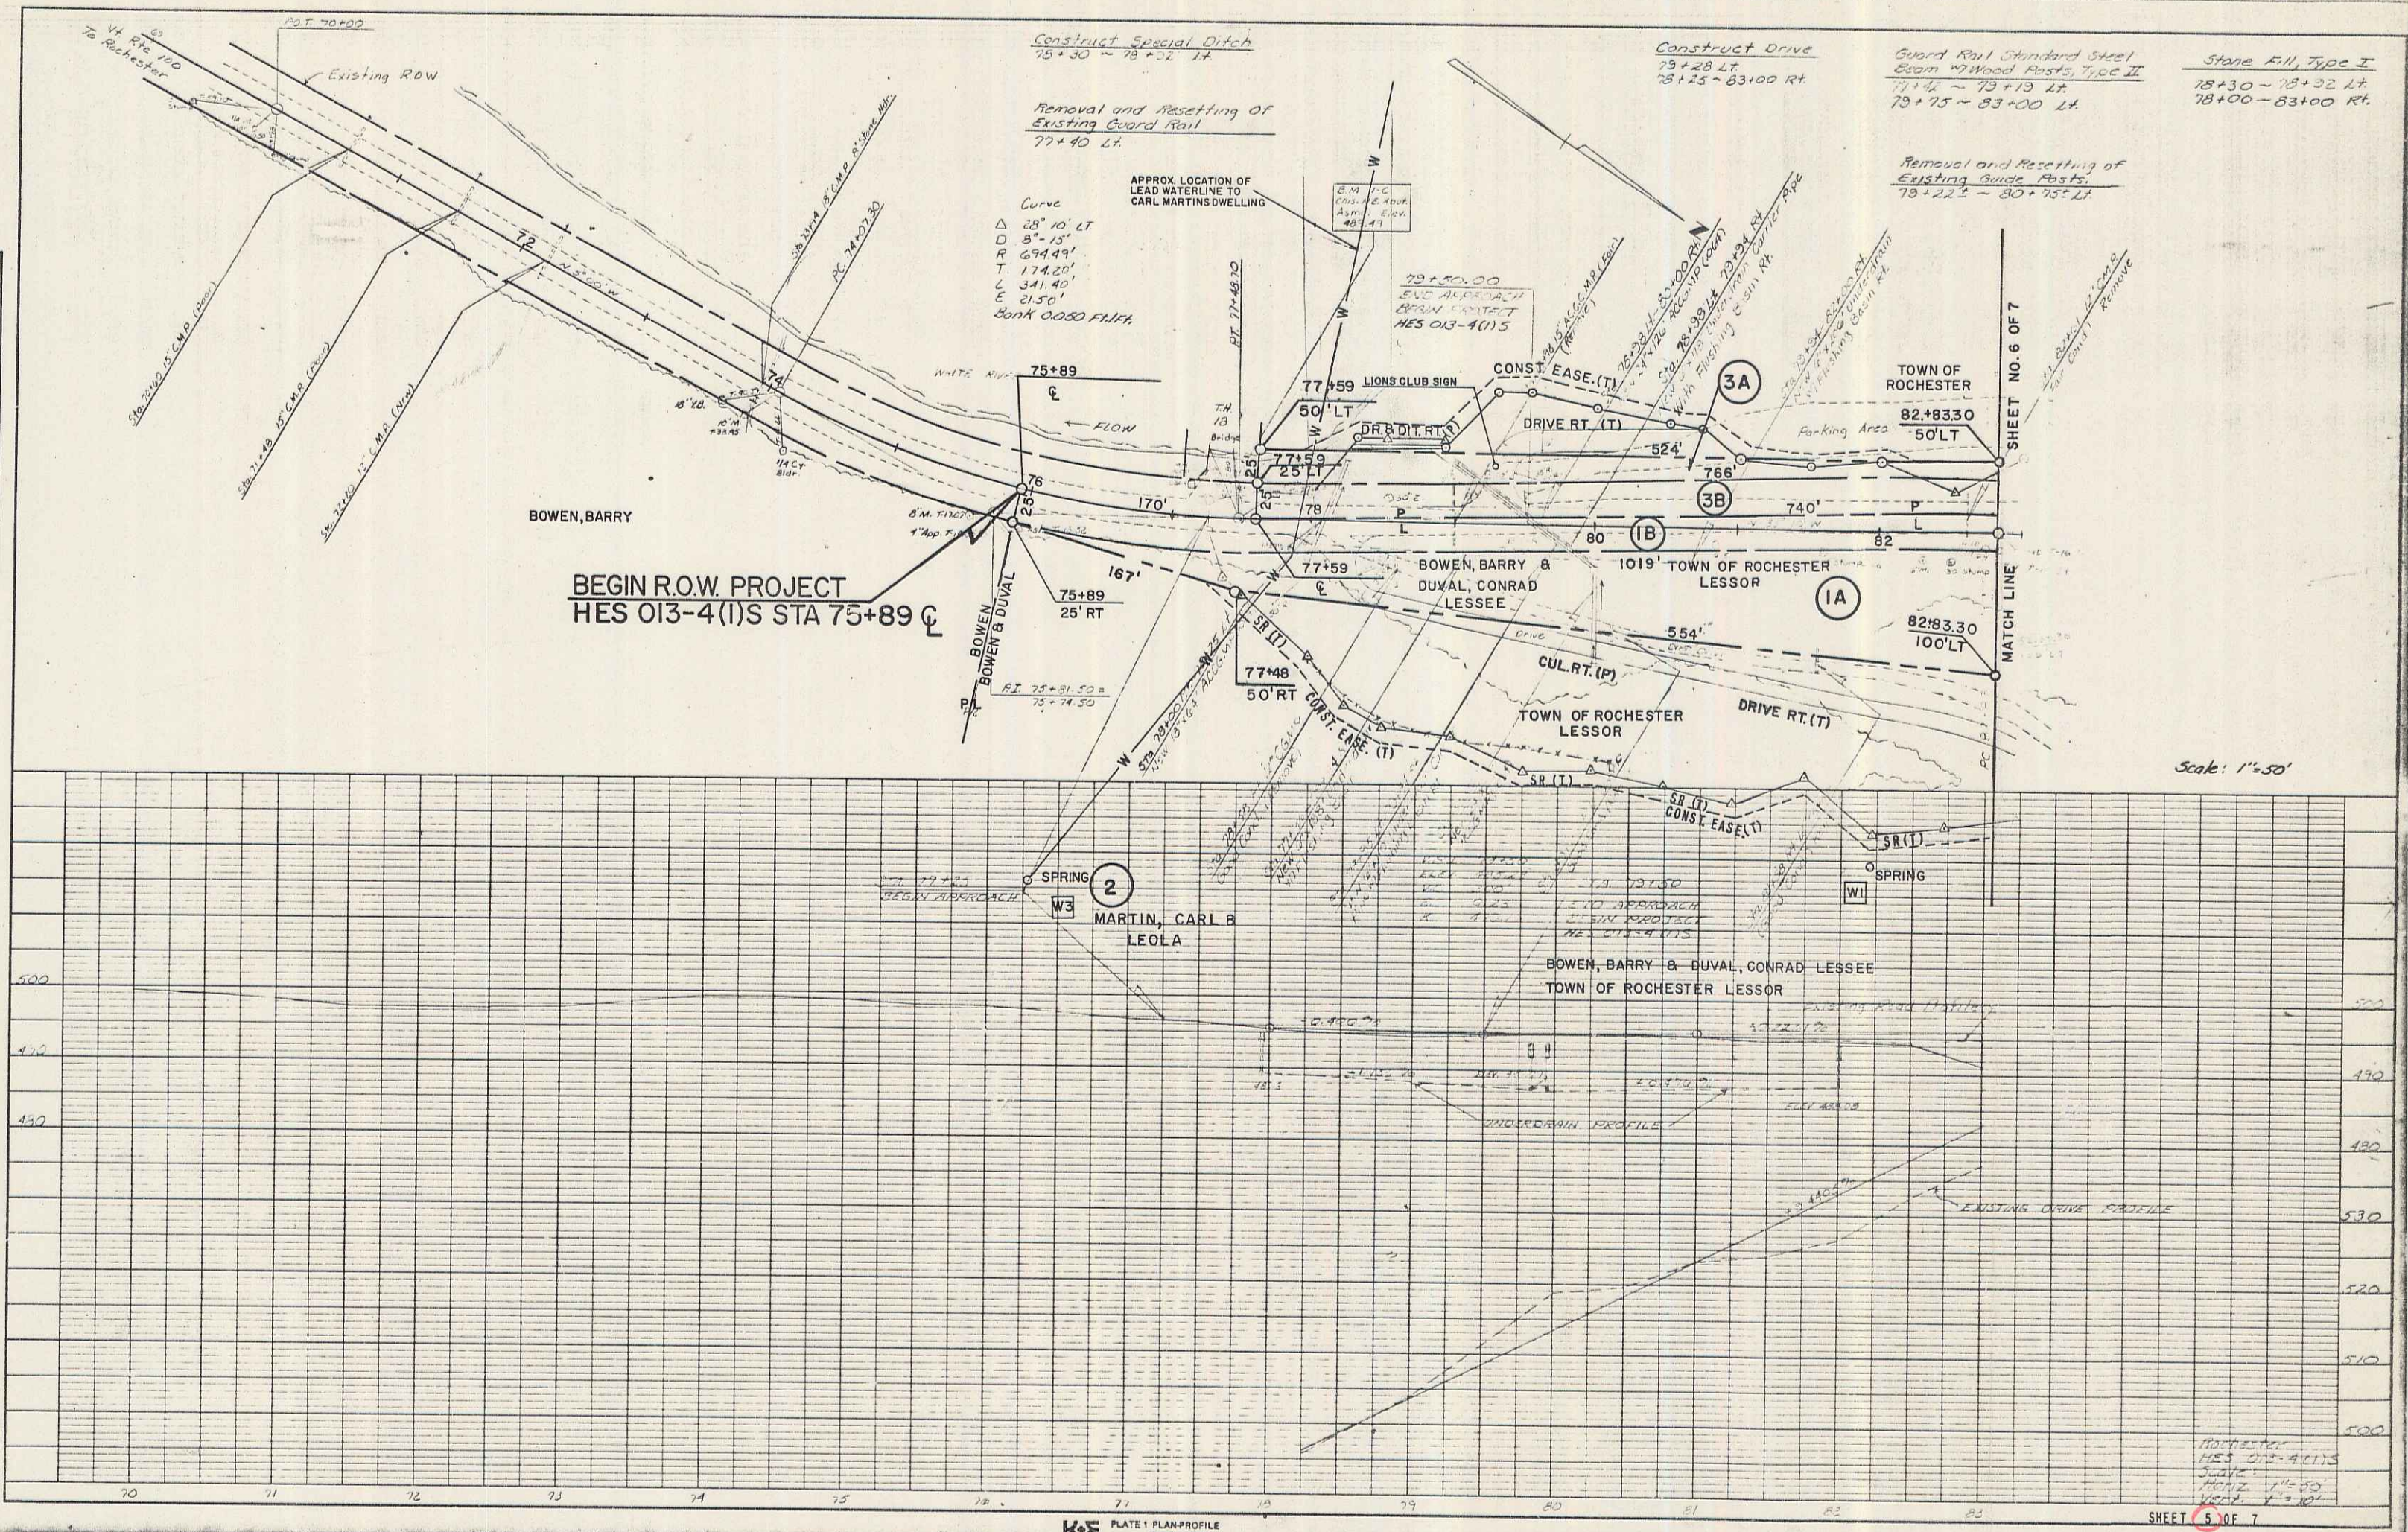

K&E PLATE 1 PLAN-PROFILE
 PRINTED BY [unclear]

SHEET 5 OF 7

2