POOR ORIGINAL COPY
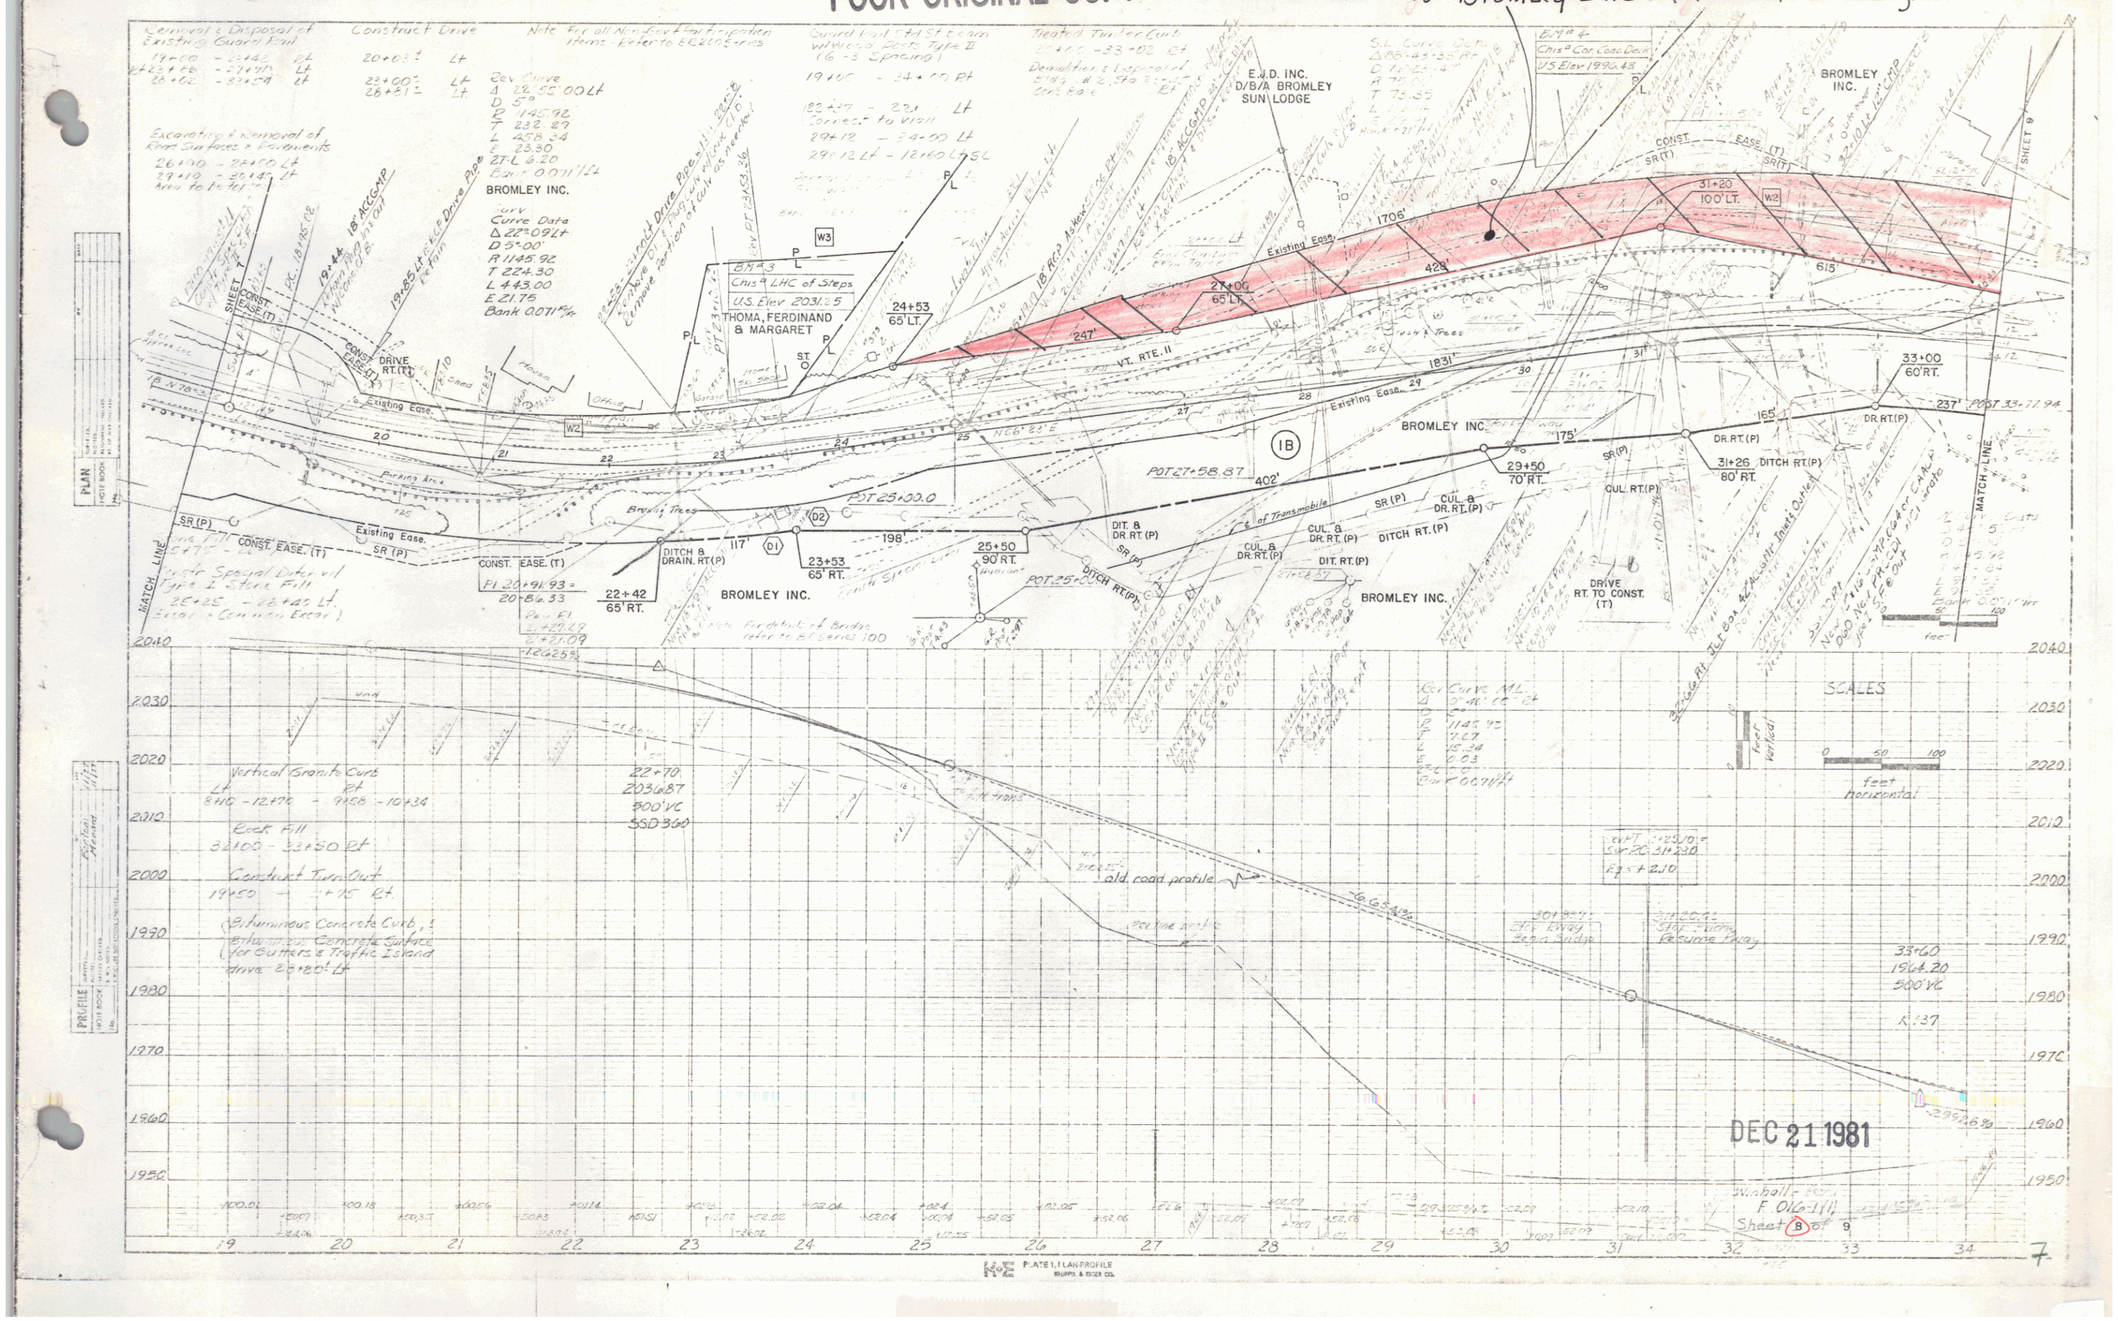
QCD to Bromley Inc dated 11/20/80 BK24Pg474