POOR ORIGINAL COPY

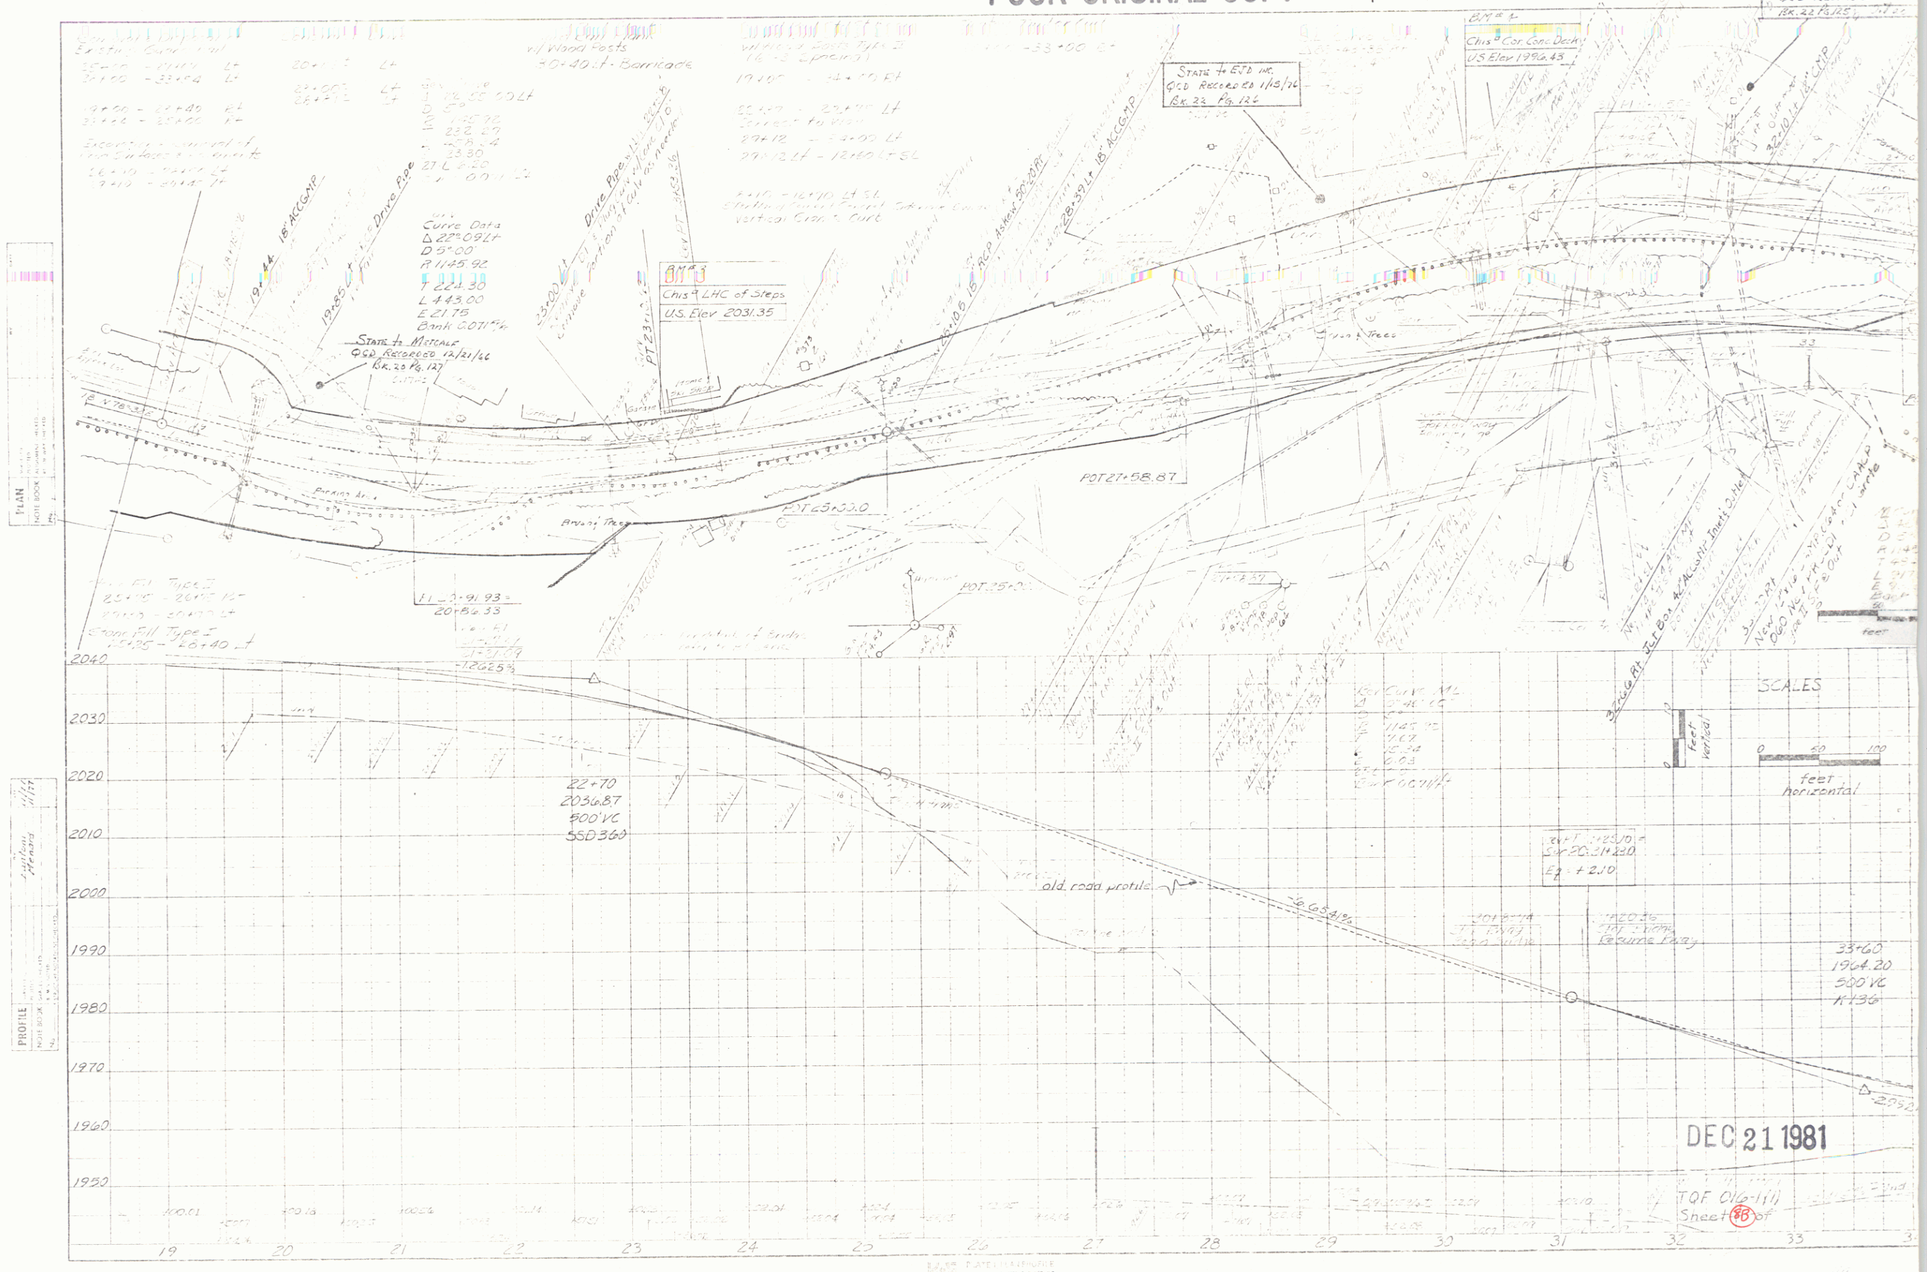

11