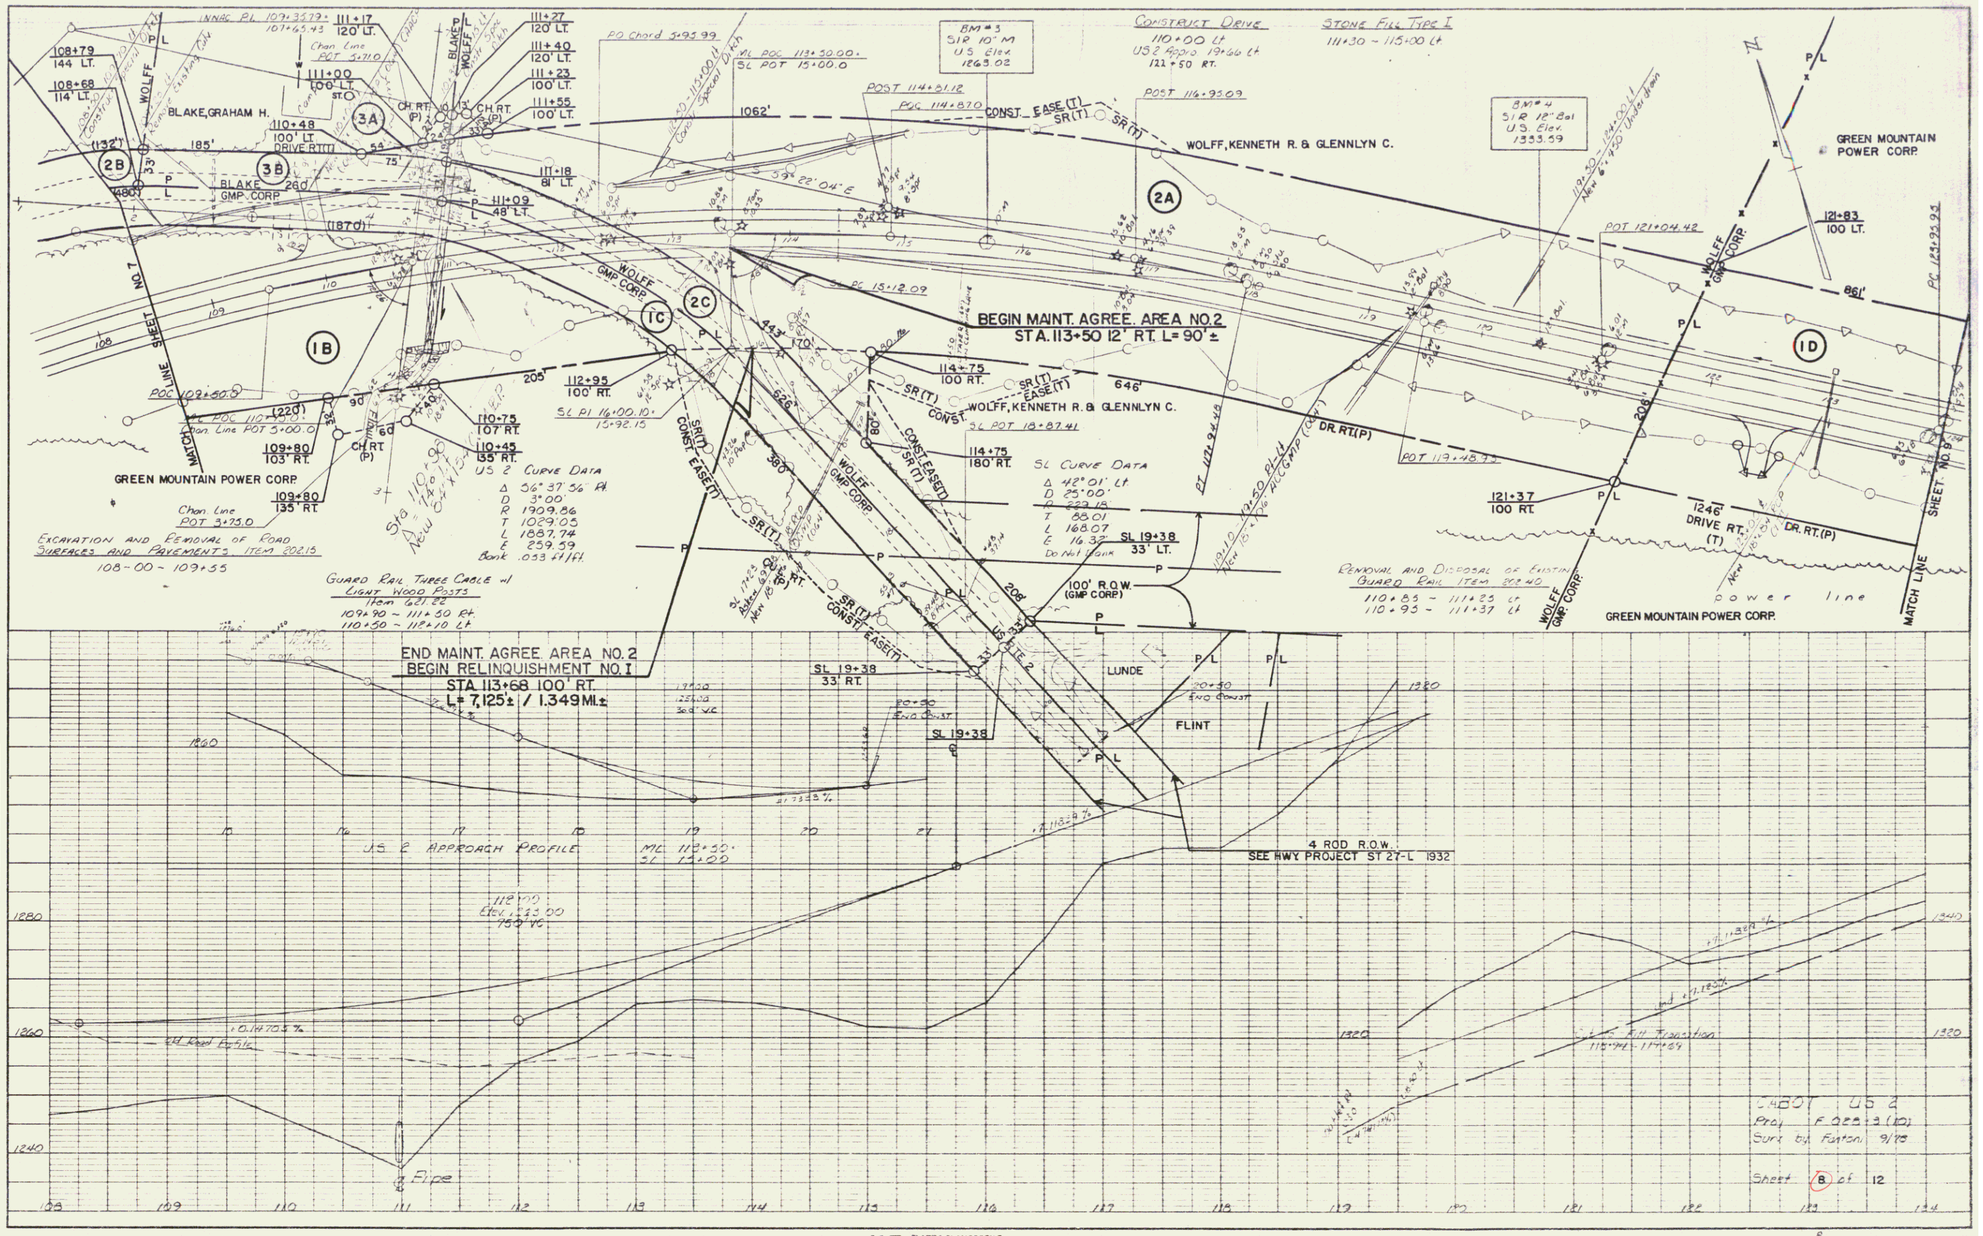

K+E PLATE 1, PLAN-PROFILE

8