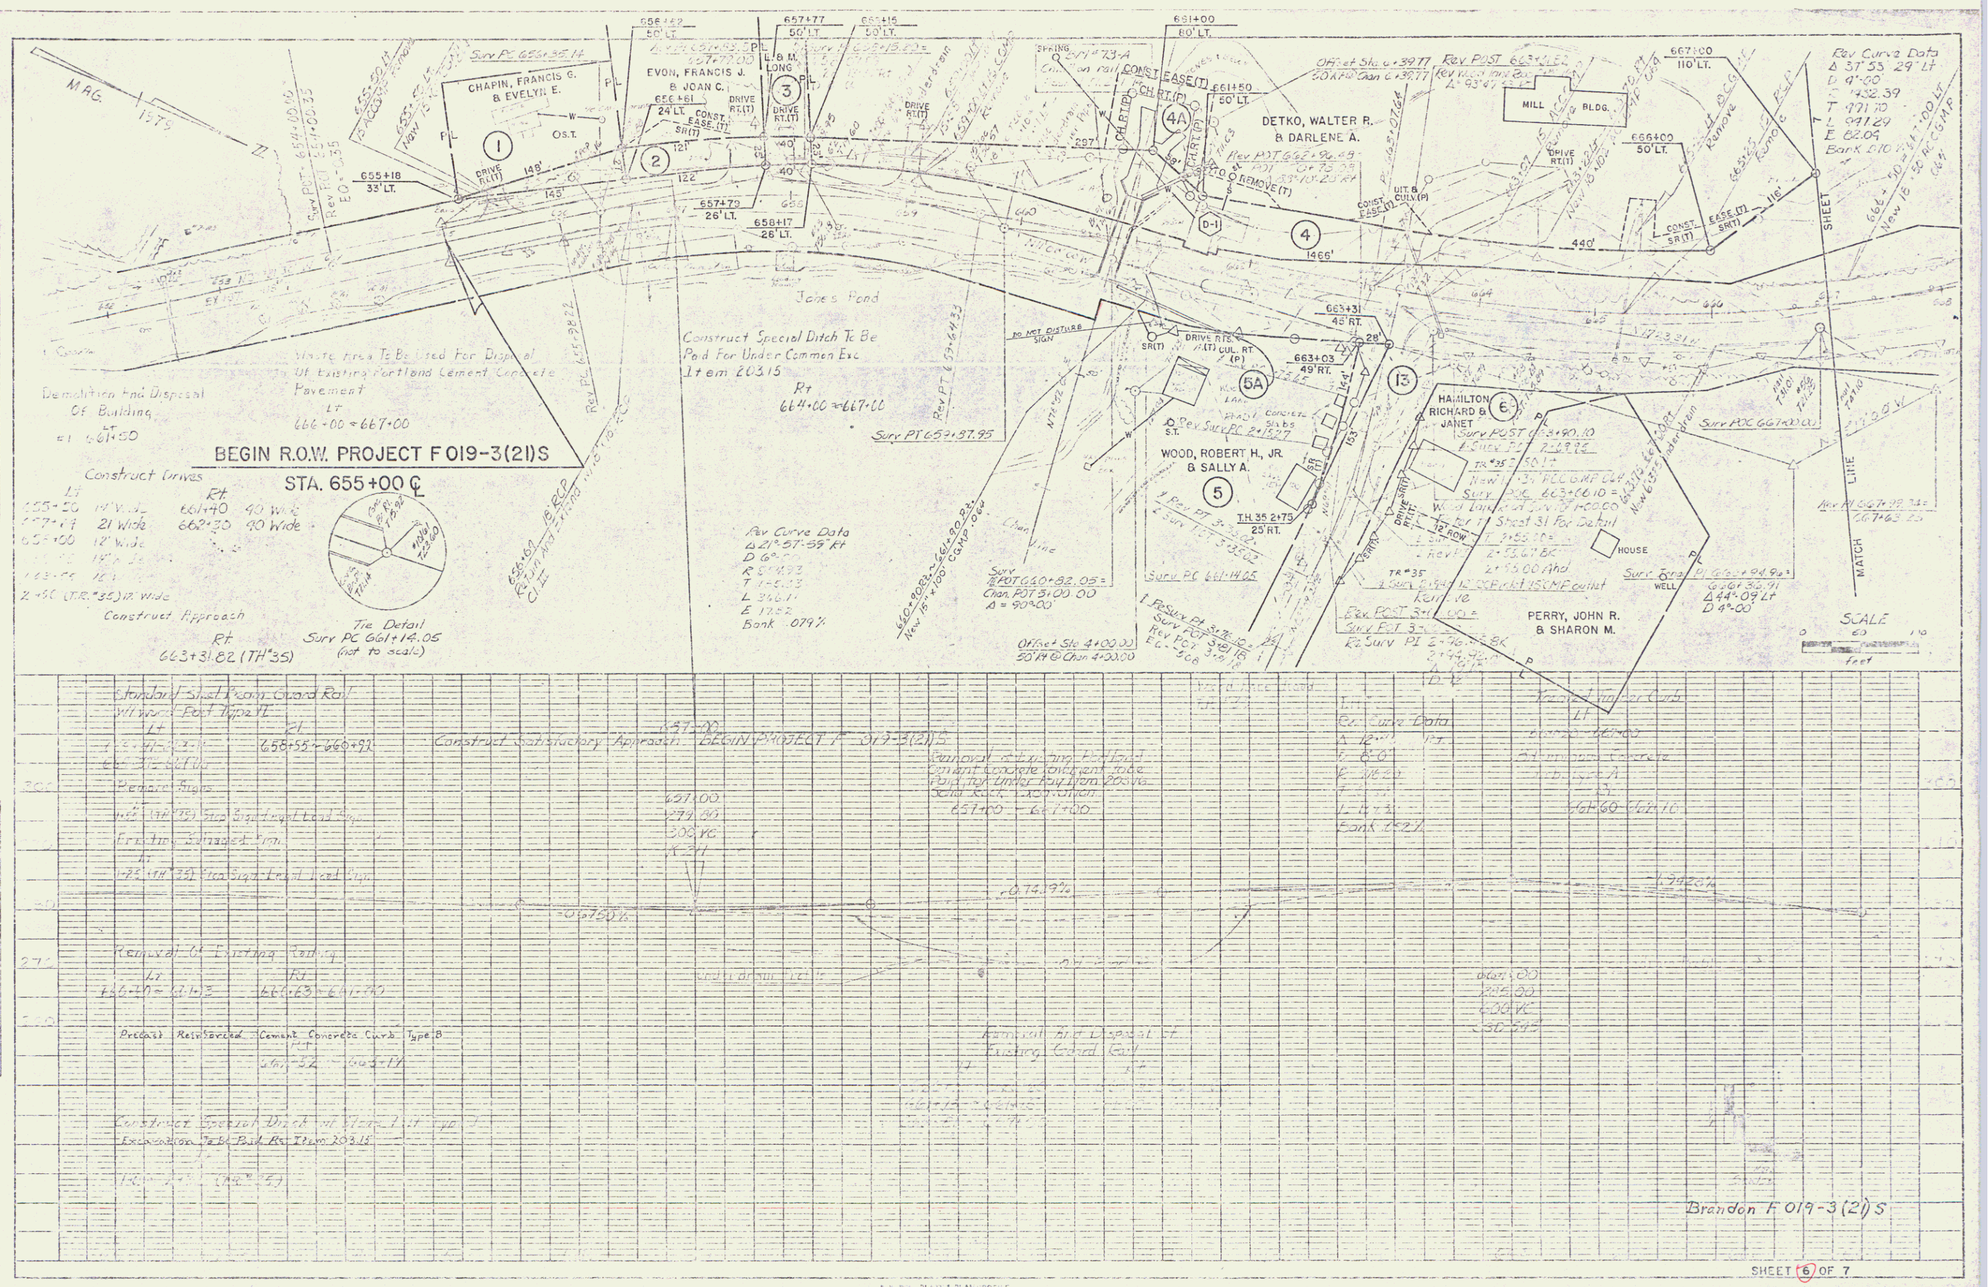
BEGIN R.O.W. PROJECT F 019-3(21)S
STA. 655+00 ℄
CHAPIN, FRANCIS G. & EVELYN E.
EVON, FRANCIS J. & JOAN C.
DETKO, WALTER R. & DARLENE A.
WOOD, ROBERT H. JR. & SALLY A.
HAMILTON RICHARD & JANET
PERRY, JOHN R. & SHARON M.
MILL BLDG.
HOUSE
WELL
Jakes Pond
Construct Special Ditch To Be Paid For Under Common Exc. Item 20315
Demolition And Disposal Of Building
Construct Drives
Construct Approach
Tie Detail Surv PC 661+14.05 (not to scale)
Rev Curve Data
Rev Curve Data
SCALE
SHEET
MATCH LINE
Construct Satisfactory Approach
BEGIN PROJECT F 019-3(21)S
Brandon F 019-3(21)S
SHEET 6 OF 7

2