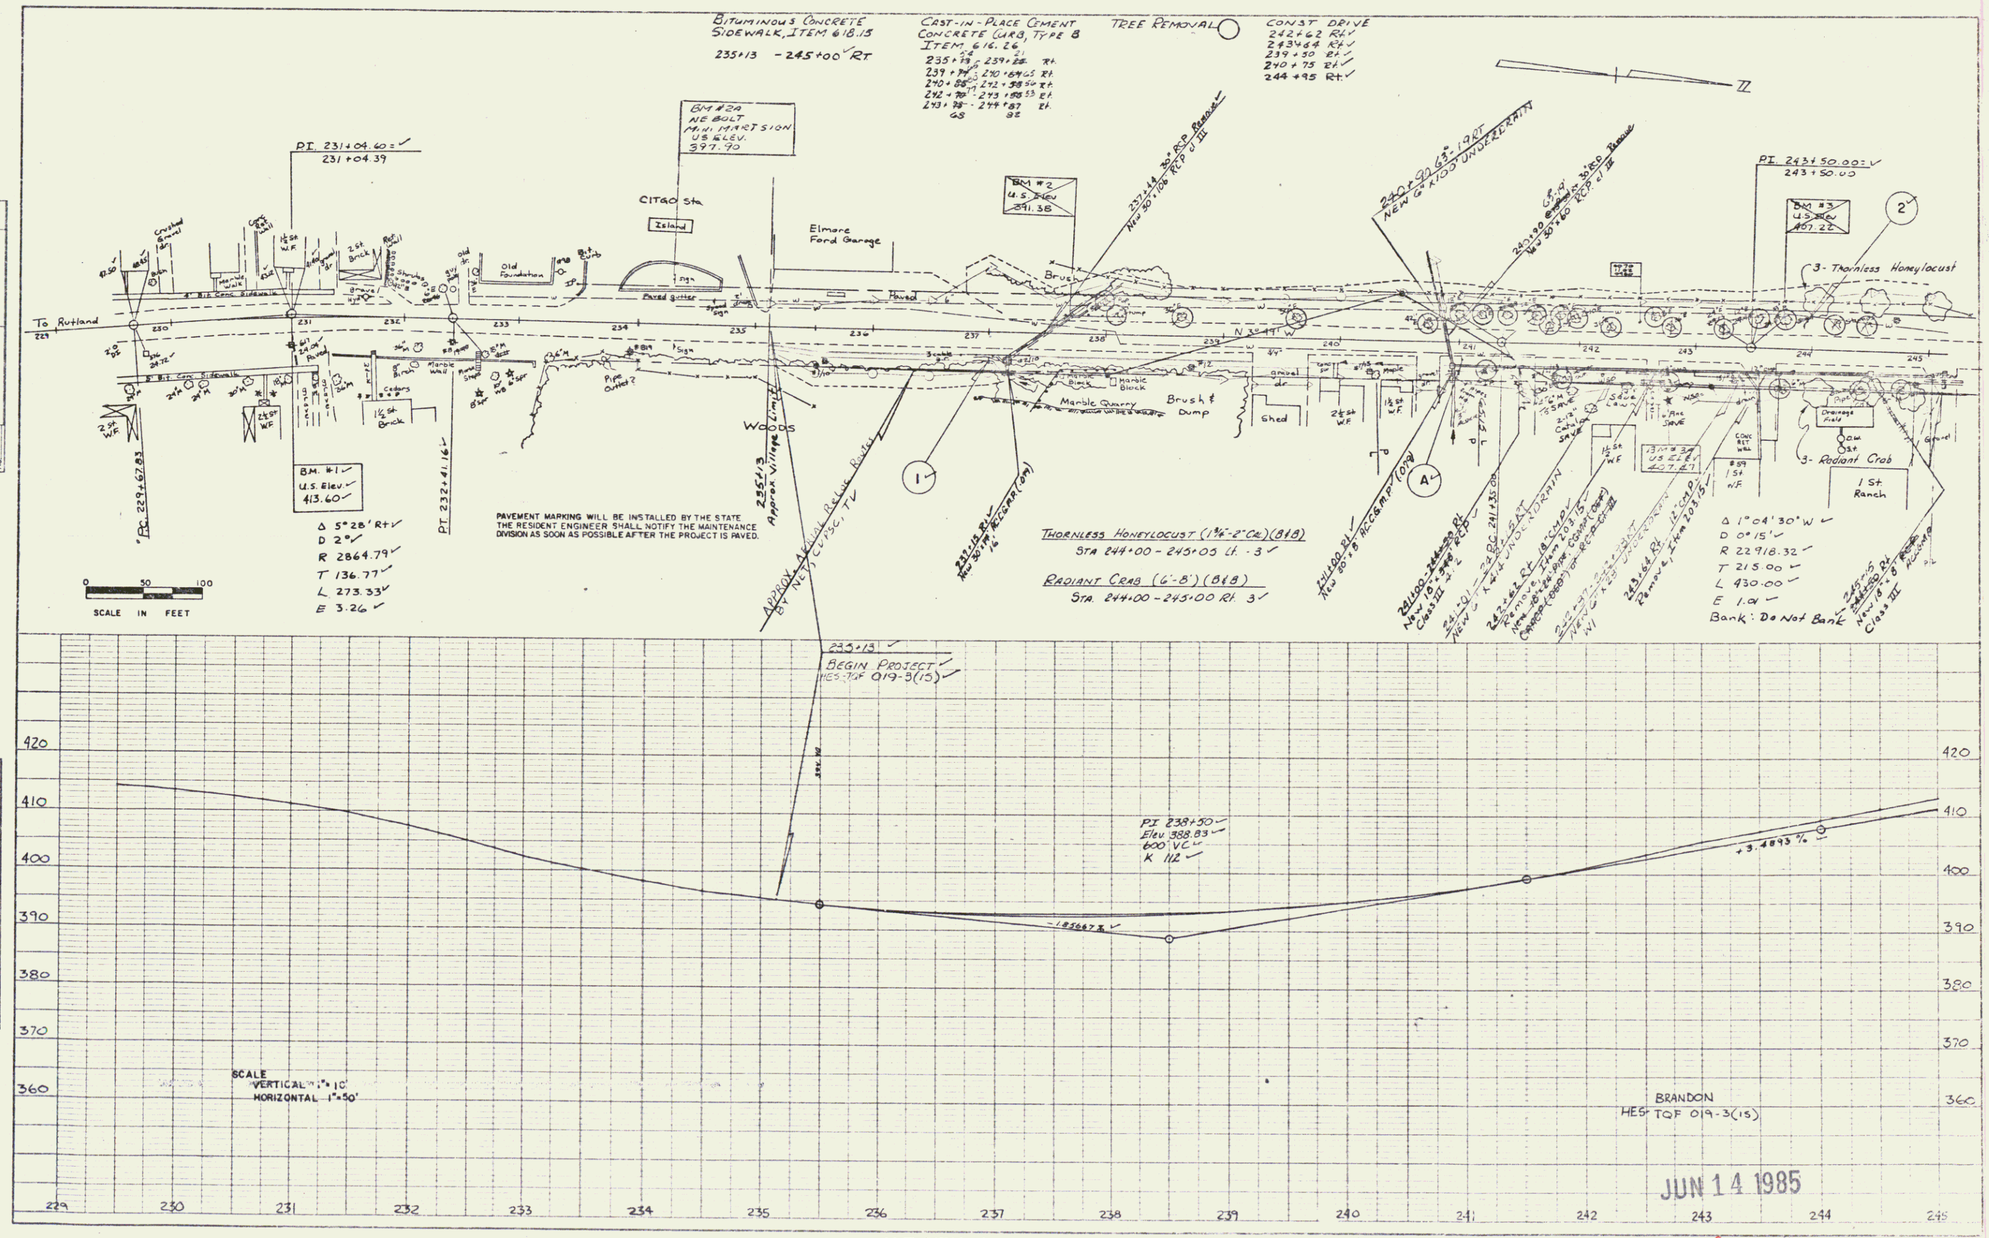
Bituminous Concrete Sidewalk, Item 618.15
235+13 - 245+00 Rt
Cast-in-Place Cement Concrete Curb, Type B
Item 616.26
Tree Removal
Const Drive
242+62 Rt
243+64 Rt
239+50 Rt
240+75 Rt
244+95 Rt
BM #24
NE Bolt
Mill Martsion
U.S. Elev.
397.70
BM #2
U.S. Elev
391.38
BM #3
U.S. Elev
407.22
PI 231+04.60
231+04.39
PI 243+50.00
243+50.00
CITGO Sta
Elmore Ford Garage
To Rutland
Old Foundation
Woods
Approx Village Limit
Brush & Dump
Marble Quarry
Shed
3- Thornless Honeylocust
3- Radiant Crab
1 St Ranch
BM #1
U.S. Elev.
413.60
PT 232+41.16
Pc 229+67.83
Δ 5°28' Rt
D 2°
R 2864.79
T 136.77
L 273.33
E 3.26
Δ 1°04' 30" W
D 0°15'
R 22918.32
T 215.00
L 430.00
E 1.01
Bank: Do Not Bank
PAVEMENT MARKING WILL BE INSTALLED BY THE STATE
THE RESIDENT ENGINEER SHALL NOTIFY THE MAINTENANCE DIVISION AS SOON AS POSSIBLE AFTER THE PROJECT IS PAVED.
Thornless Honeylocust (1½"-2" Cal) (B&B)
Sta 244+00 - 245+00 Lt. - 3
Radiant Crab (6'-8') (B&B)
Sta 244+00 - 245+00 Rt. 3
235+13
Begin Project
HES-TQF 019-3(15)
PI 238+50
Elev 388.83
600' VC
K 112
-1.83667 %
+3.4893 %
SCALE IN FEET
0 50 100
SCALE
VERTICAL 1" = 10'
HORIZONTAL 1" = 50'
BRANDON
HES TQF 019-3(15)
JUN 14 1985
Sheet 11 of 60
PLAN
PROFILE

6