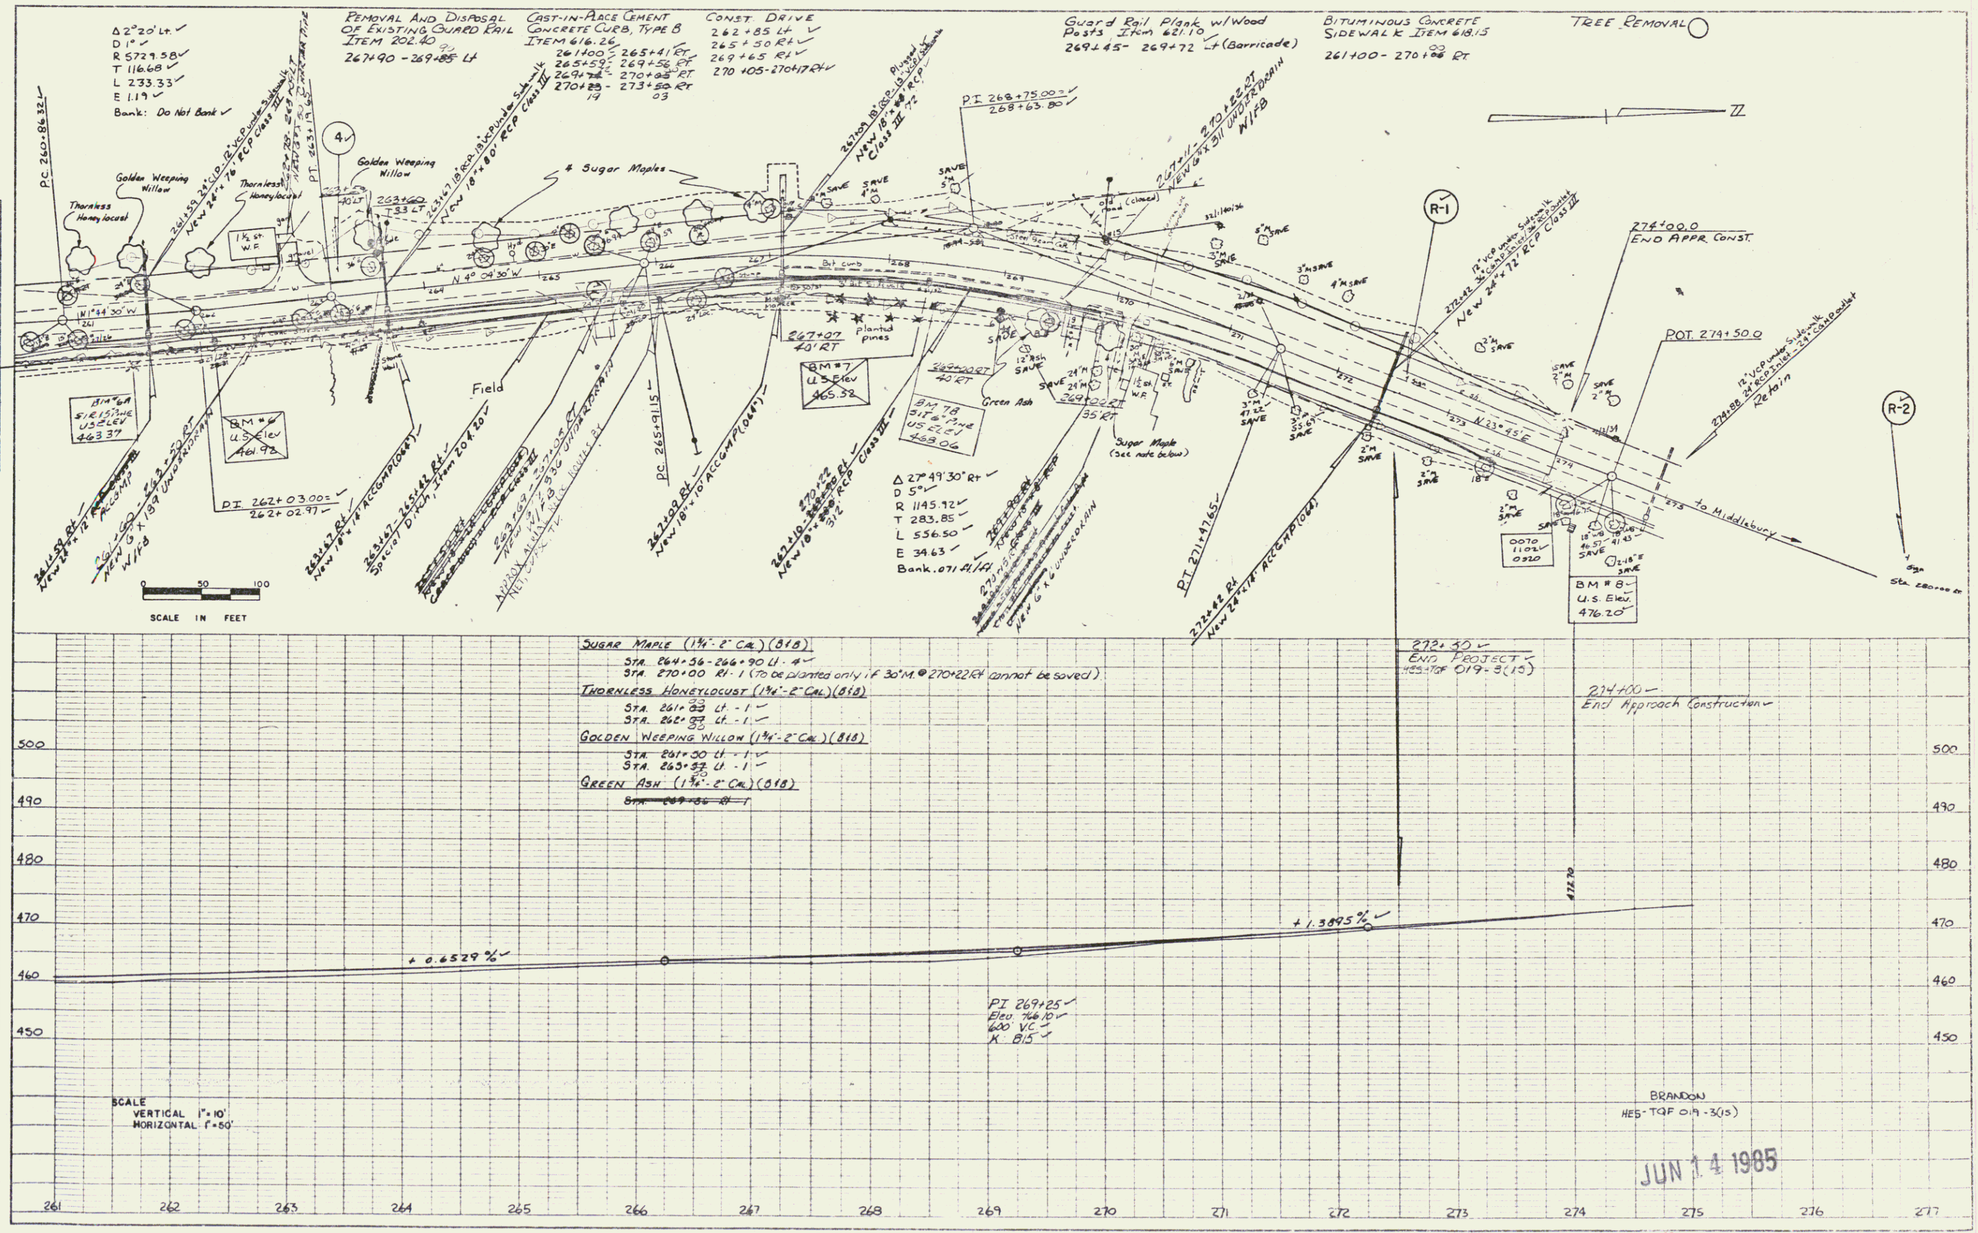

Sheet 13 of 68

9