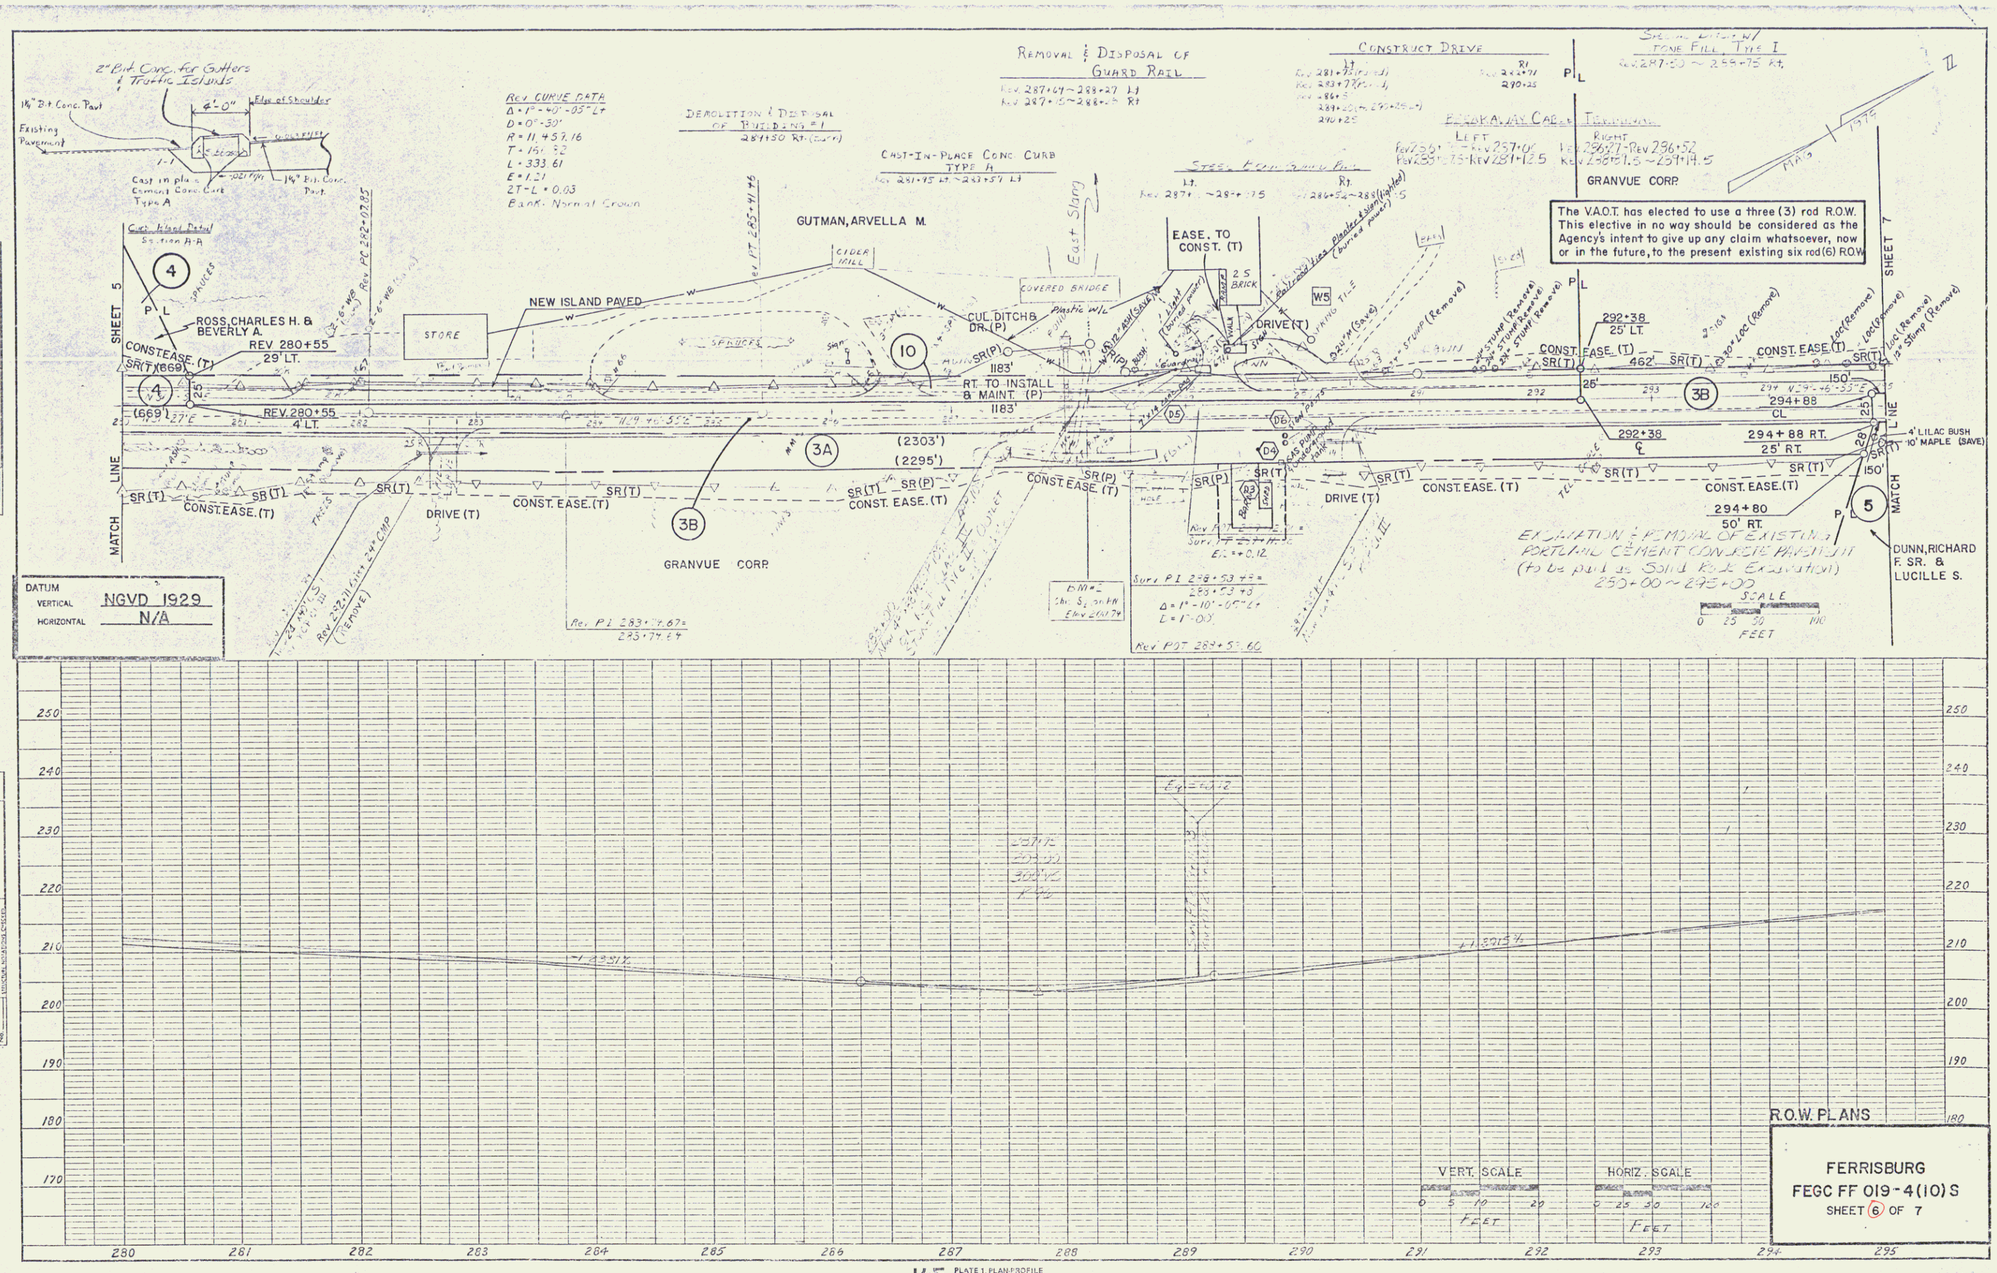

K+E PLATE 1, PLAN-PROFILE KEUFFEL & ESSER CO.

JUN 02 1992

6