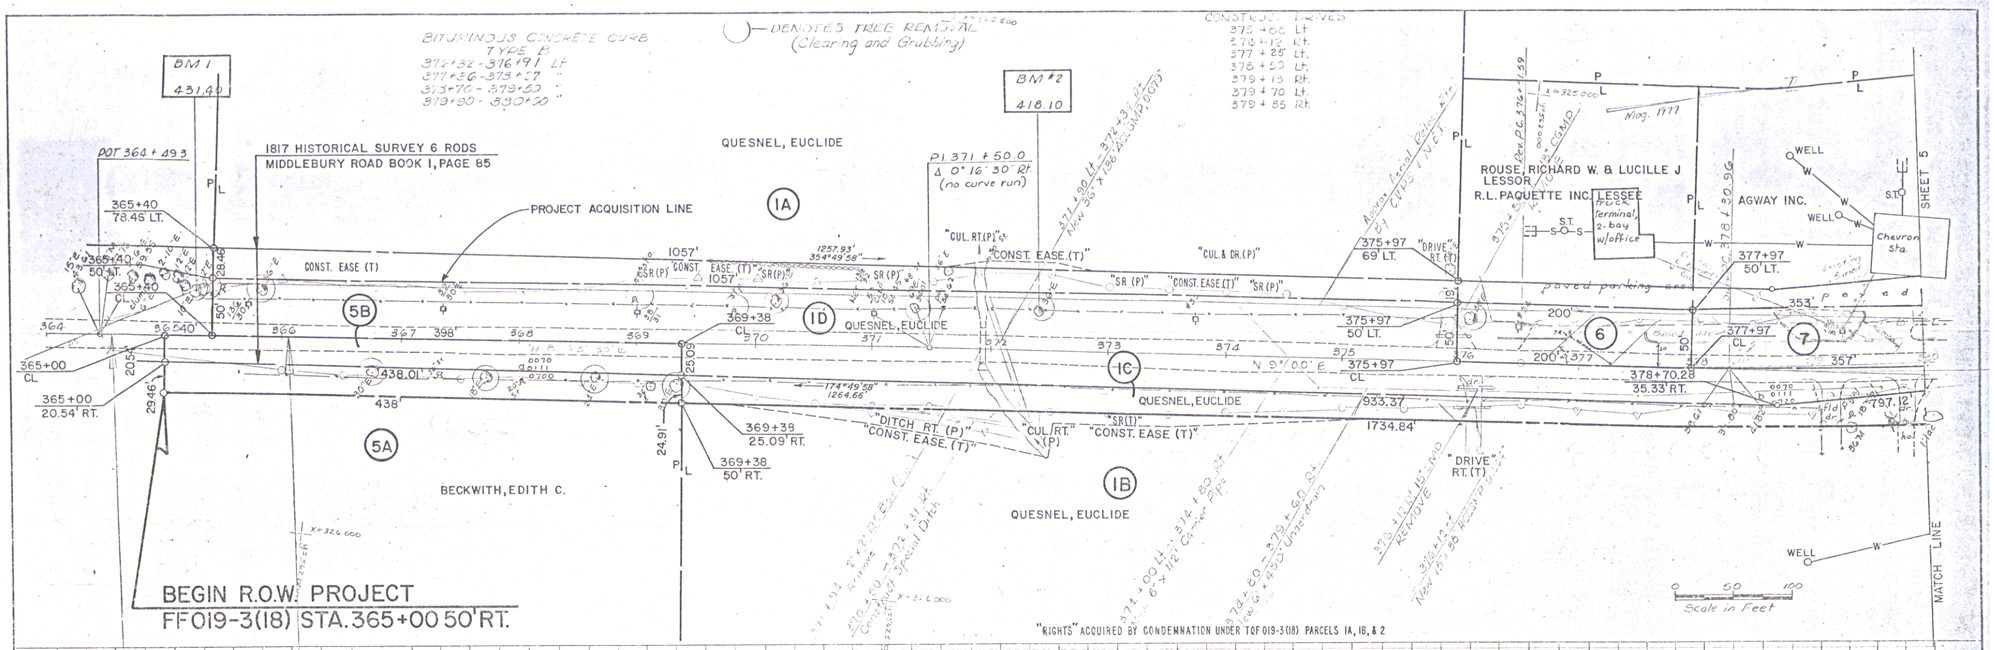
BITUMINOUS CONCRETE CURB TYPE B
DENOTES TREE REMOVAL (Clearing and Grubbing)
BM 1 431.40
BM #2 418.10
POT 364+493
1817 HISTORICAL SURVEY 6 RODS
MIDDLEBURY ROAD BOOK 1, PAGE 85
PROJECT ACQUISITION LINE
QUESNEL, EUCLIDE
PI 371+50.0
Δ 0°16'50" Rt.
(no curve run)
CONSTRUCT DRIVES
ROUSE, RICHARD W. & LUCILLE J
LESSOR
R.L. PAQUETTE INC. LESSEE
truck terminal, 2-bay w/office
AGWAY INC.
Chevron Sta.
BECKWITH, EDITH C.
BEGIN R.O.W. PROJECT
FF019-3(18) STA. 365+00 50' RT.
"RIGHTS" ACQUIRED BY CONDEMNATION UNDER TOF 019-3(18) PARCELS 1A, 1B, & 2
Scale in Feet
MATCH LINE
SHEET 5
END PROJECT FF 019-3(103) 1977
BEGIN PROJECT FF 019-3(18)
DATUM
HORIZONTAL NA
VERTICAL ASSUMED
MIDDLEBURY
FF 019-3(18)
Surv.-Gipson 1977
Plot-DeVaux 3/77
Traced-FFWG 3/77
SHEET 4 OF 5
PLATE 1, PLAN PROFILE

5