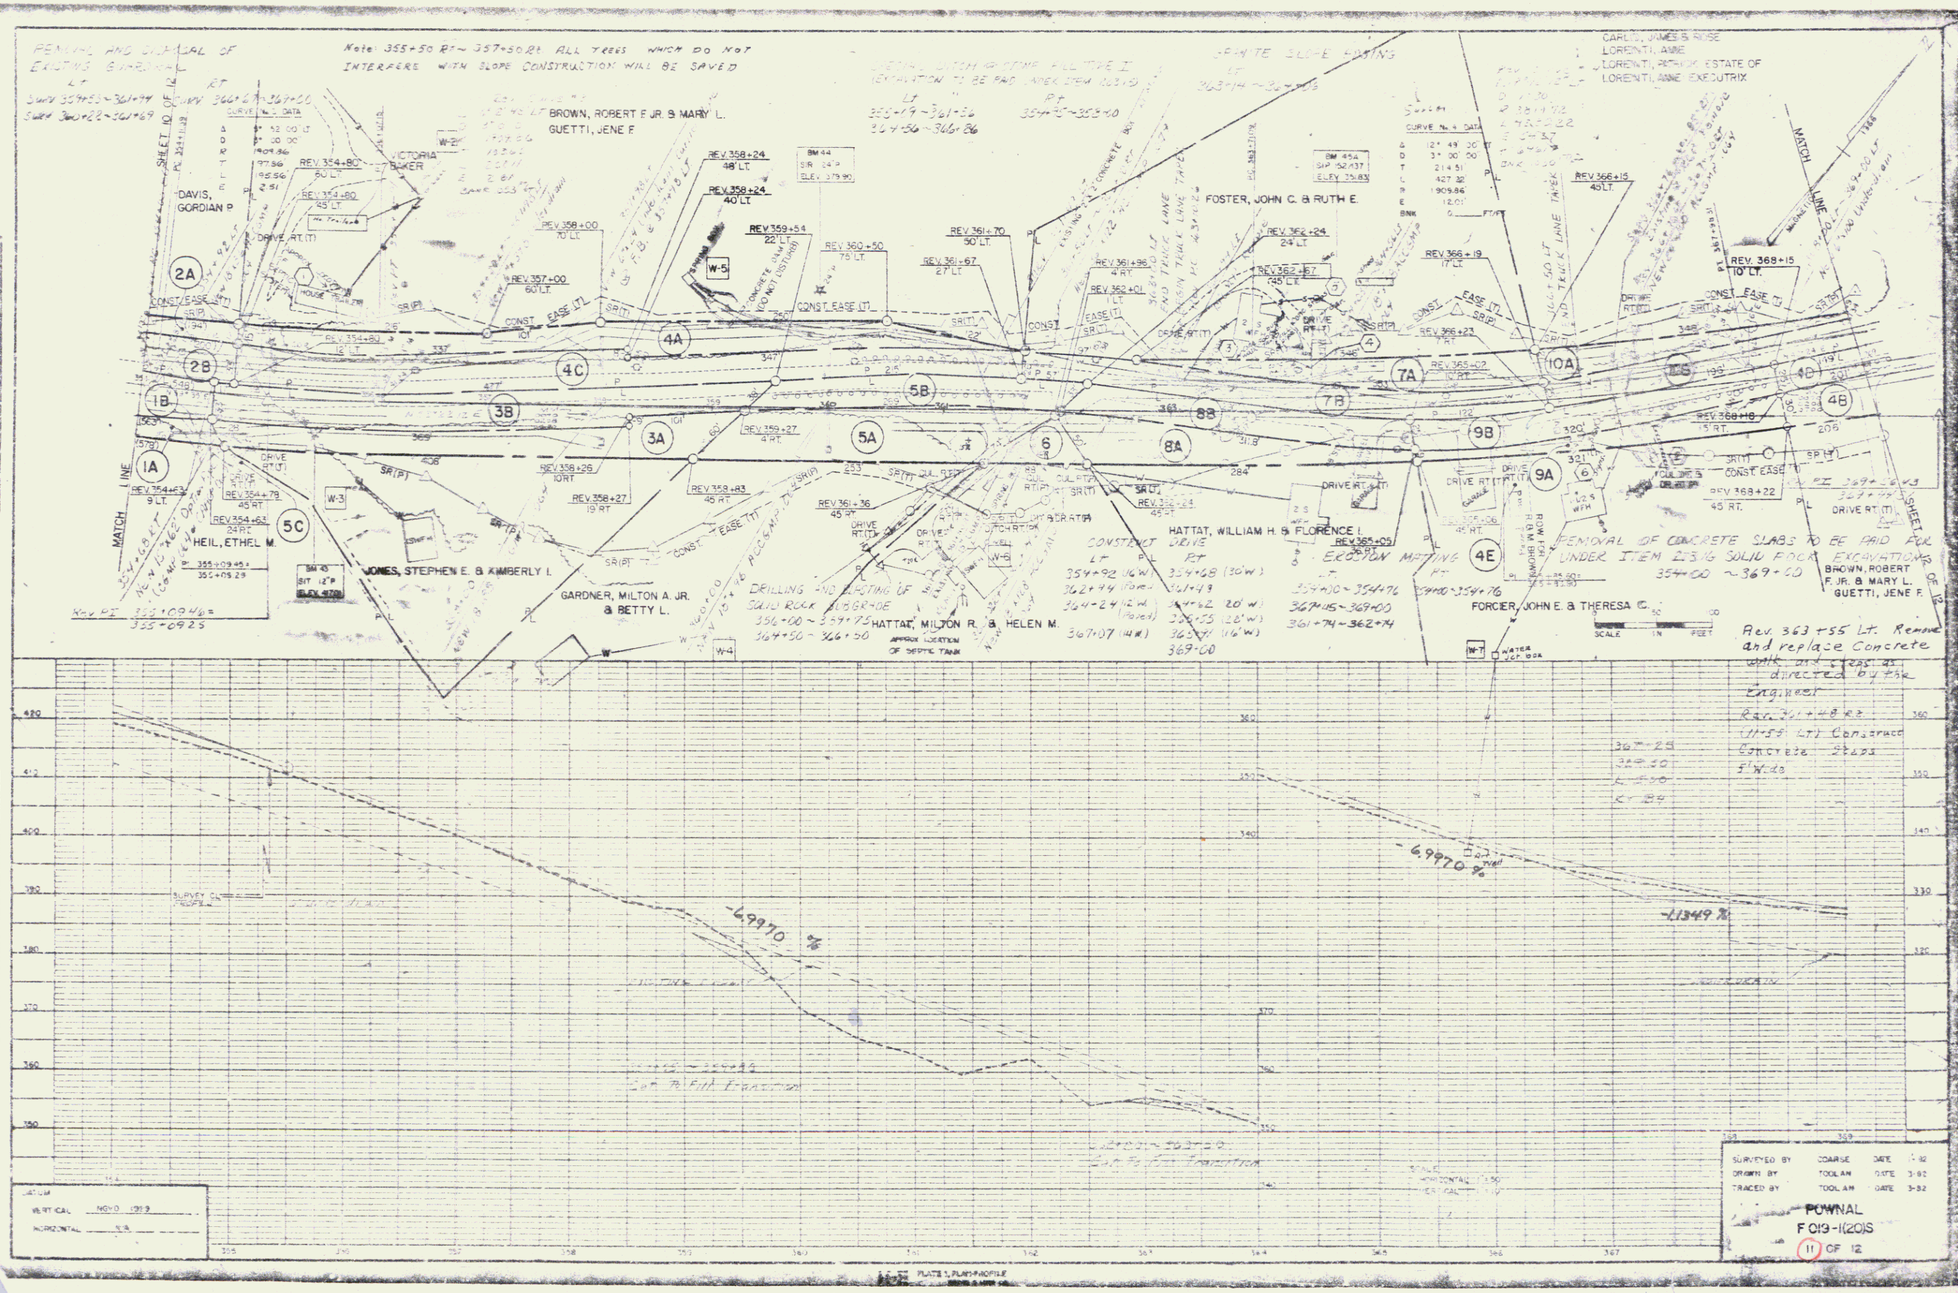
Note: 355+50 Rt ~ 357+50 Rt ALL TREES WHICH DO NOT INTERFERE WITH SLOPE CONSTRUCTION WILL BE SAVED
BROWN, ROBERT F JR. & MARY L.
GUETTI, JENE F
DAVIS, GORDIAN P
FOSTER, JOHN C. & RUTH E.
CARLOS, JAMES & ROSE
LORENTI, ANNE
LORENTI, PATRICK ESTATE OF
LORENTI, ANNE EXECUTRIX
HEIL, ETHEL M.
JONES, STEPHEN E. & KIMBERLY I.
GARDNER, MILTON A. JR. & BETTY L.
HATTAT, MILTON R. & HELEN M.
HATTAT, WILLIAM H. & FLORENCE I.
FORCIER, JOHN E. & THERESA C.
BROWN, ROBERT F. JR. & MARY L.
GUETTI, JENE F.
REMOVAL OF CONCRETE SLABS TO BE PAID FOR UNDER ITEM 213.16 SOLID ROCK EXCAVATION
Rev. 363+55 Lt. Remove and replace Concrete walk and steps as directed by the Engineer
Rev. 361+48 Rt (11+55 Lt) Construct Concrete Steps
-6.9970 %
-1.1349 %
SURVEYED BY COARSE DATE
DRAWN BY TOOLAM DATE 3-82
TRACED BY TOOLAM DATE 3-82
POWNAL
F 019-1(20)S
11 OF 12