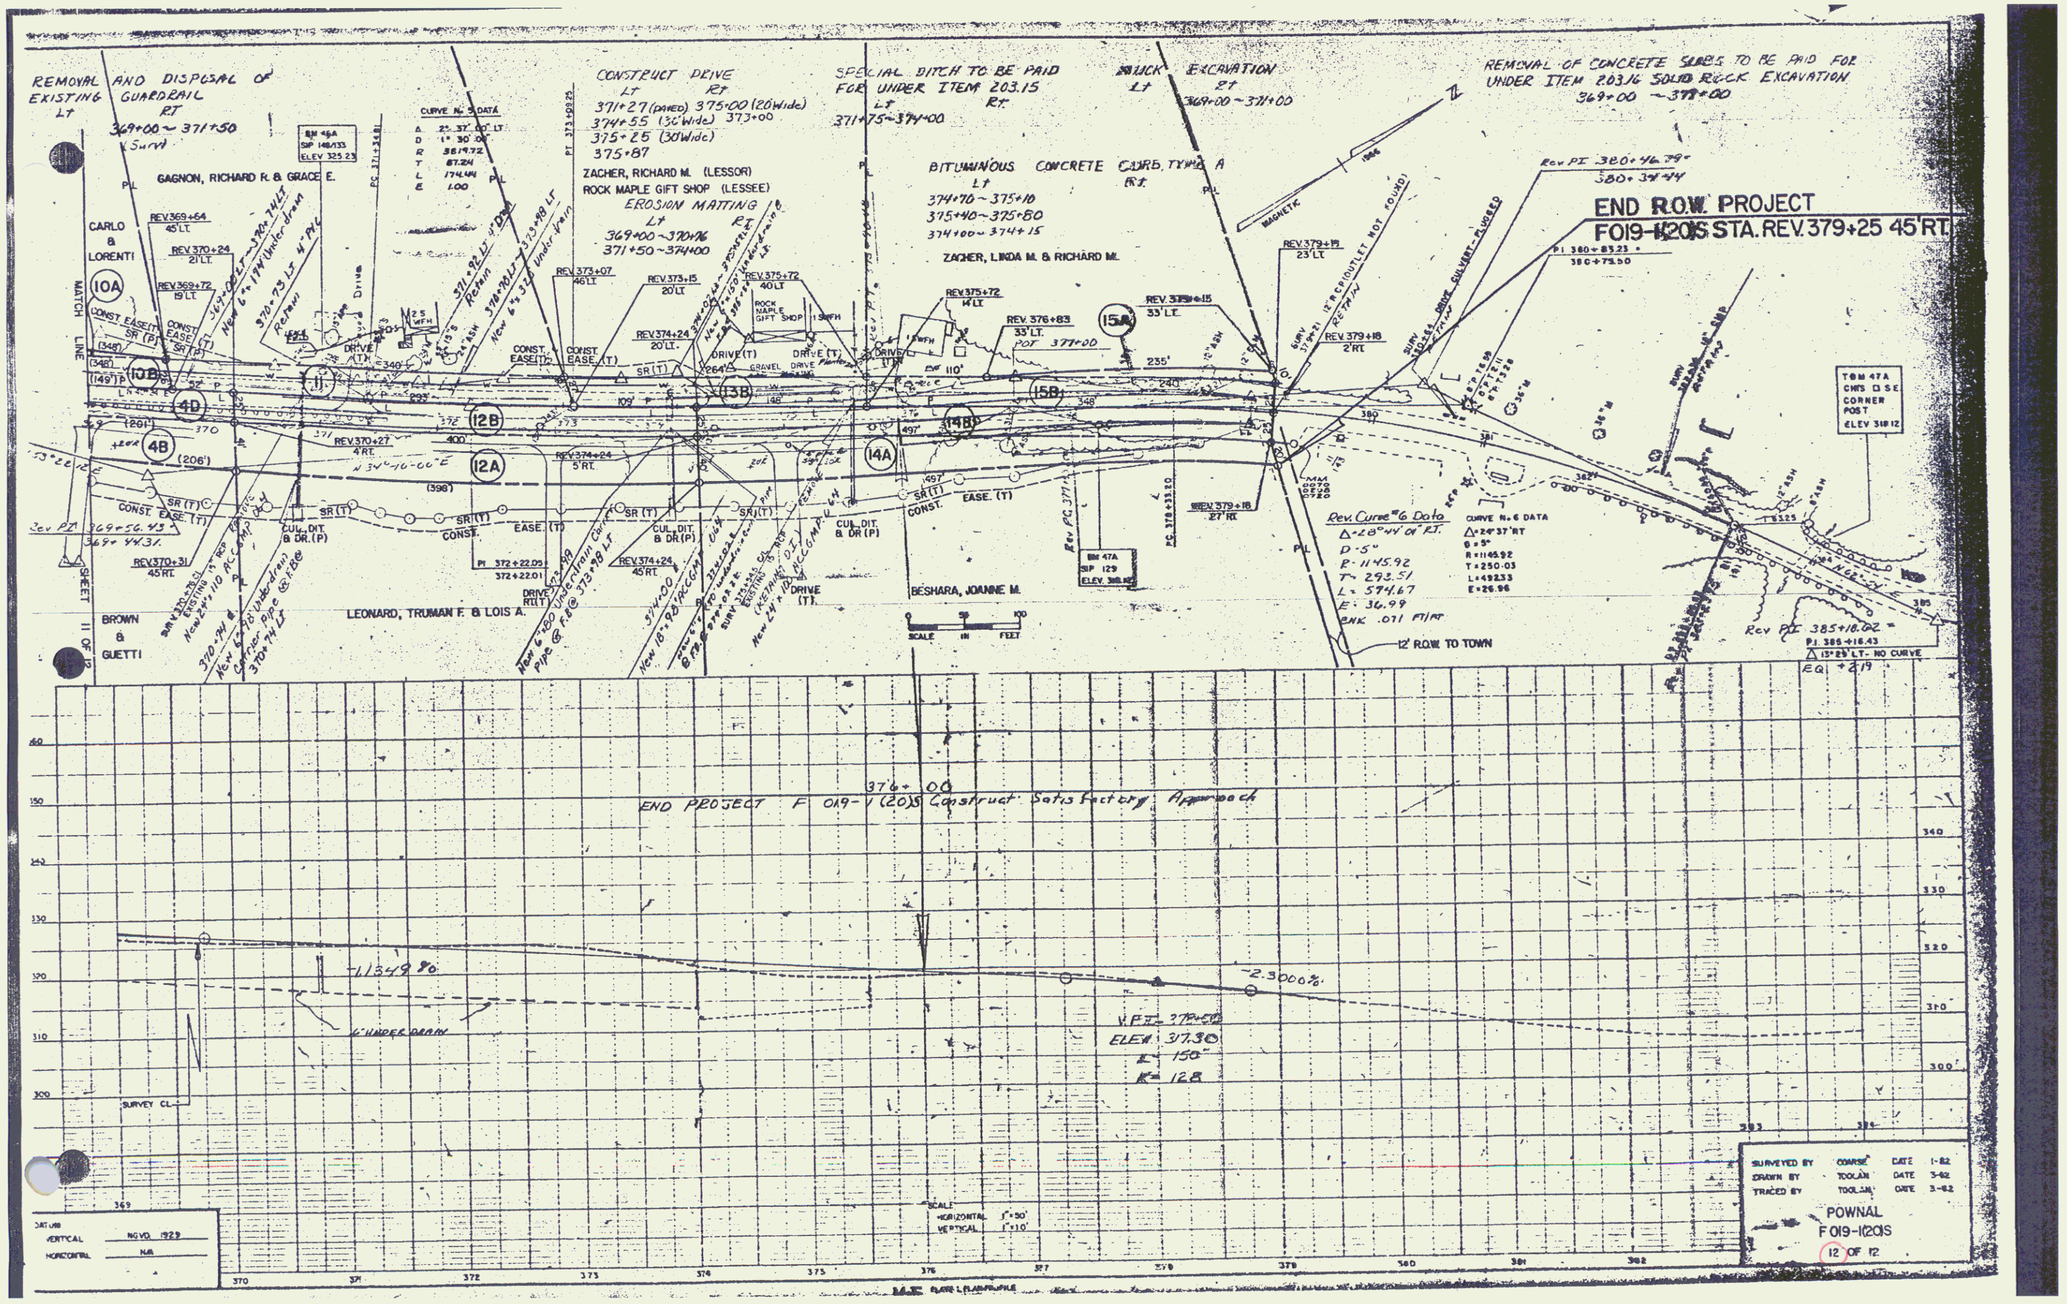

REMOVAL AND DISPOSAL OF EXISTING GUARDRAIL
CONSTRUCT DRIVE
SPECIAL DITCH TO BE PAID FOR UNDER ITEM 203.15
MUCK EXCAVATION
REMOVAL OF CONCRETE SLABS TO BE PAID FOR UNDER ITEM 203.16 SOLID ROCK EXCAVATION
END R.O.W. PROJECT
F019-1(20)S STA. REV. 379+25 45' RT.
GAGNON, RICHARD R. & GRACE E.
ZACHER, RICHARD M. (LESSOR)
ROCK MAPLE GIFT SHOP (LESSEE)
EROSION MATTING
BITUMINOUS CONCRETE CURB, TYPE A
ZACHER, LINDA M. & RICHARD M.
CARLO & LORENTI
LEONARD, TRUMAN F. & LOIS A.
BESHARA, JOANNE M.
BROWN & GUETTI
12' R.O.W. TO TOWN
Rev. Curve #6 Data
END PROJECT F 019-1(20)S Construct Satisfactory Approach
-1.1349%
-2.3000%
SURVEY CL.
SURVEYED BY COARSE DATE 1-82
DRAWN BY TOOLAN DATE 3-82
TRACED BY TOOLAN DATE 3-82
POWNAL
F019-1(20)S
12 OF 12