Construct Drive
94+80 Rt.
98+45 Rt.

Guard Rail Three Cable
w/ Light Wood Posts
94+06 ~ 90+00 Lt
95+19 ~ 98+23 Rt

Removal of Existing Portland Cement
Concrete Pavement (Solid Rock Excav)
93+00 ~ 95+00

Dragline Hamal for breaking up Existing
Portland Cement Concrete Pavement
95+00 ~ 99+00

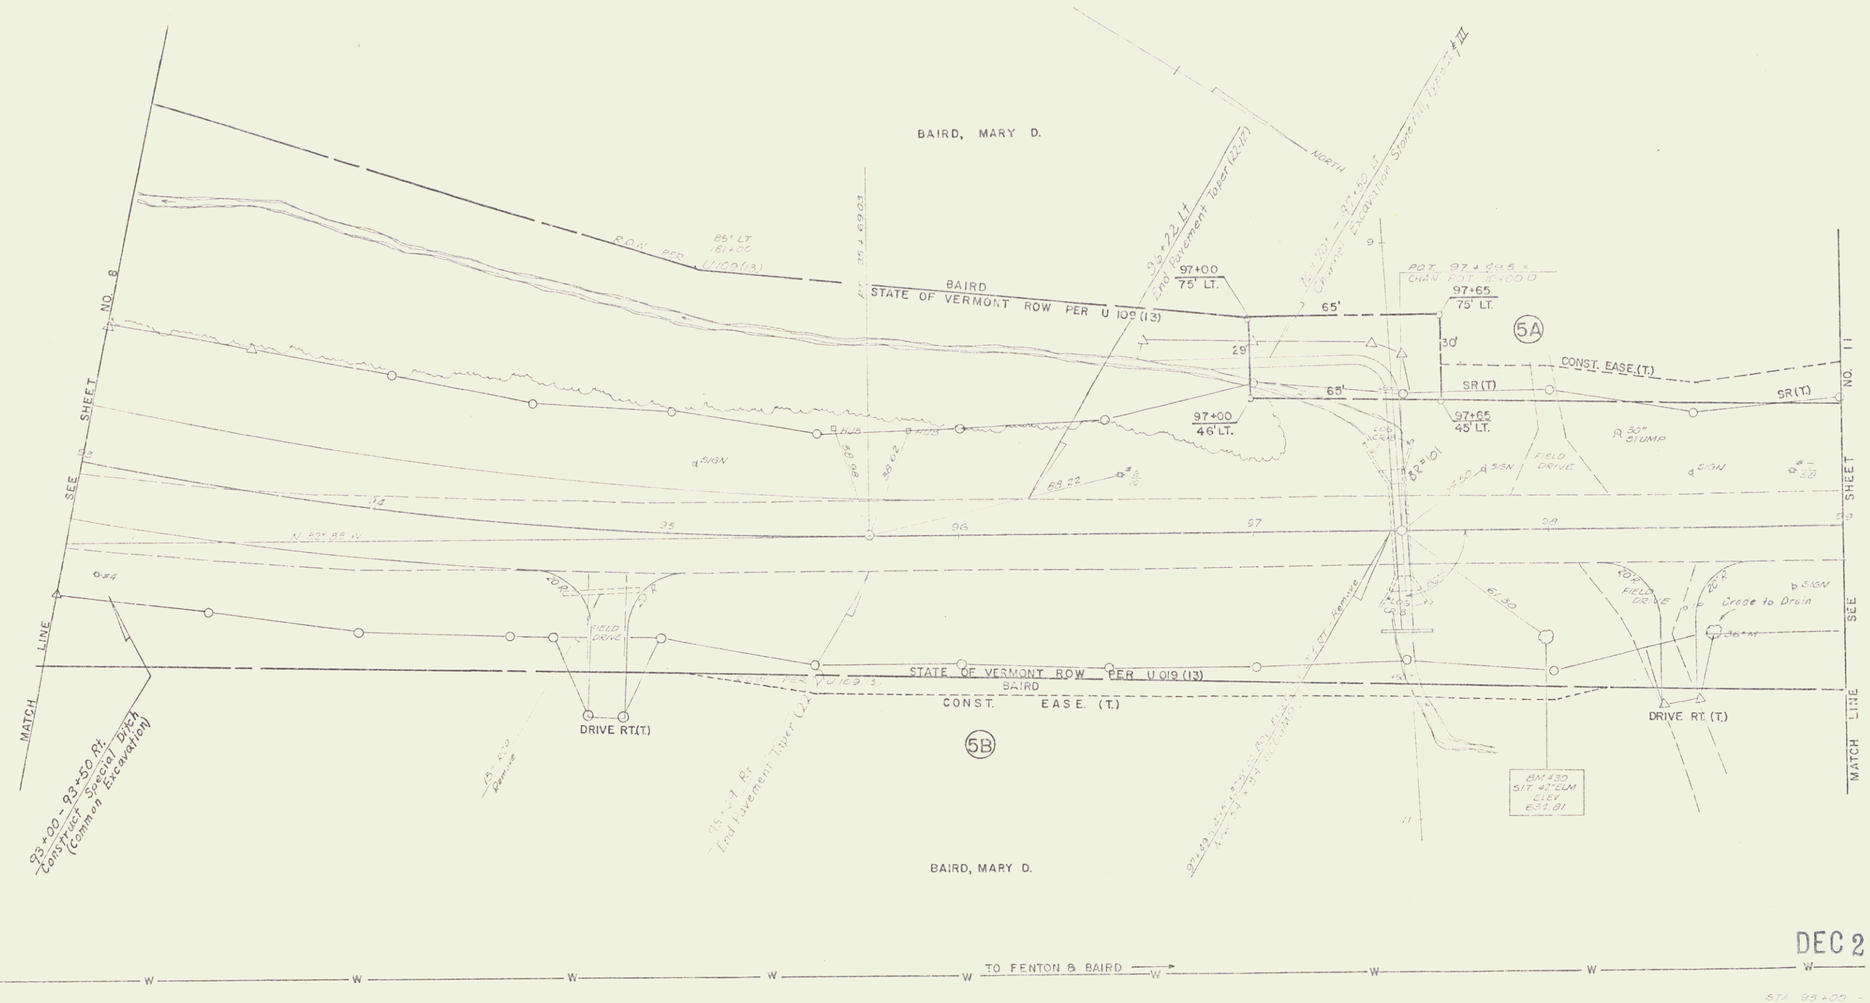

DEC 21 1981

STA 99+00 - 99+00

SURVEYED BY _____ DATE 12-55
DRAWN BY _____ DATE 12-56
TRACED BY _____ DATE 1-57

RUTLAND

PROJ. TGF No. C019-3 (17)

SHEET 10 OF 18