

CONSTRUCT DRIVE
166+00 RT.

CURVE DATA
Δ 32° 32' 40" LT.
D 7+ 30'
R 763.94'
T 222.99'
L 433.93'
E 31.88
BANK 0080 1/11

160+00~167+50 LT
(ON NEW ROW LINE)
NEW WOVEN WIRE FENCE W/ STEEL POSTS
ITEM 620.25

END R.O.W. PROJECT
RS 0137 (6) STA. 169+00 CL

TO SPRING



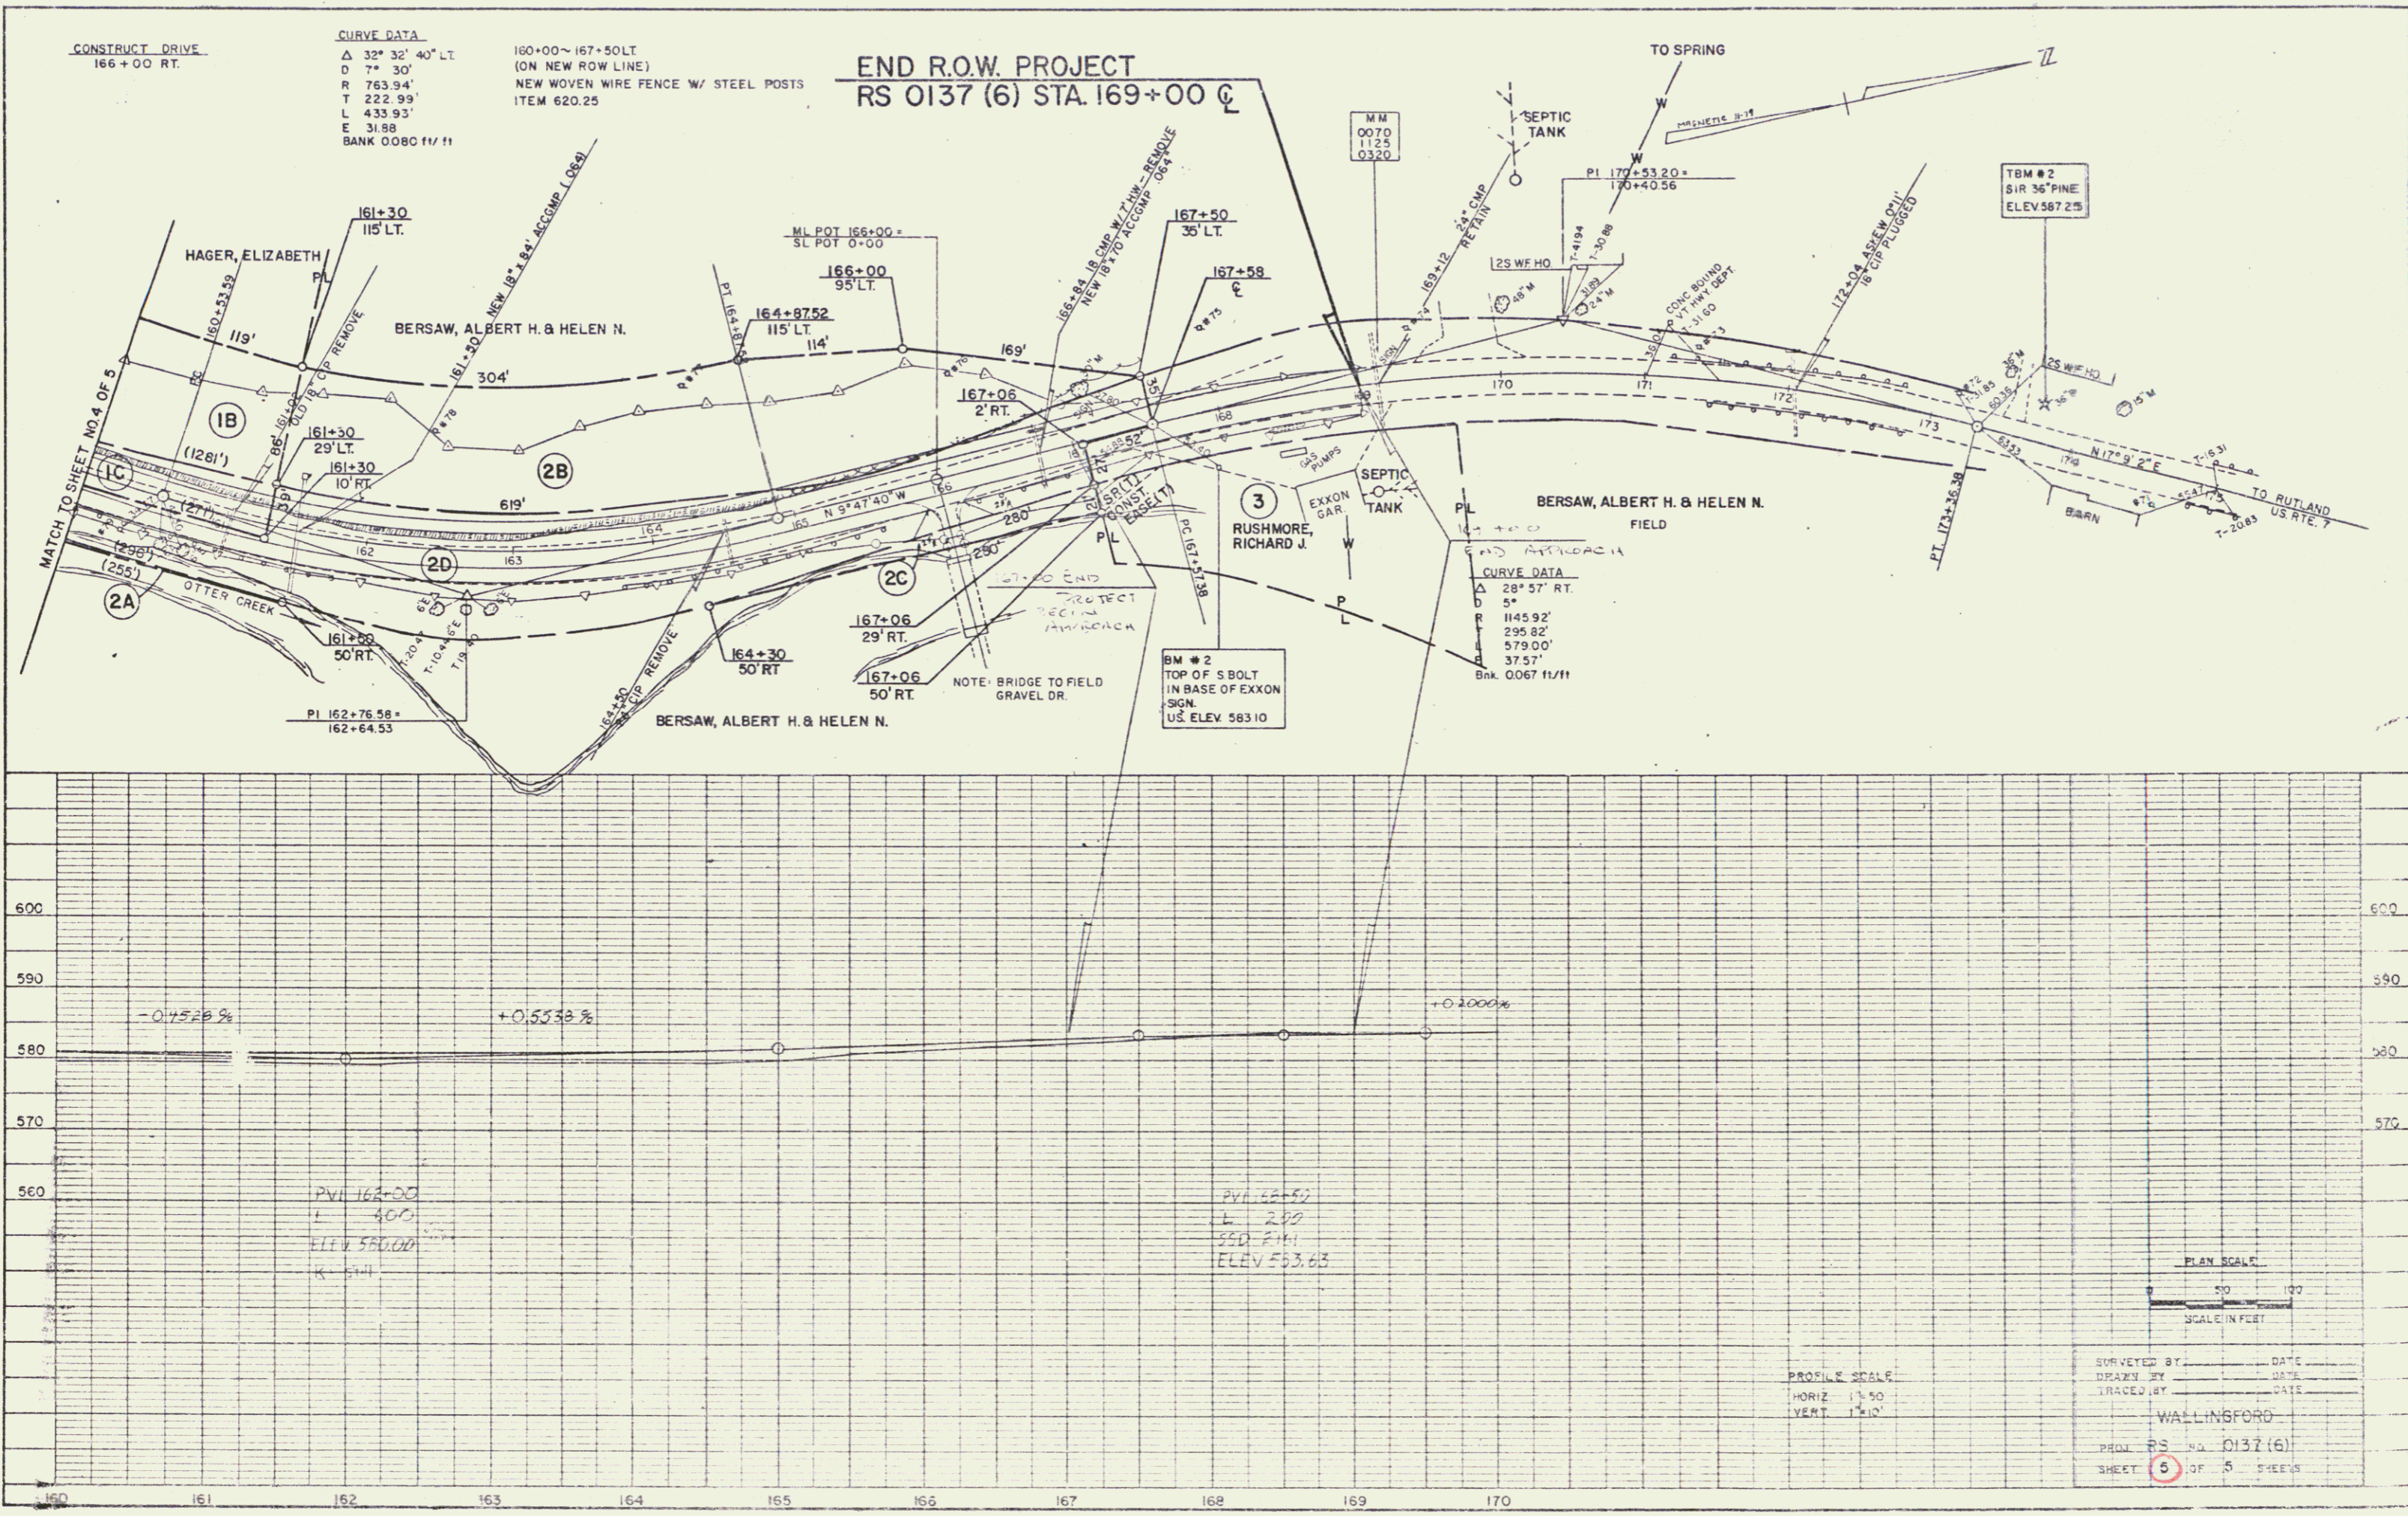


PLATE 1, PLAN PROFILE