


PLAN
 SHEET 4
 MATCH LINE

PROFILE
 SHEET 4
 MATCH LINE

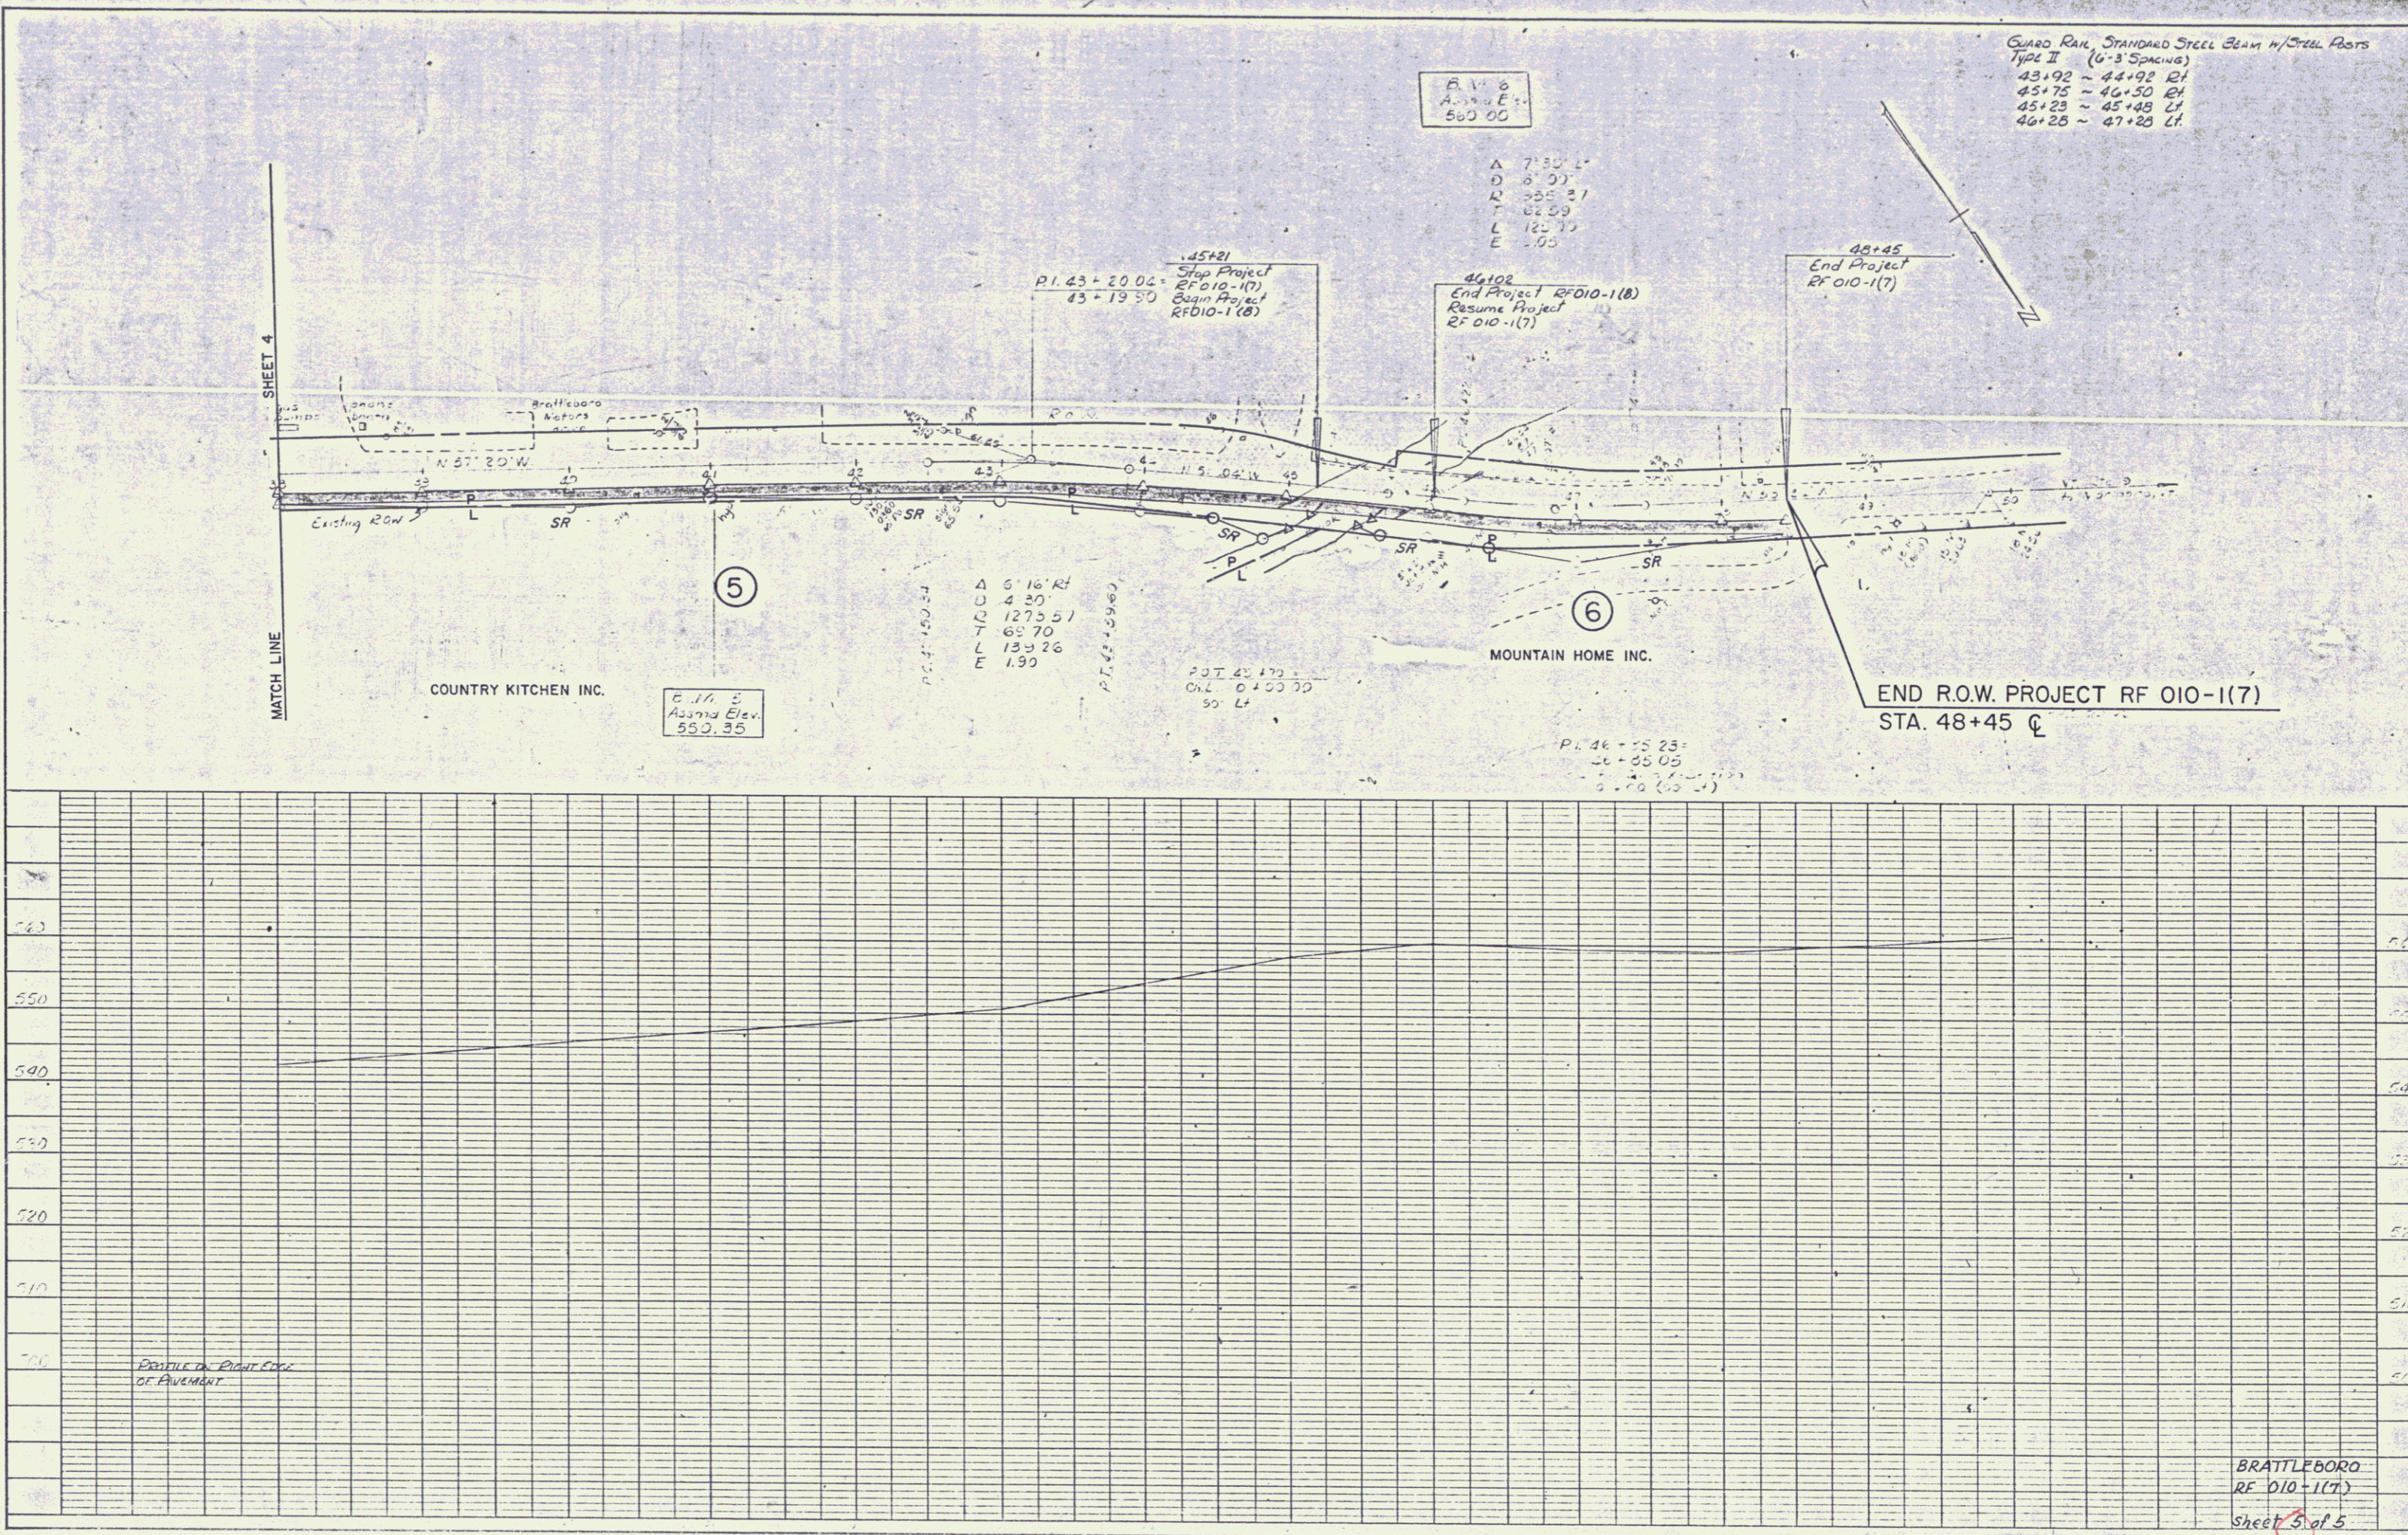

BRATTLEBORO
 RE 010-1(7)

JUN 05 1992