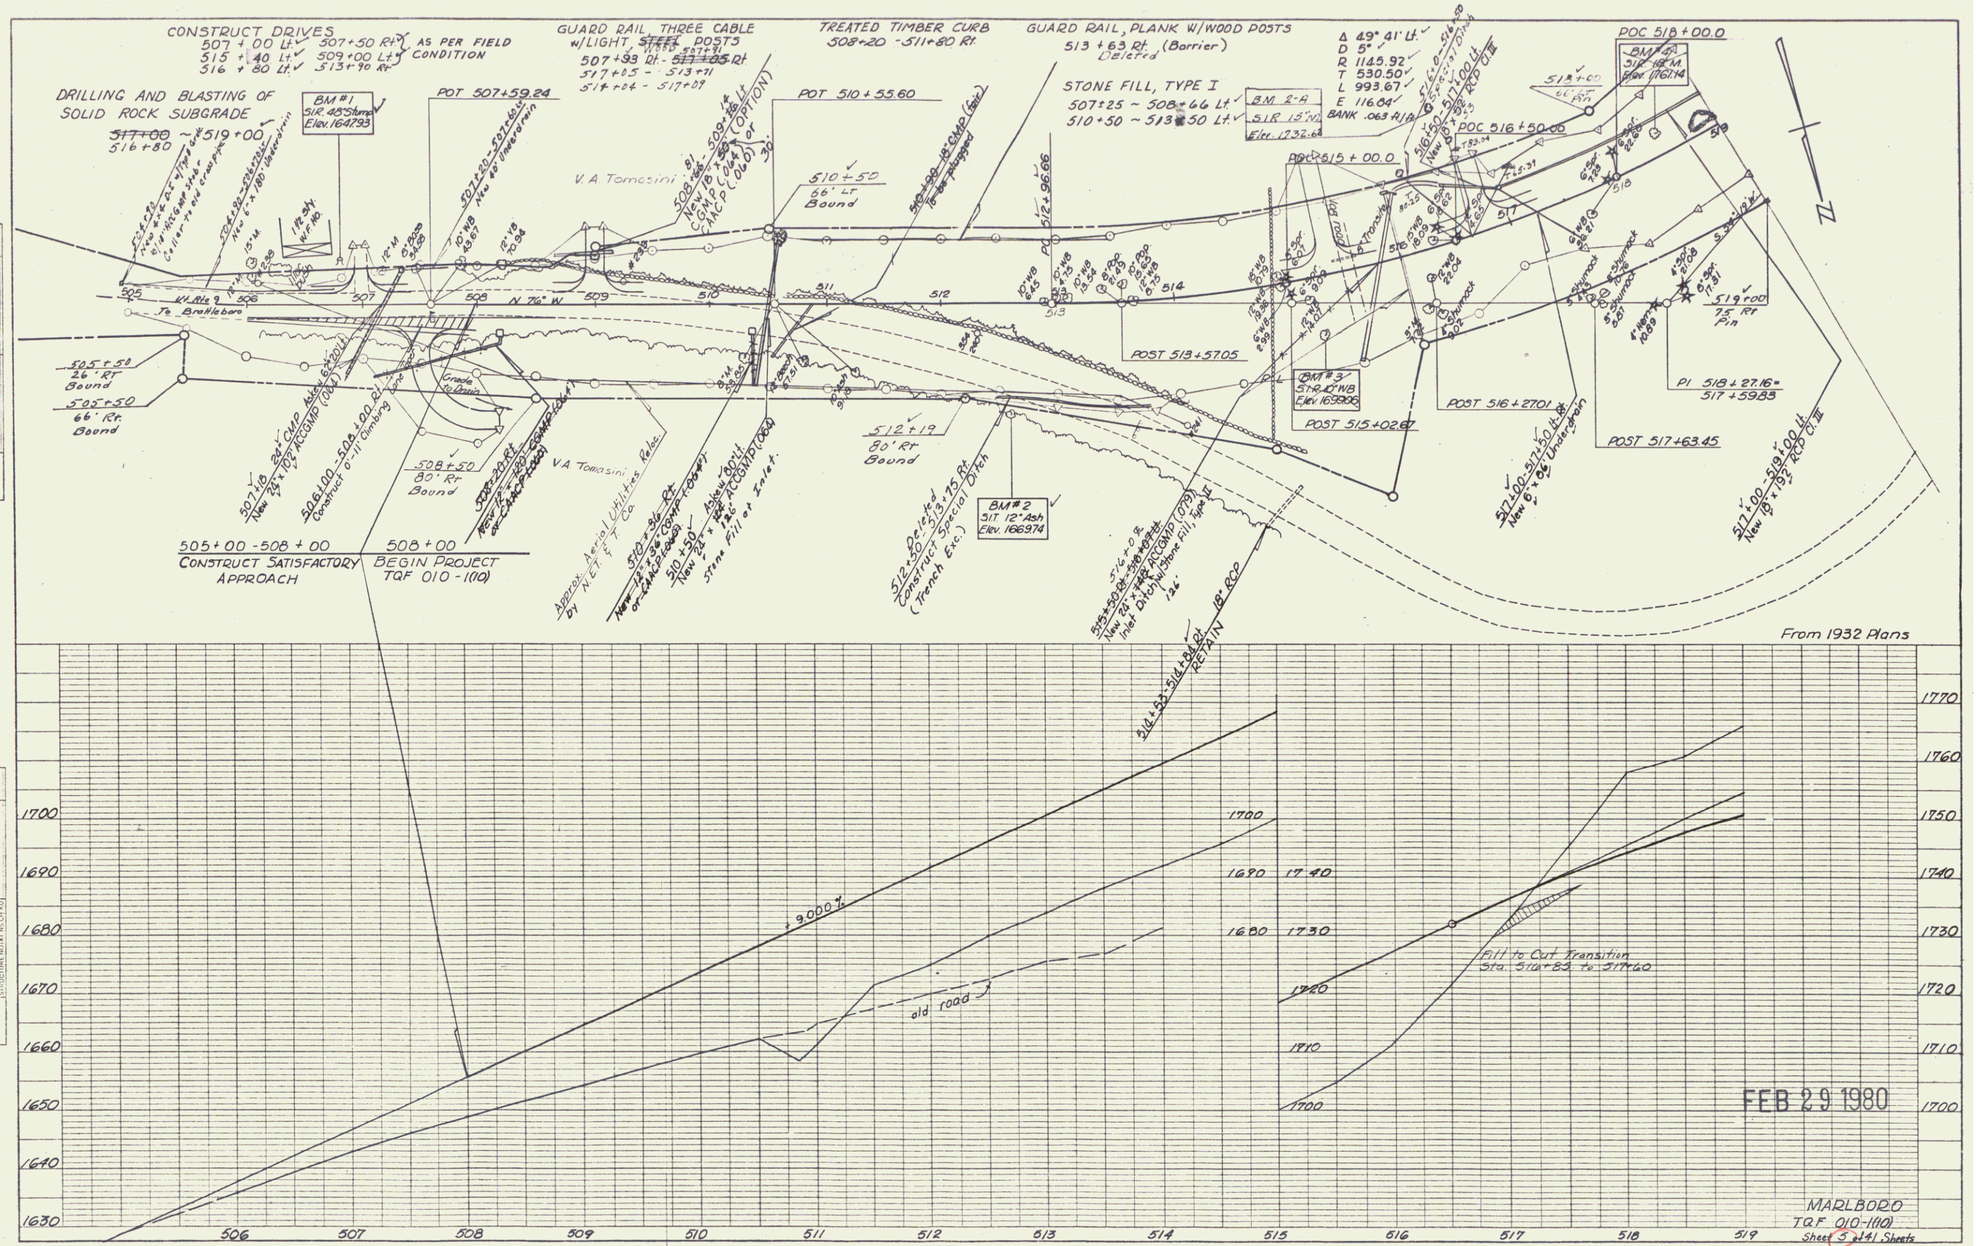

FEB 29 1980

MARLBORO
TQF 010-1(10)
Sheet 5 of 41 Sheets

PLAN
SURVEYED
PLOTTED
ALIGNMENT CHECKED
R/L OF WAY CHECKED
NOTE BOOK
NO.
BY
DATE

PROFILE
SURVEYED
PLOTTED
GRADES CHECKED
R/L OF WAY CHECKED
STRUCTURE NOTAT NO OF NO
NOTE BOOK
NO.
BY
DATE

K+E PLATE 1, PLAN-PROFILE
KEUFFEL & ESSER CO.
46 7012 IMPERIAL TRACING CLOTH

4