




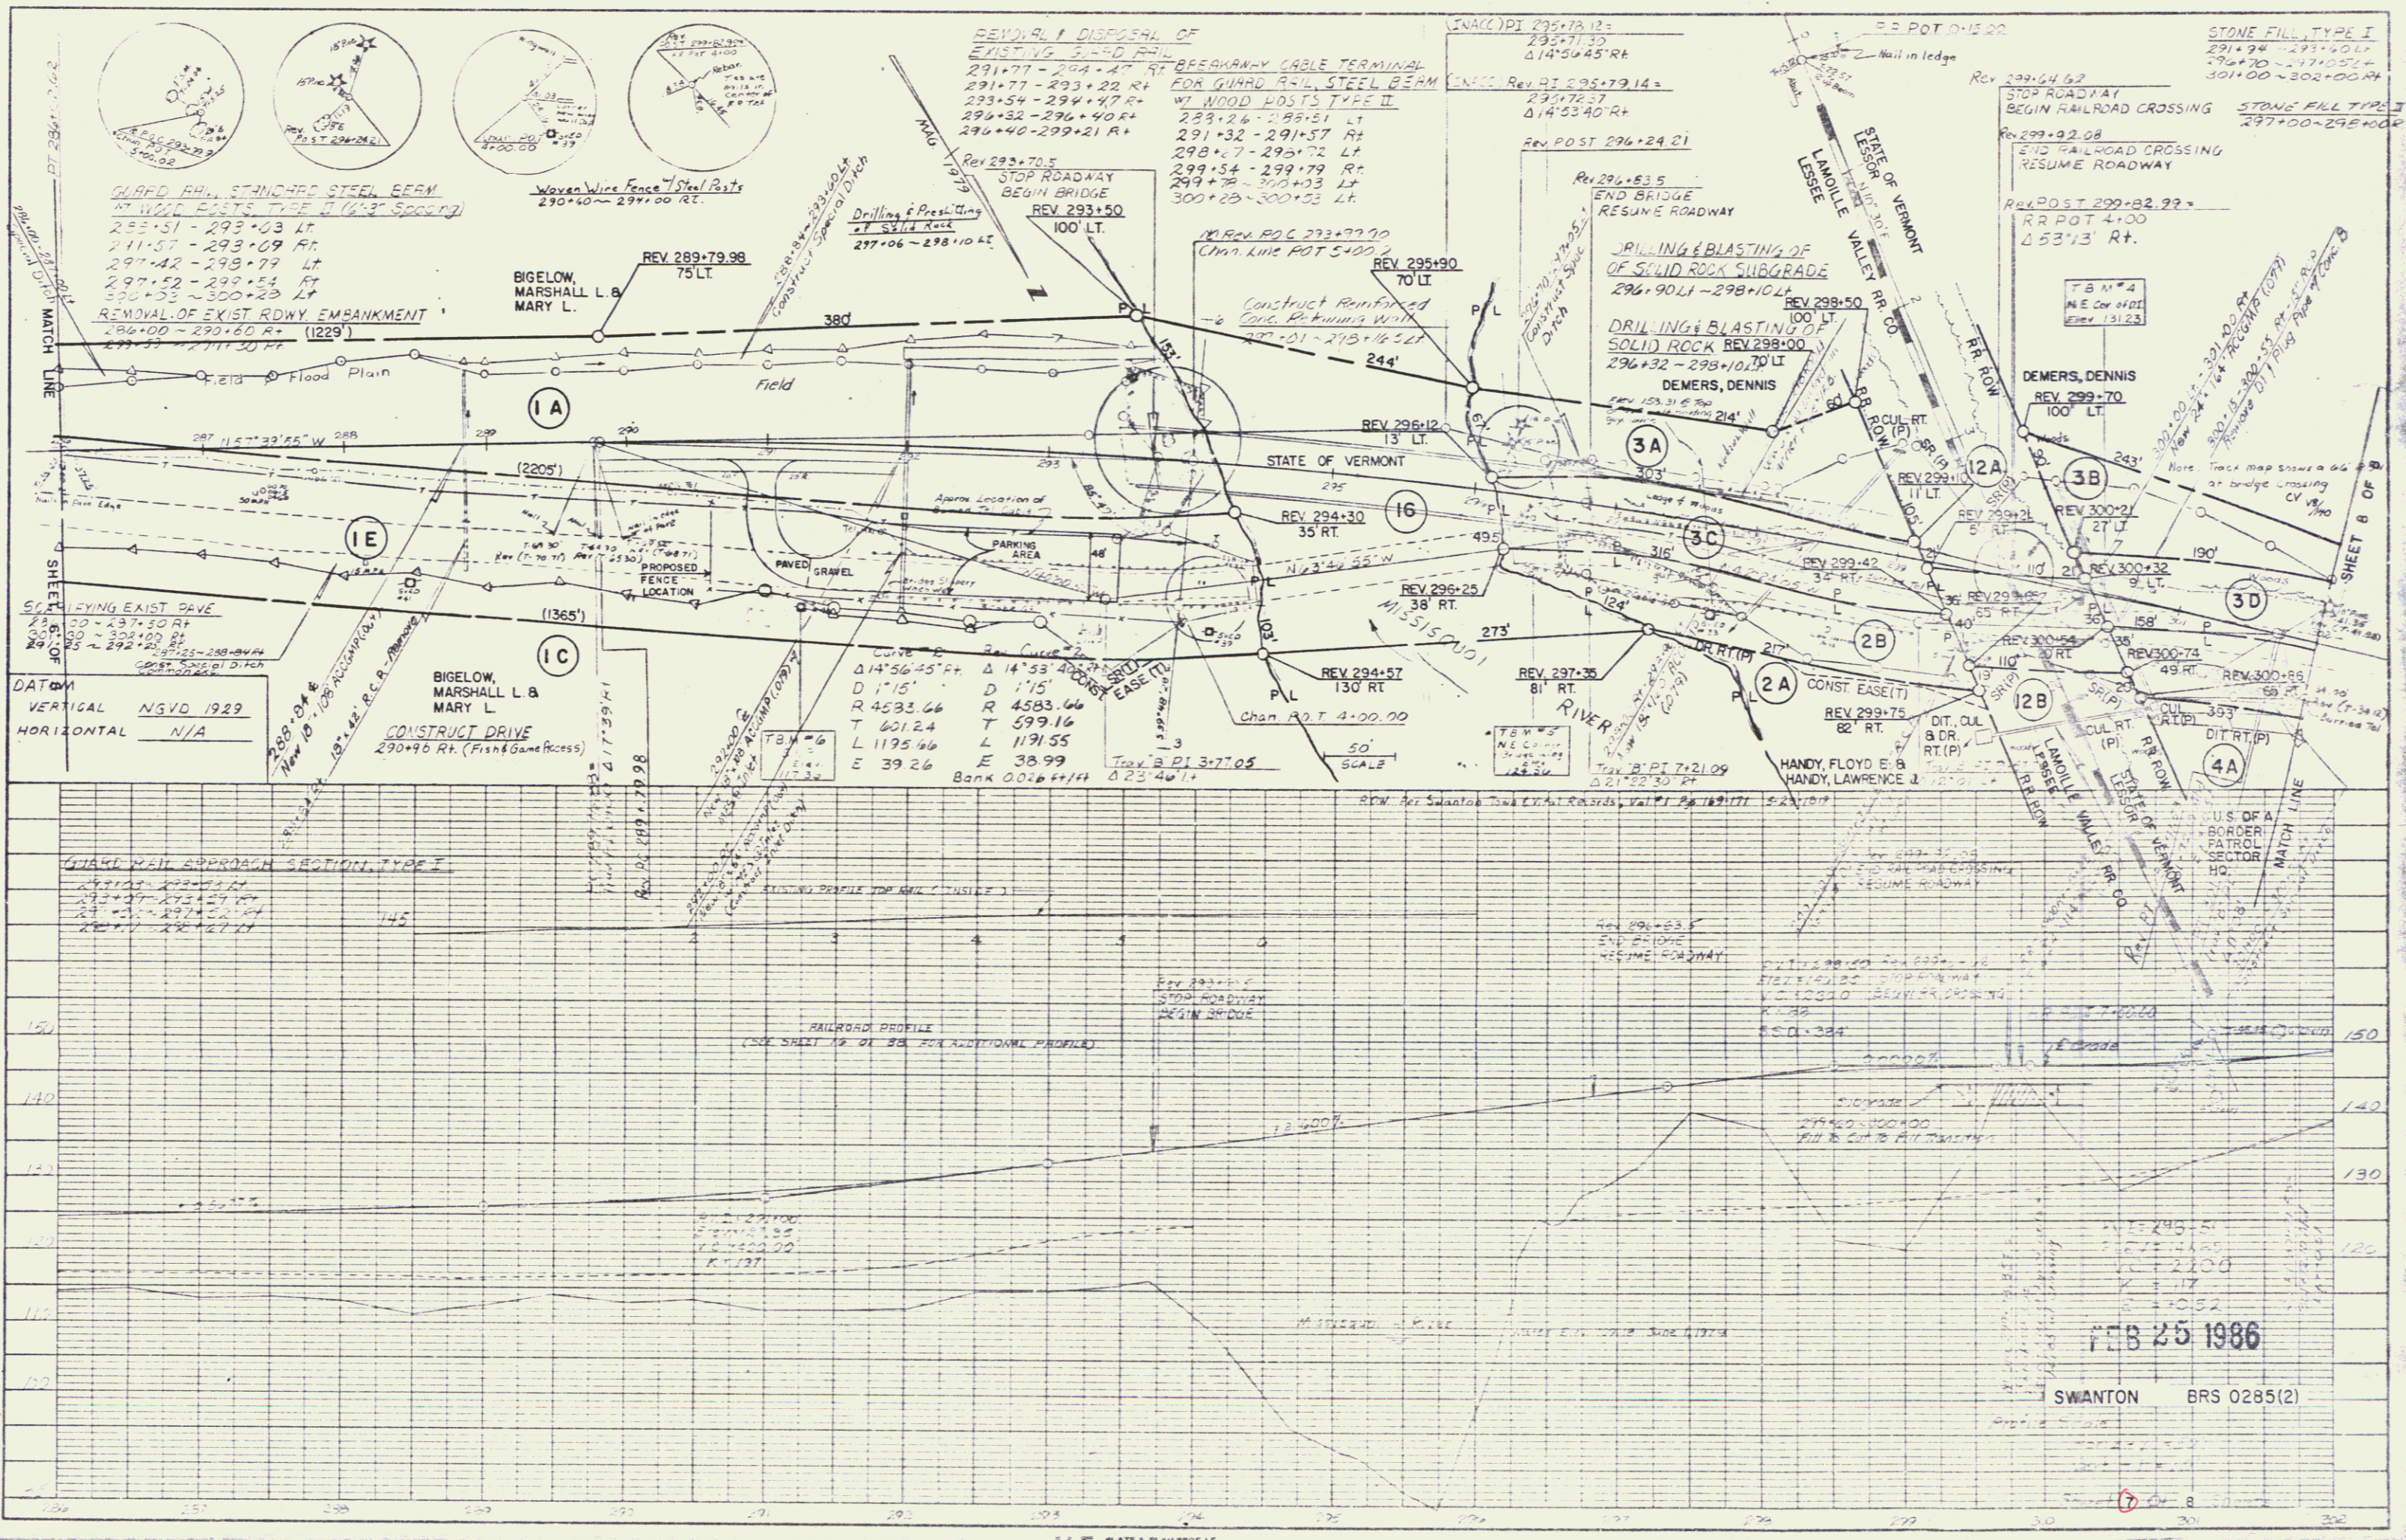

FEB 25 1986

SWANTON BRS 0285(2)