



**POOR ORIGINAL COPY**

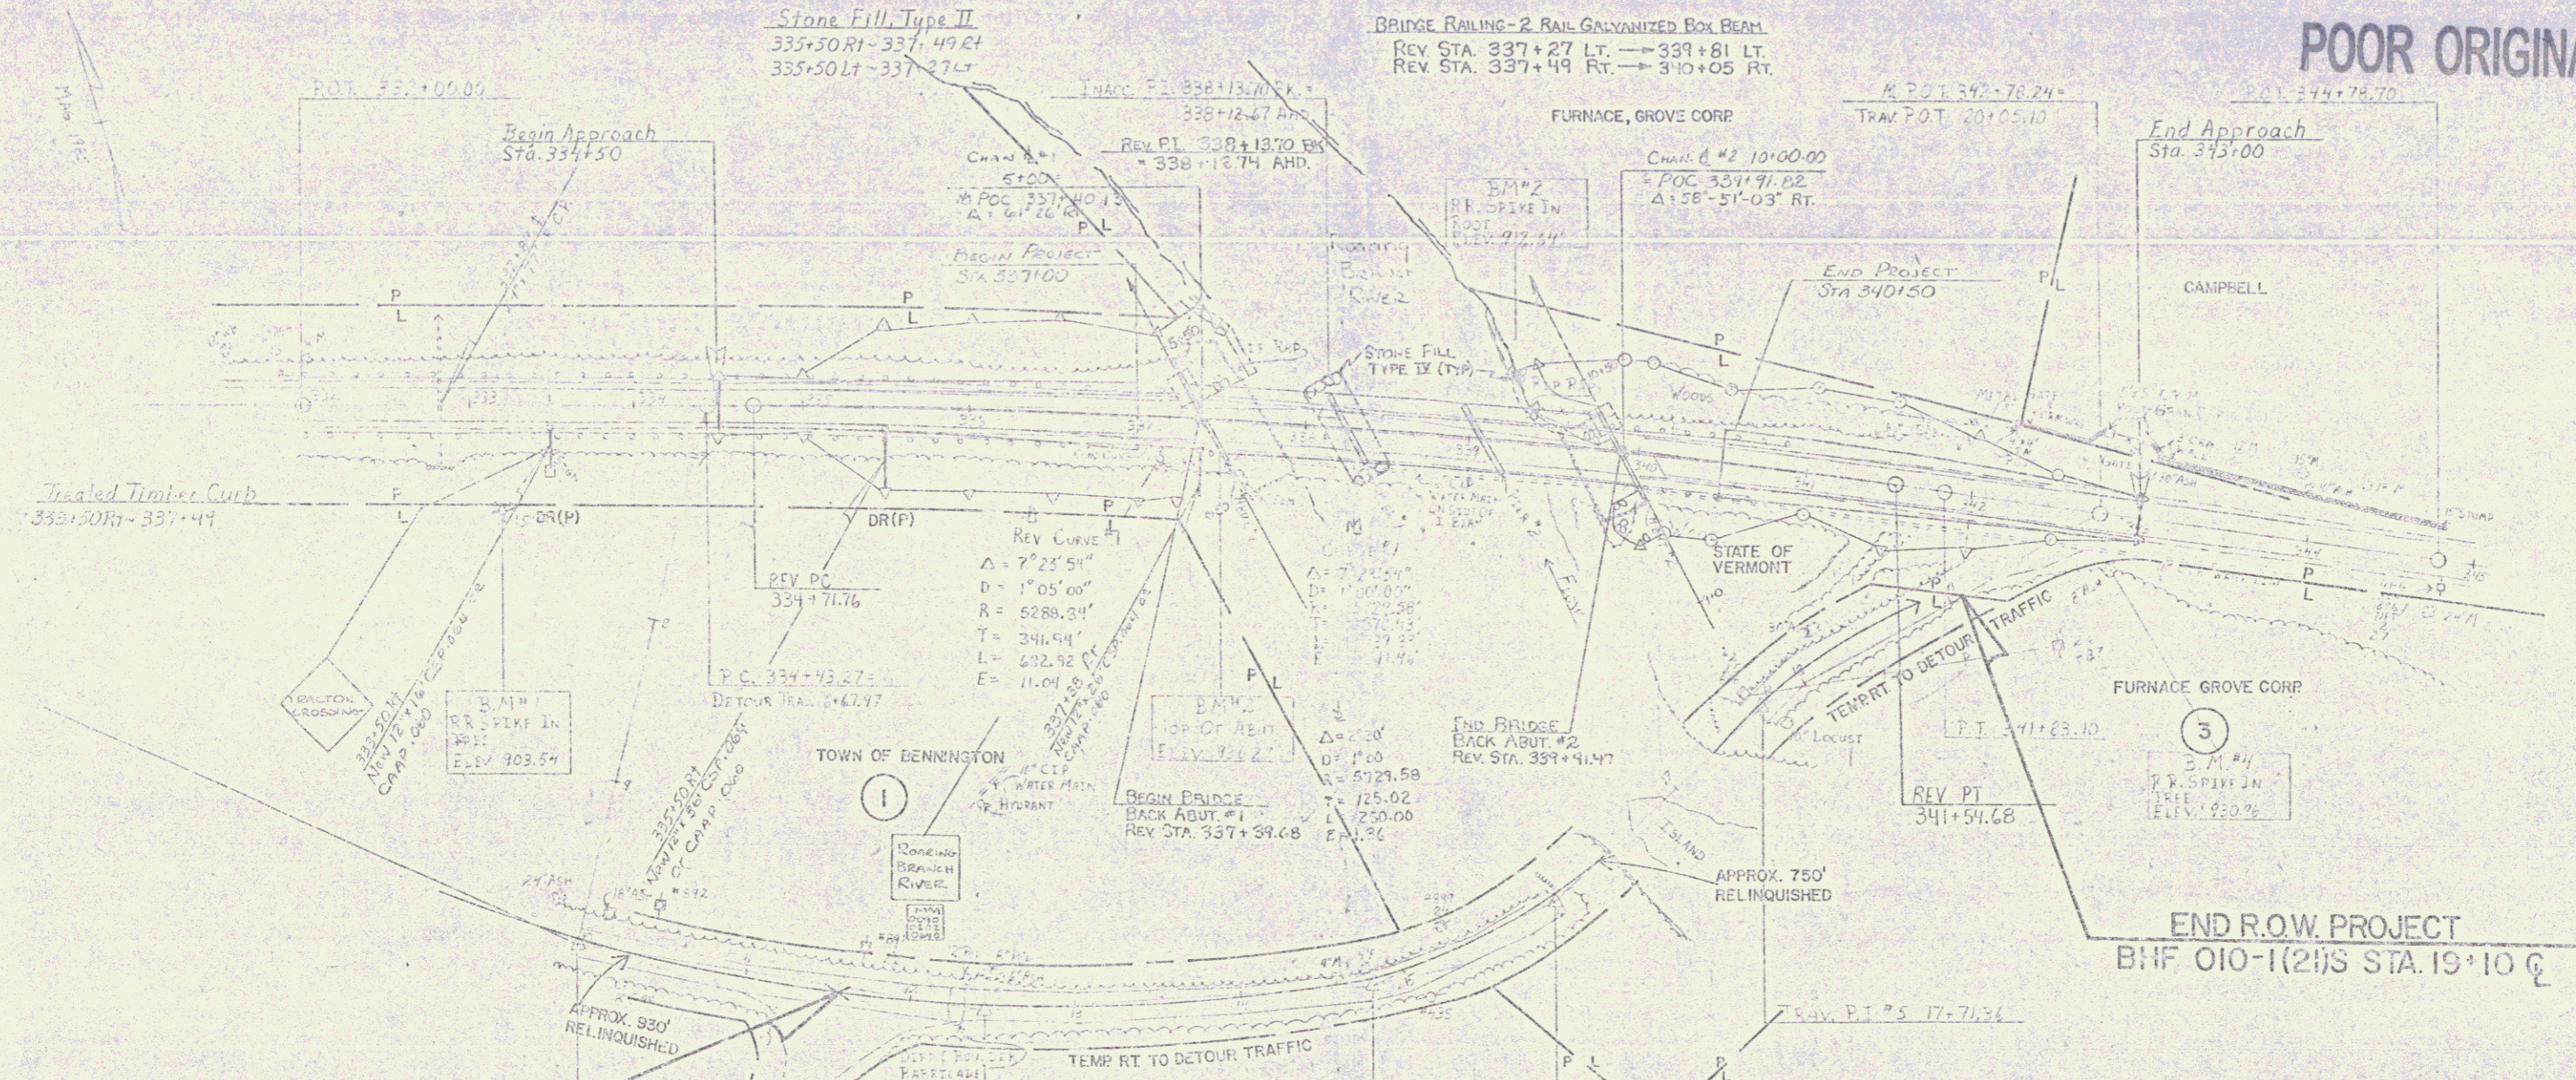

BEGIN R.O.W. PROJECT  
BHF 010-1(21)S STA. 11+50 C

END R.O.W. PROJECT  
BHF 010-1(21)S STA. 19+10 C

VERTICAL NGVD  
HORIZONTAL N/A

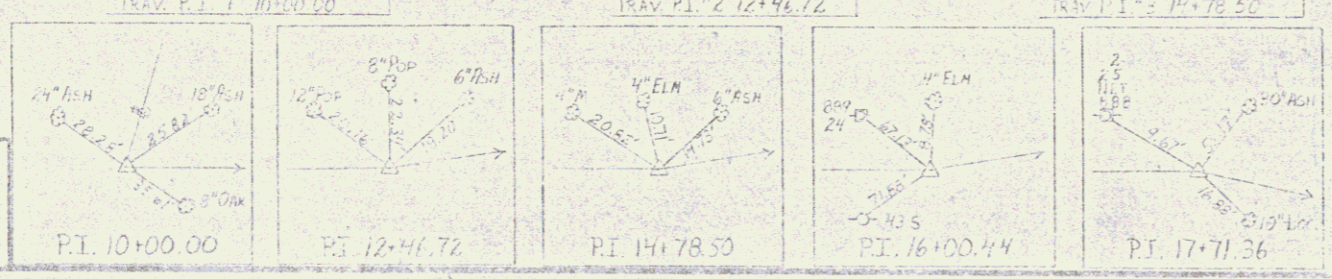

Removal & Disposal of Existing Guard Rail

LT	RT
331+76-337+30	329+53-337+45
339+83-340+90	340+05-340+70

Standard Steel Beam Guard Rail

352+02-336+77 LT
329+49-336+99 RT
340+31-344+50 LT
340+55-340+80 RT

Breakaway Cable Terminal

LT	RT
331+77-332+02	329+24-329+49
341+56-344+81	340+80-341+05

Guard Rail Approach Section, Type I

336+99 RT-337+49 RT
340+05 RT-340+55 RT
336+77 LT-337+27 LT
339+81 LT-340+31 LT

R.O.W. PLANS

BENNINGTON  
BHF 010-1(21)S

SHEET 5 OF 5