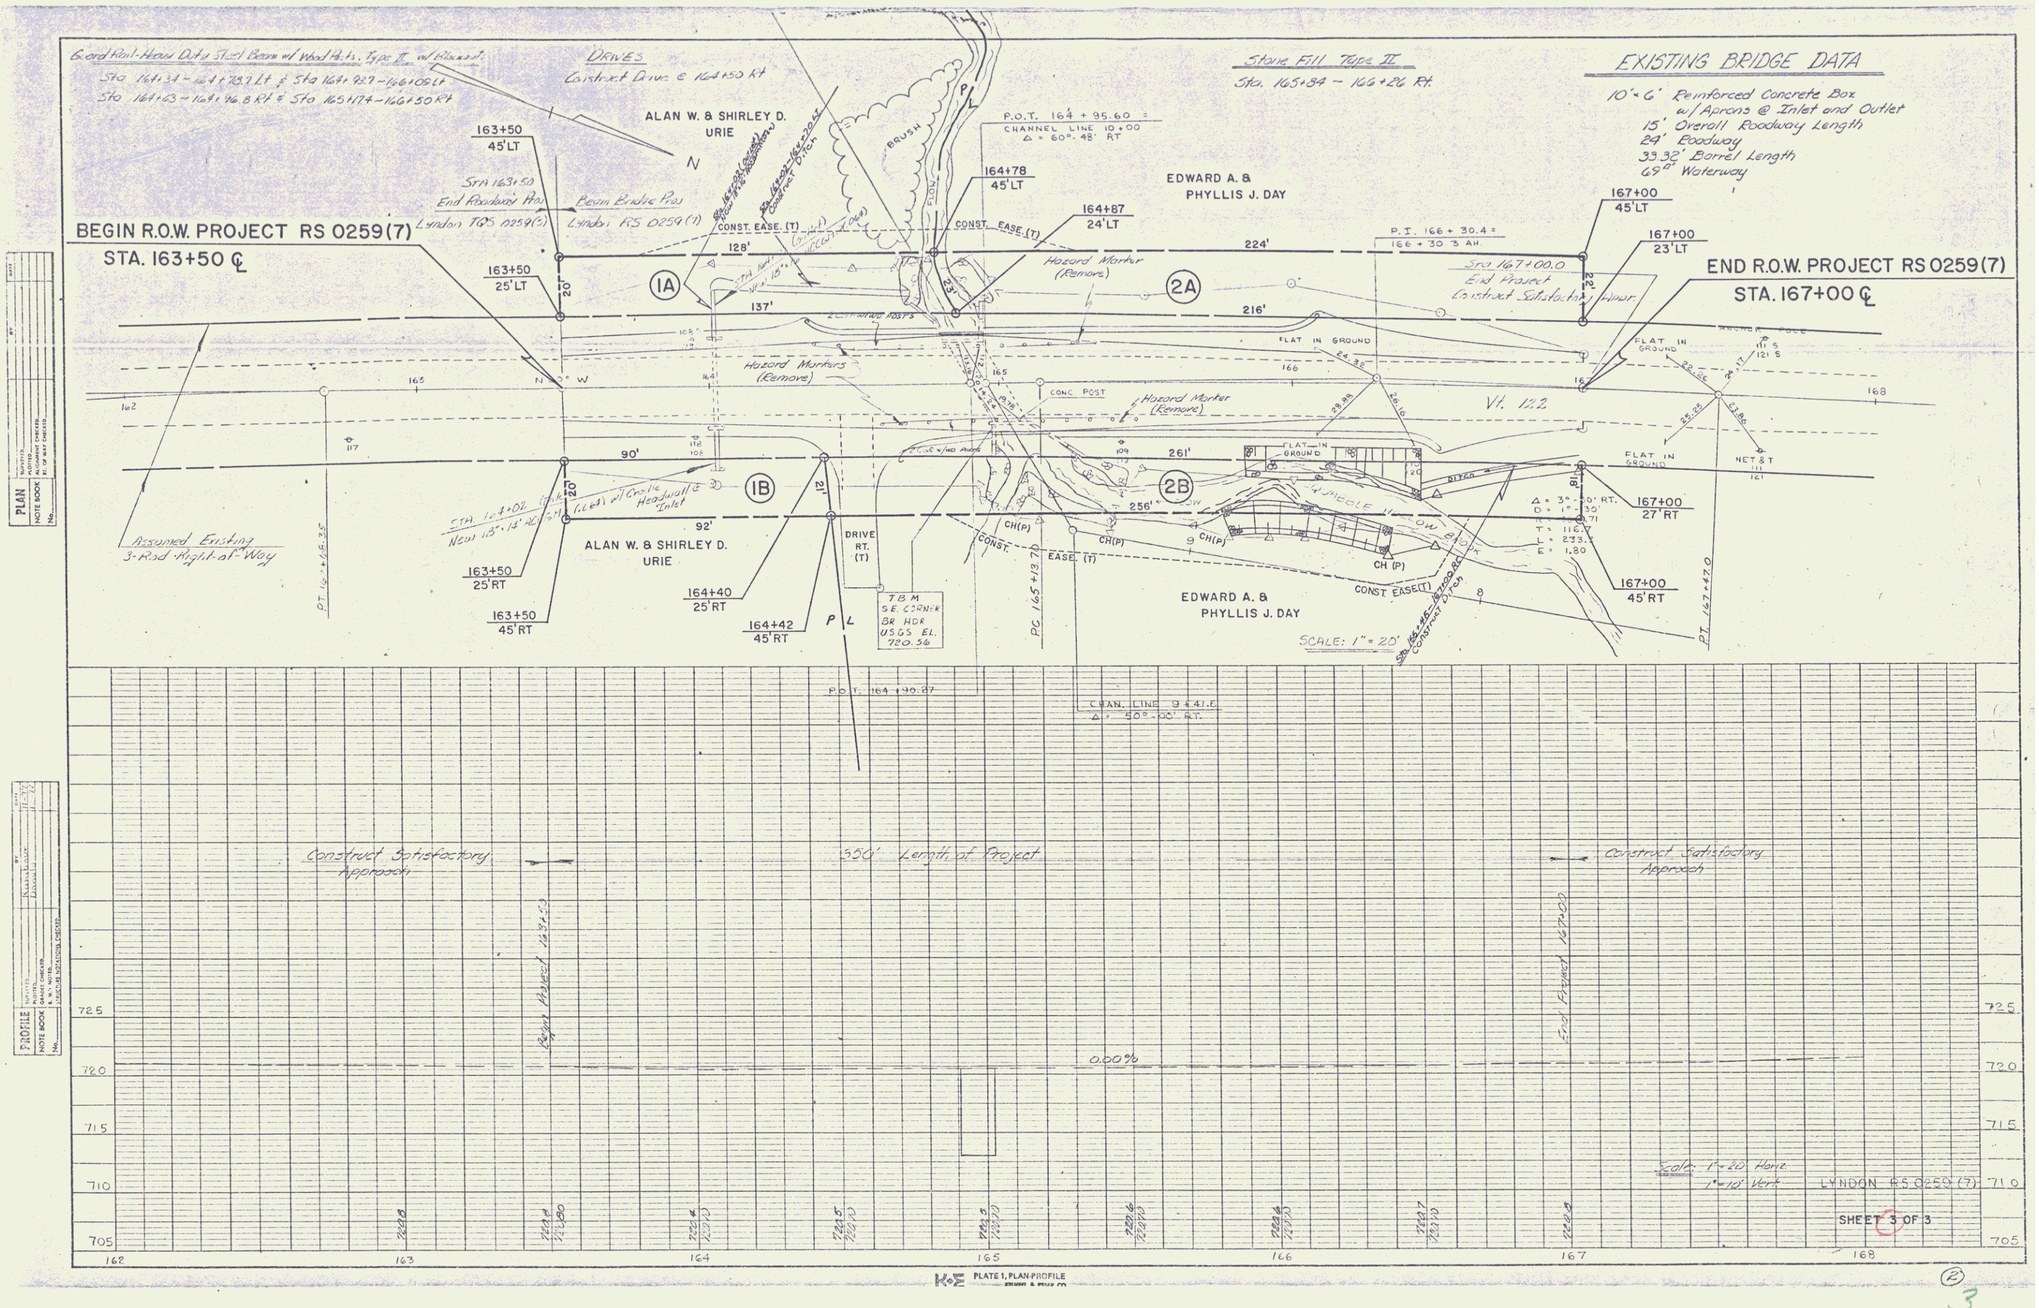


PLAN
NOTE BOOK
No.

PROFILE
NOTE BOOK
No.

K+E PLATE 1, PLAN-PROFILE

APR 15 1992