PLAN
NOTE BOOK
No.
SURVEYED
PLOTTED
ALIGNMENT CHECKED
PLAN PROFILE CHECKED
DATE
BY

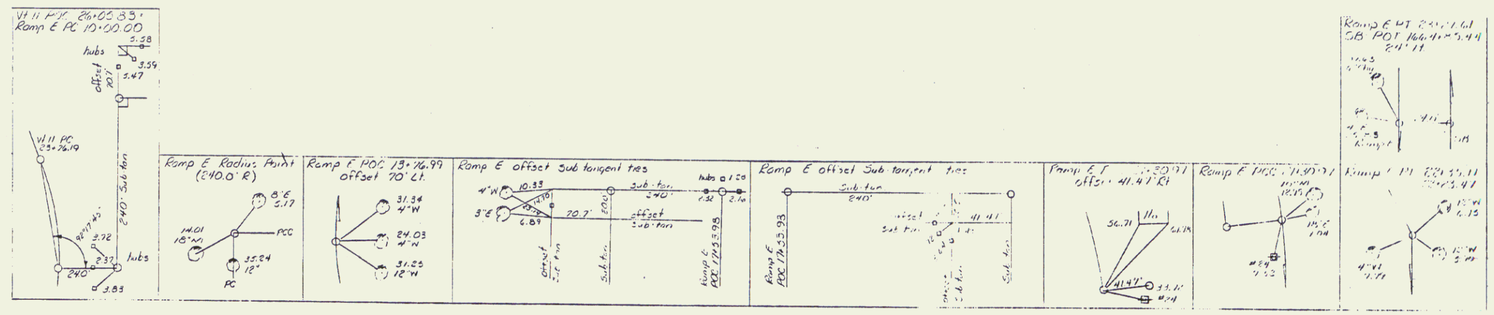

JUL 25 1994

PROFILE
NOTE BOOK
No.
SURVEYED
PLOTTED
ALIGNMENT CHECKED
& PLAN PROFILE
STRUCTURE POSITIONS, CBD, ETC.
DATE
BY

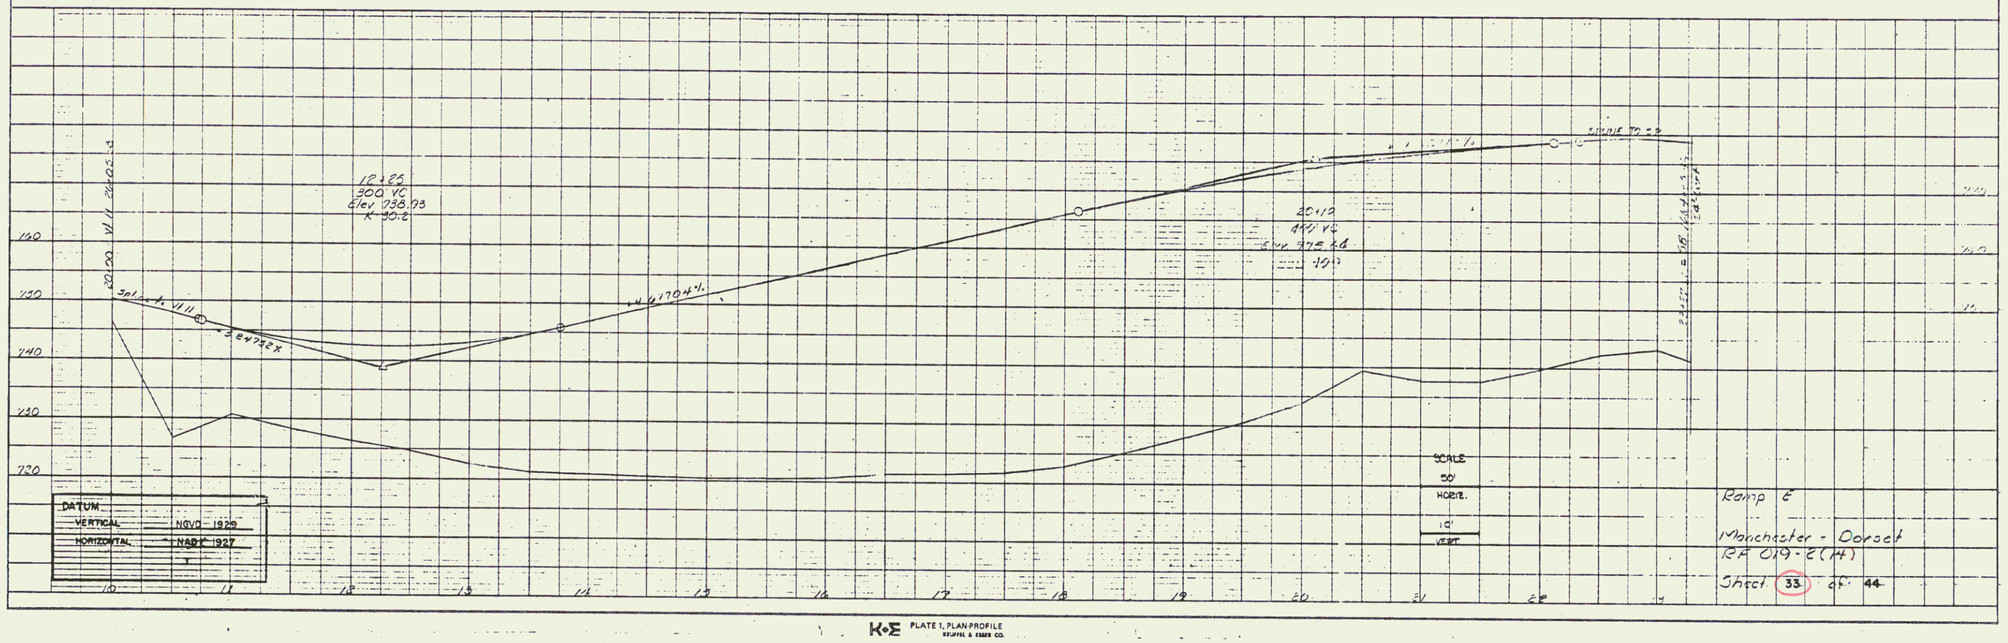

Ramp E
Manchester - Dorset
RF 019-2(14)
Sheet 33 of 44

K+E PLATE 1, PLAN-PROFILE
KEUFFEL & ESSER CO.