
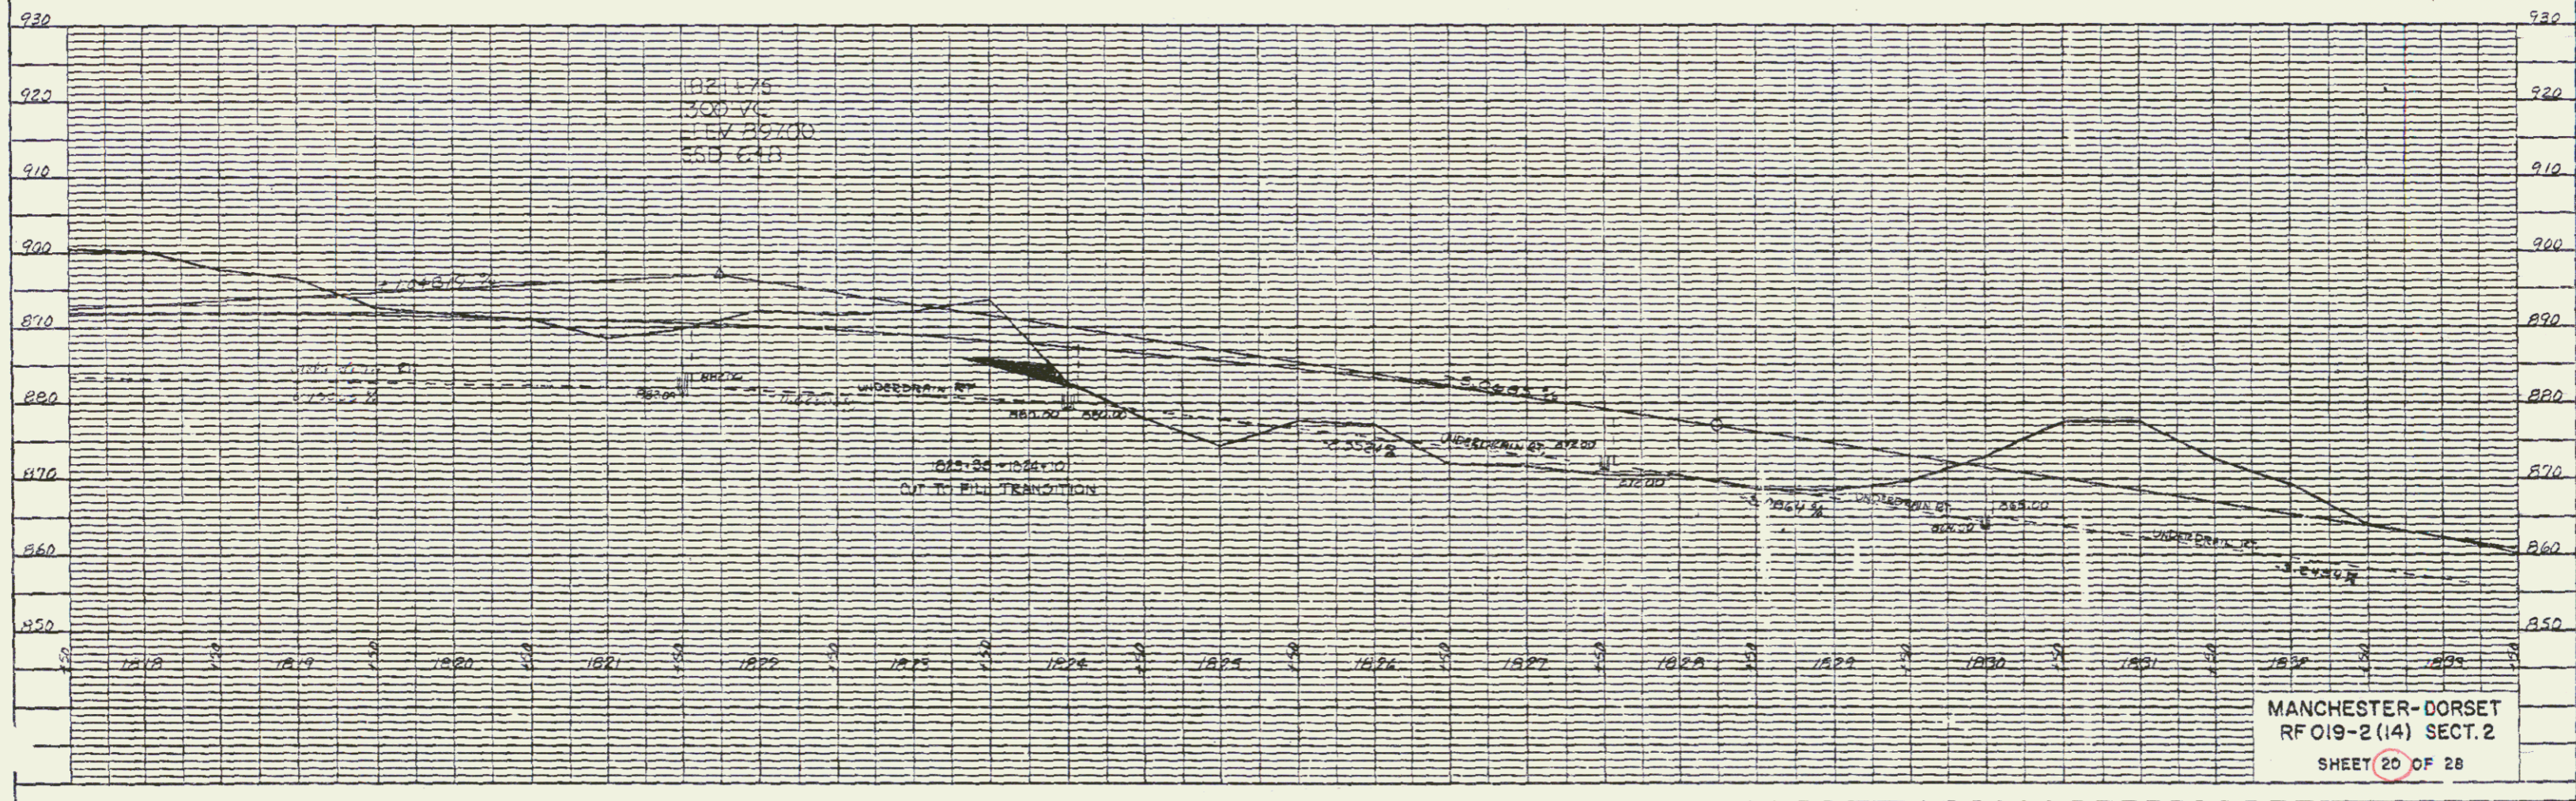


DATE	
BY	
CHECKED	
APPROVED	
PROJECT	
DATE BOOK	
NO. OF SHEETS	
NO.	

DATE	
BY	
CHECKED	
APPROVED	
PROJECT	
DATE BOOK	
NO. OF SHEETS	
NO.	

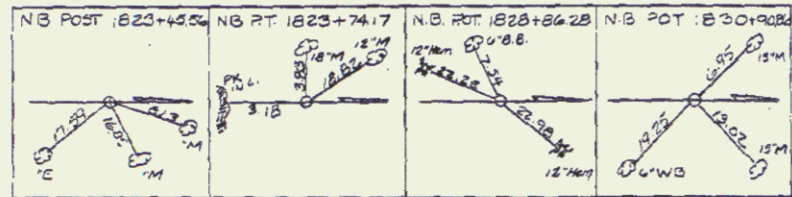

MANCHESTER-DORSET  
RFO19-2(14) SECT.2  
SHEET 20 OF 28

K-E PLATE 1, PLAN-PROFILE  
SCALE: 1"=40'  
© 1994 K&E

AUG 2 1994 64