PLAN

SURVEYED
PLOTTED
TEMPLET AND CHECKED
RT. OF WAY CHECKED

BY | DATE

PROFILE

SURVEYED
PLOTTED
GRID AND CHECKED
S.B.M. PLOTTED
ELEVATIONS (RELATIVE OR FIXED)

BY | DATE

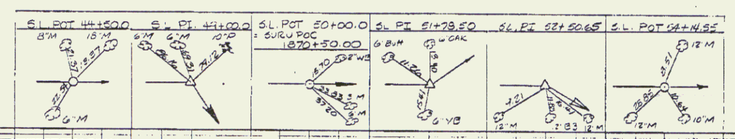


TYPICAL SECTION
FOREST SERVICE ACCESS RD.

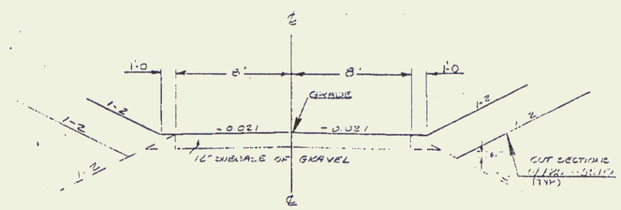


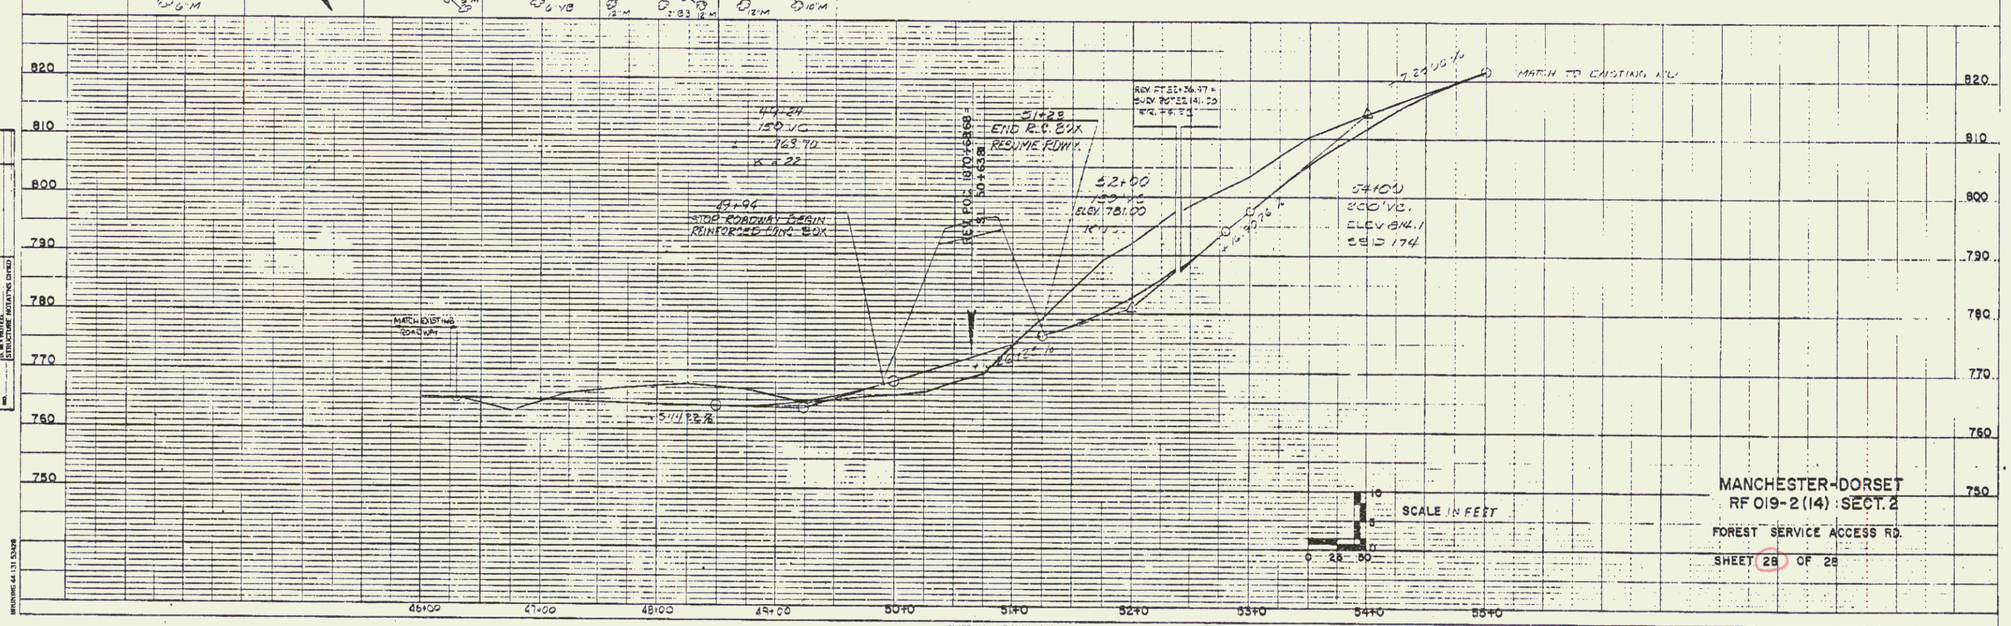


MANCHESTER-DORSET
RF 019-2 (14) : SECT. 2
FOREST SERVICE ACCESS RD.
SHEET 28 OF 28

PLATE 1 SINGLE PLAN - PROFILE
CHARLES BRUNING CO.

AUG 2 1994

72