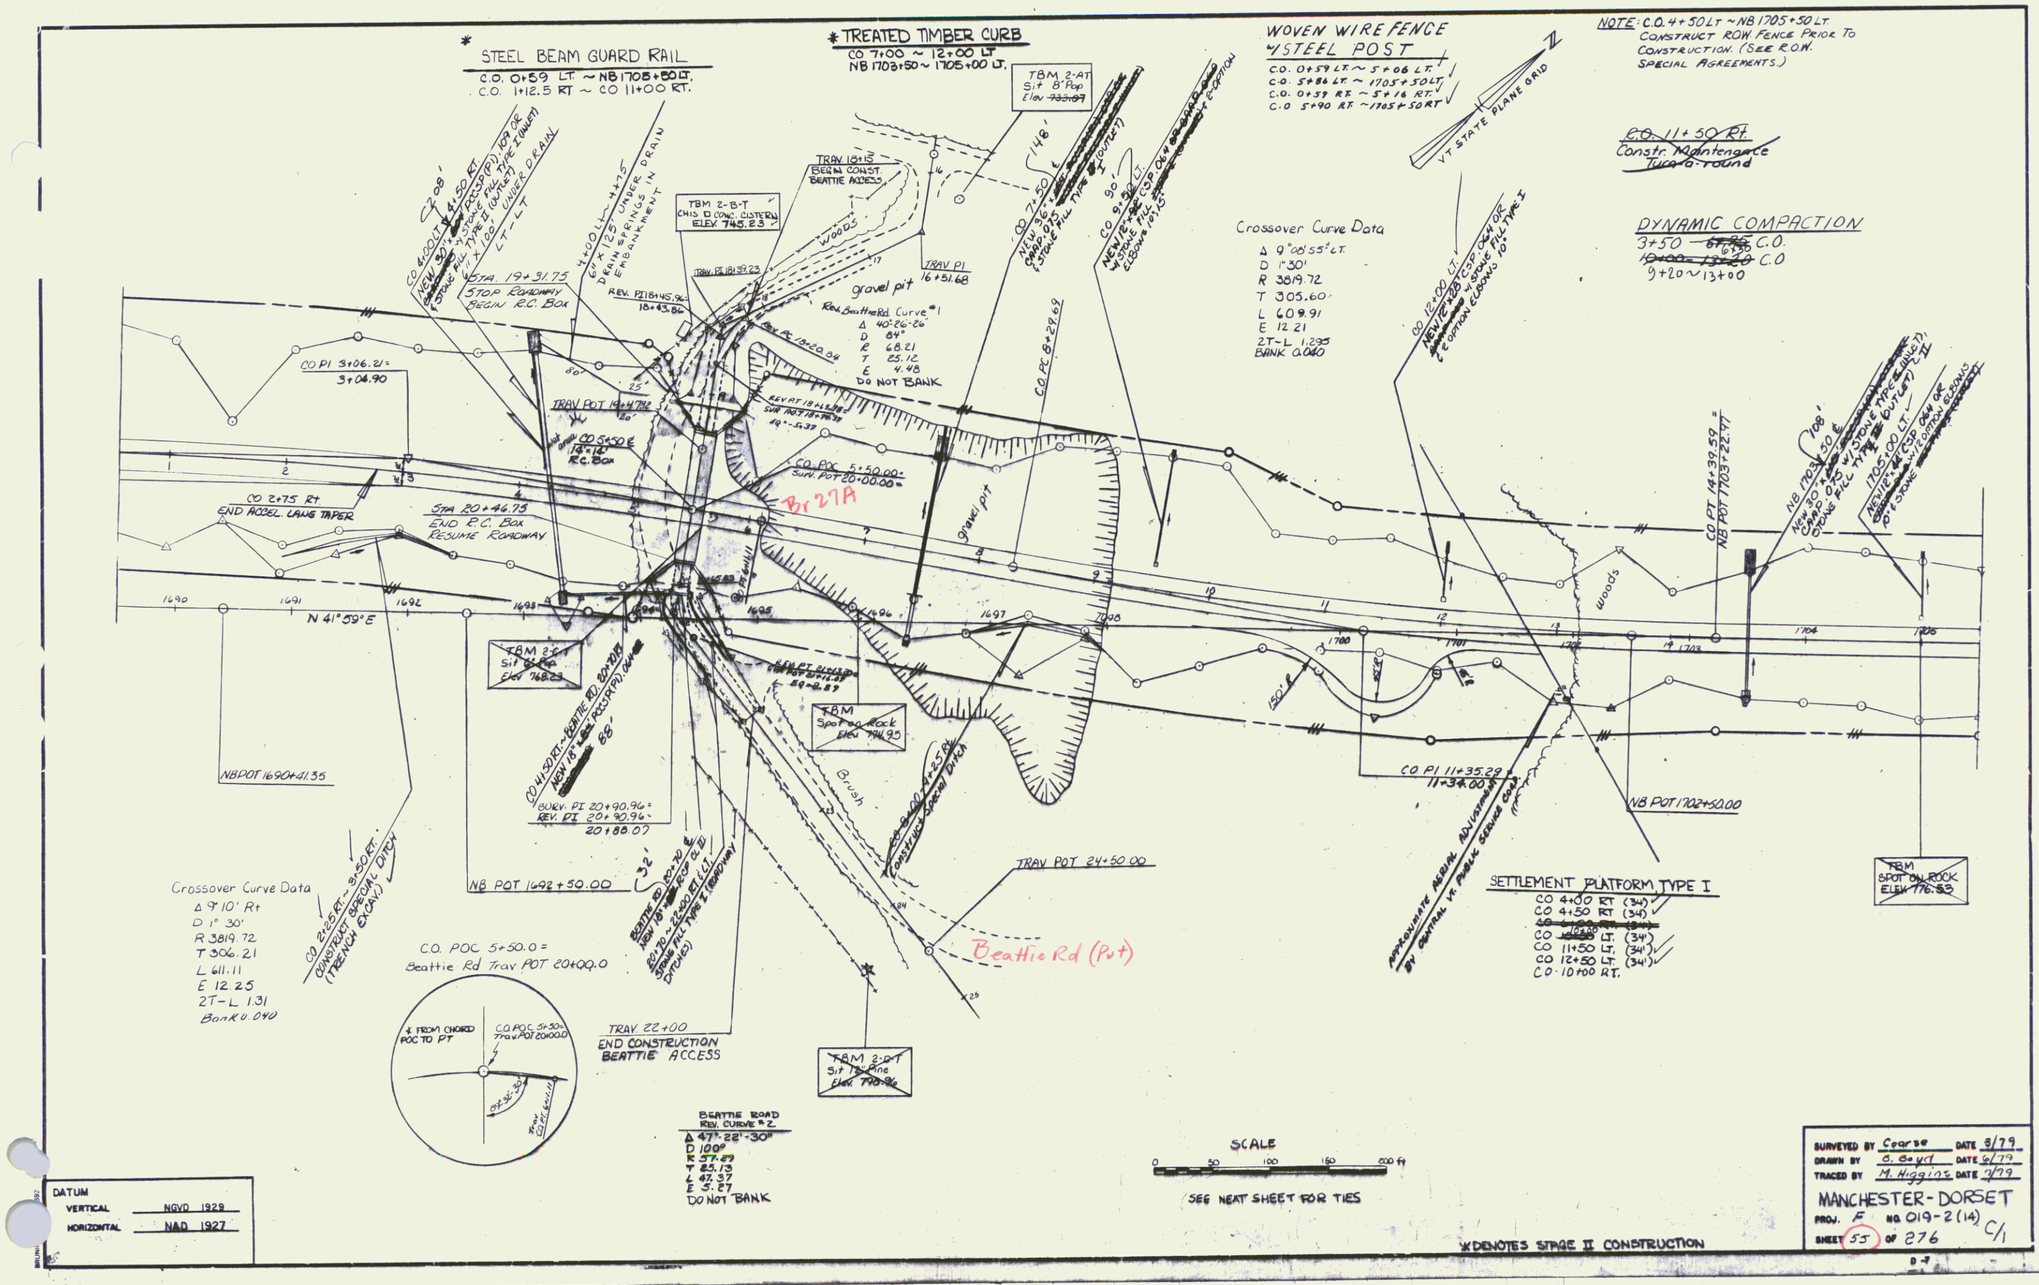

SEP 1 2 1994

80