


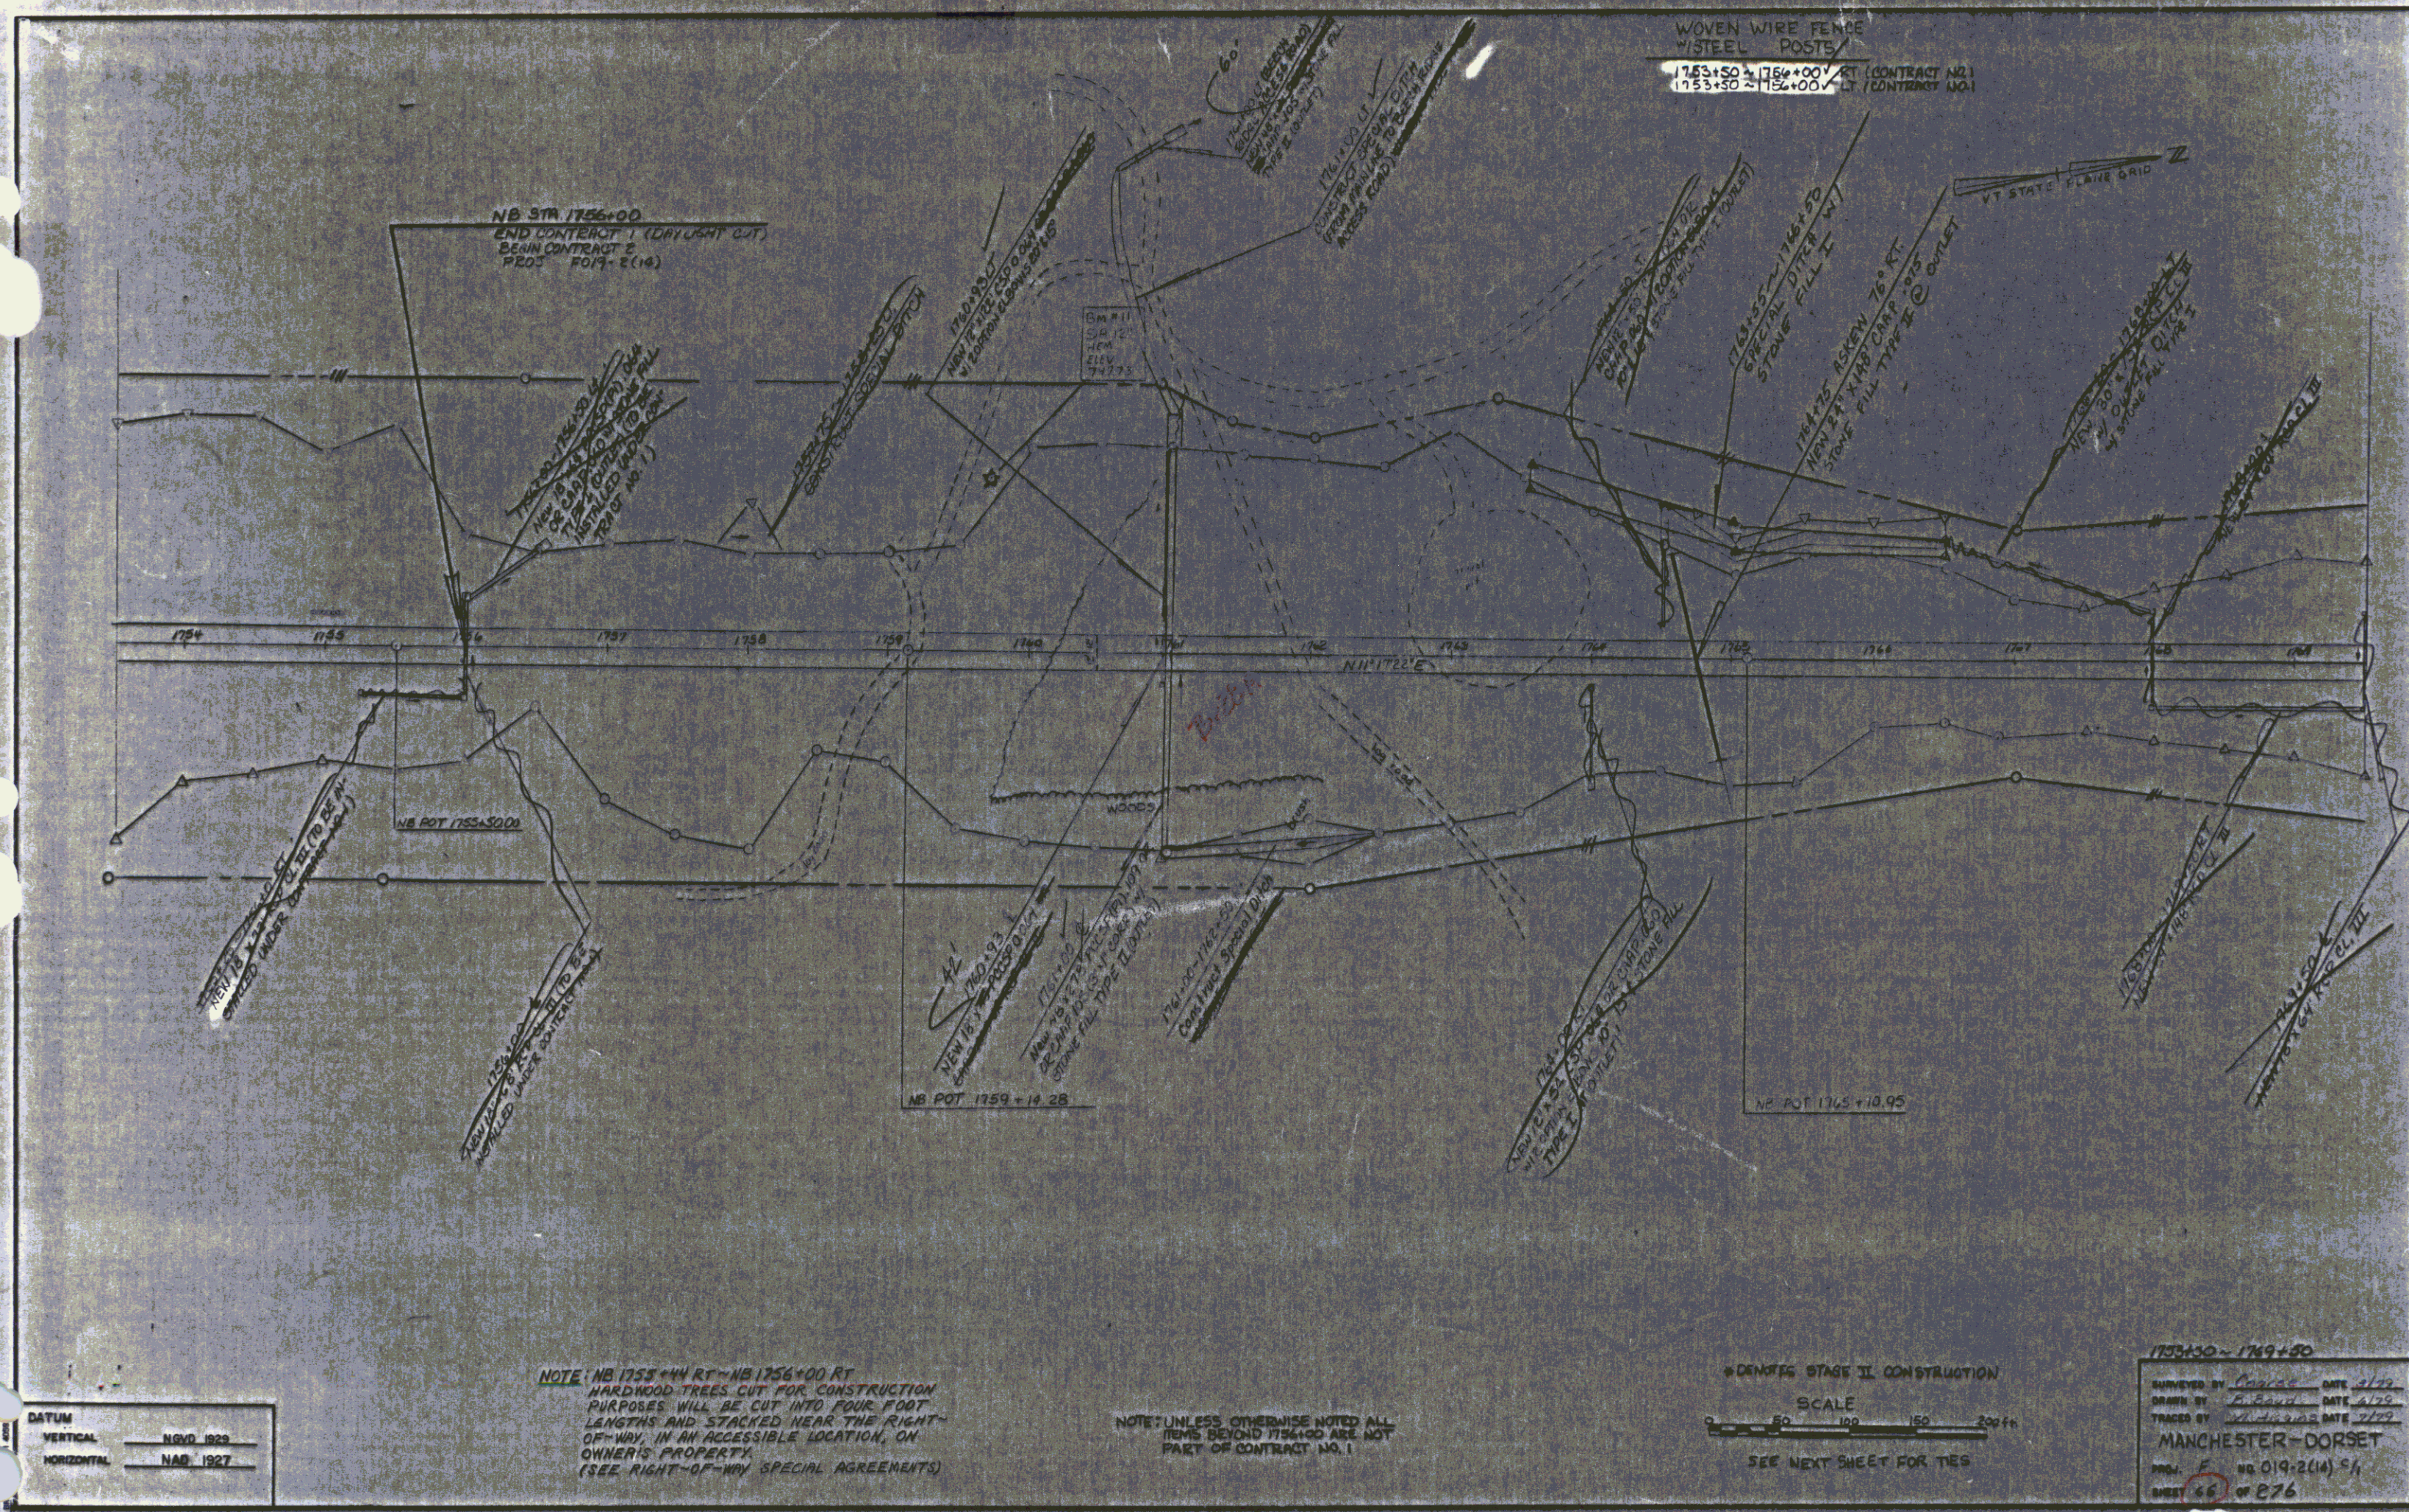

DATUM
VERTICAL NAD 1923
HORIZONTAL NAD 1927

NOTE: NB 1753+44 RT - NB 1756+00 RT
HARDWOOD TREES CUT FOR CONSTRUCTION
PURPOSES WILL BE CUT INTO FOUR FOOT
LENGTHS AND STACKED NEAR THE RIGHT-
OF-WAY, IN AN ACCESSIBLE LOCATION, ON
OWNER'S PROPERTY.
(SEE RIGHT-OF-WAY SPECIAL AGREEMENTS)

NOTE: UNLESS OTHERWISE NOTED ALL
ITEMS BEYOND 1756+00 ARE NOT
PART OF CONTRACT NO. 1

• DENOTES STAGE II CONSTRUCTION
SCALE
0 50 100 150 200 ft
SEE NEXT SHEET FOR TIES

1753+30 - 1769+30
SURVEYED BY Carroll DATE 5/22
DRAWN BY F. B. B. DATE 5/22
TRACED BY W. H. B. DATE 5/22
MANCHESTER-DORSET
PROJ. F NO. 019-2(14) S
SHEET 66 OF 876
0-2