

SLOPE BENCHING
1793+25 - 1800+75 RT.

Erosion Matting


1788+50	1790+90 RT
1788+50	1790+90 LT
1791+00	1793+40 RT
1791+00	1793+40 LT
1794+00	1796+40 RT
1794+00	1796+40 LT
1796+50	1798+50 RT
1796+50	1798+50 LT
1799+00	1801+50 RT
1799+00	1801+50 LT
1790+90	1794+15 RT

WOVEN WIRE FENCE
W/ STEEL POSTS

1785+00	1786+20 LT
1786+00	1801+50 LT
1785+00	1786+20 RT
1786+00	1801+50 RT

* DENOTES STAGE II CONSTRUCTION

DRILLING AND BLASTING
OF SOLID ROCK SUBGRADE
1799+95 - 1801+50
50

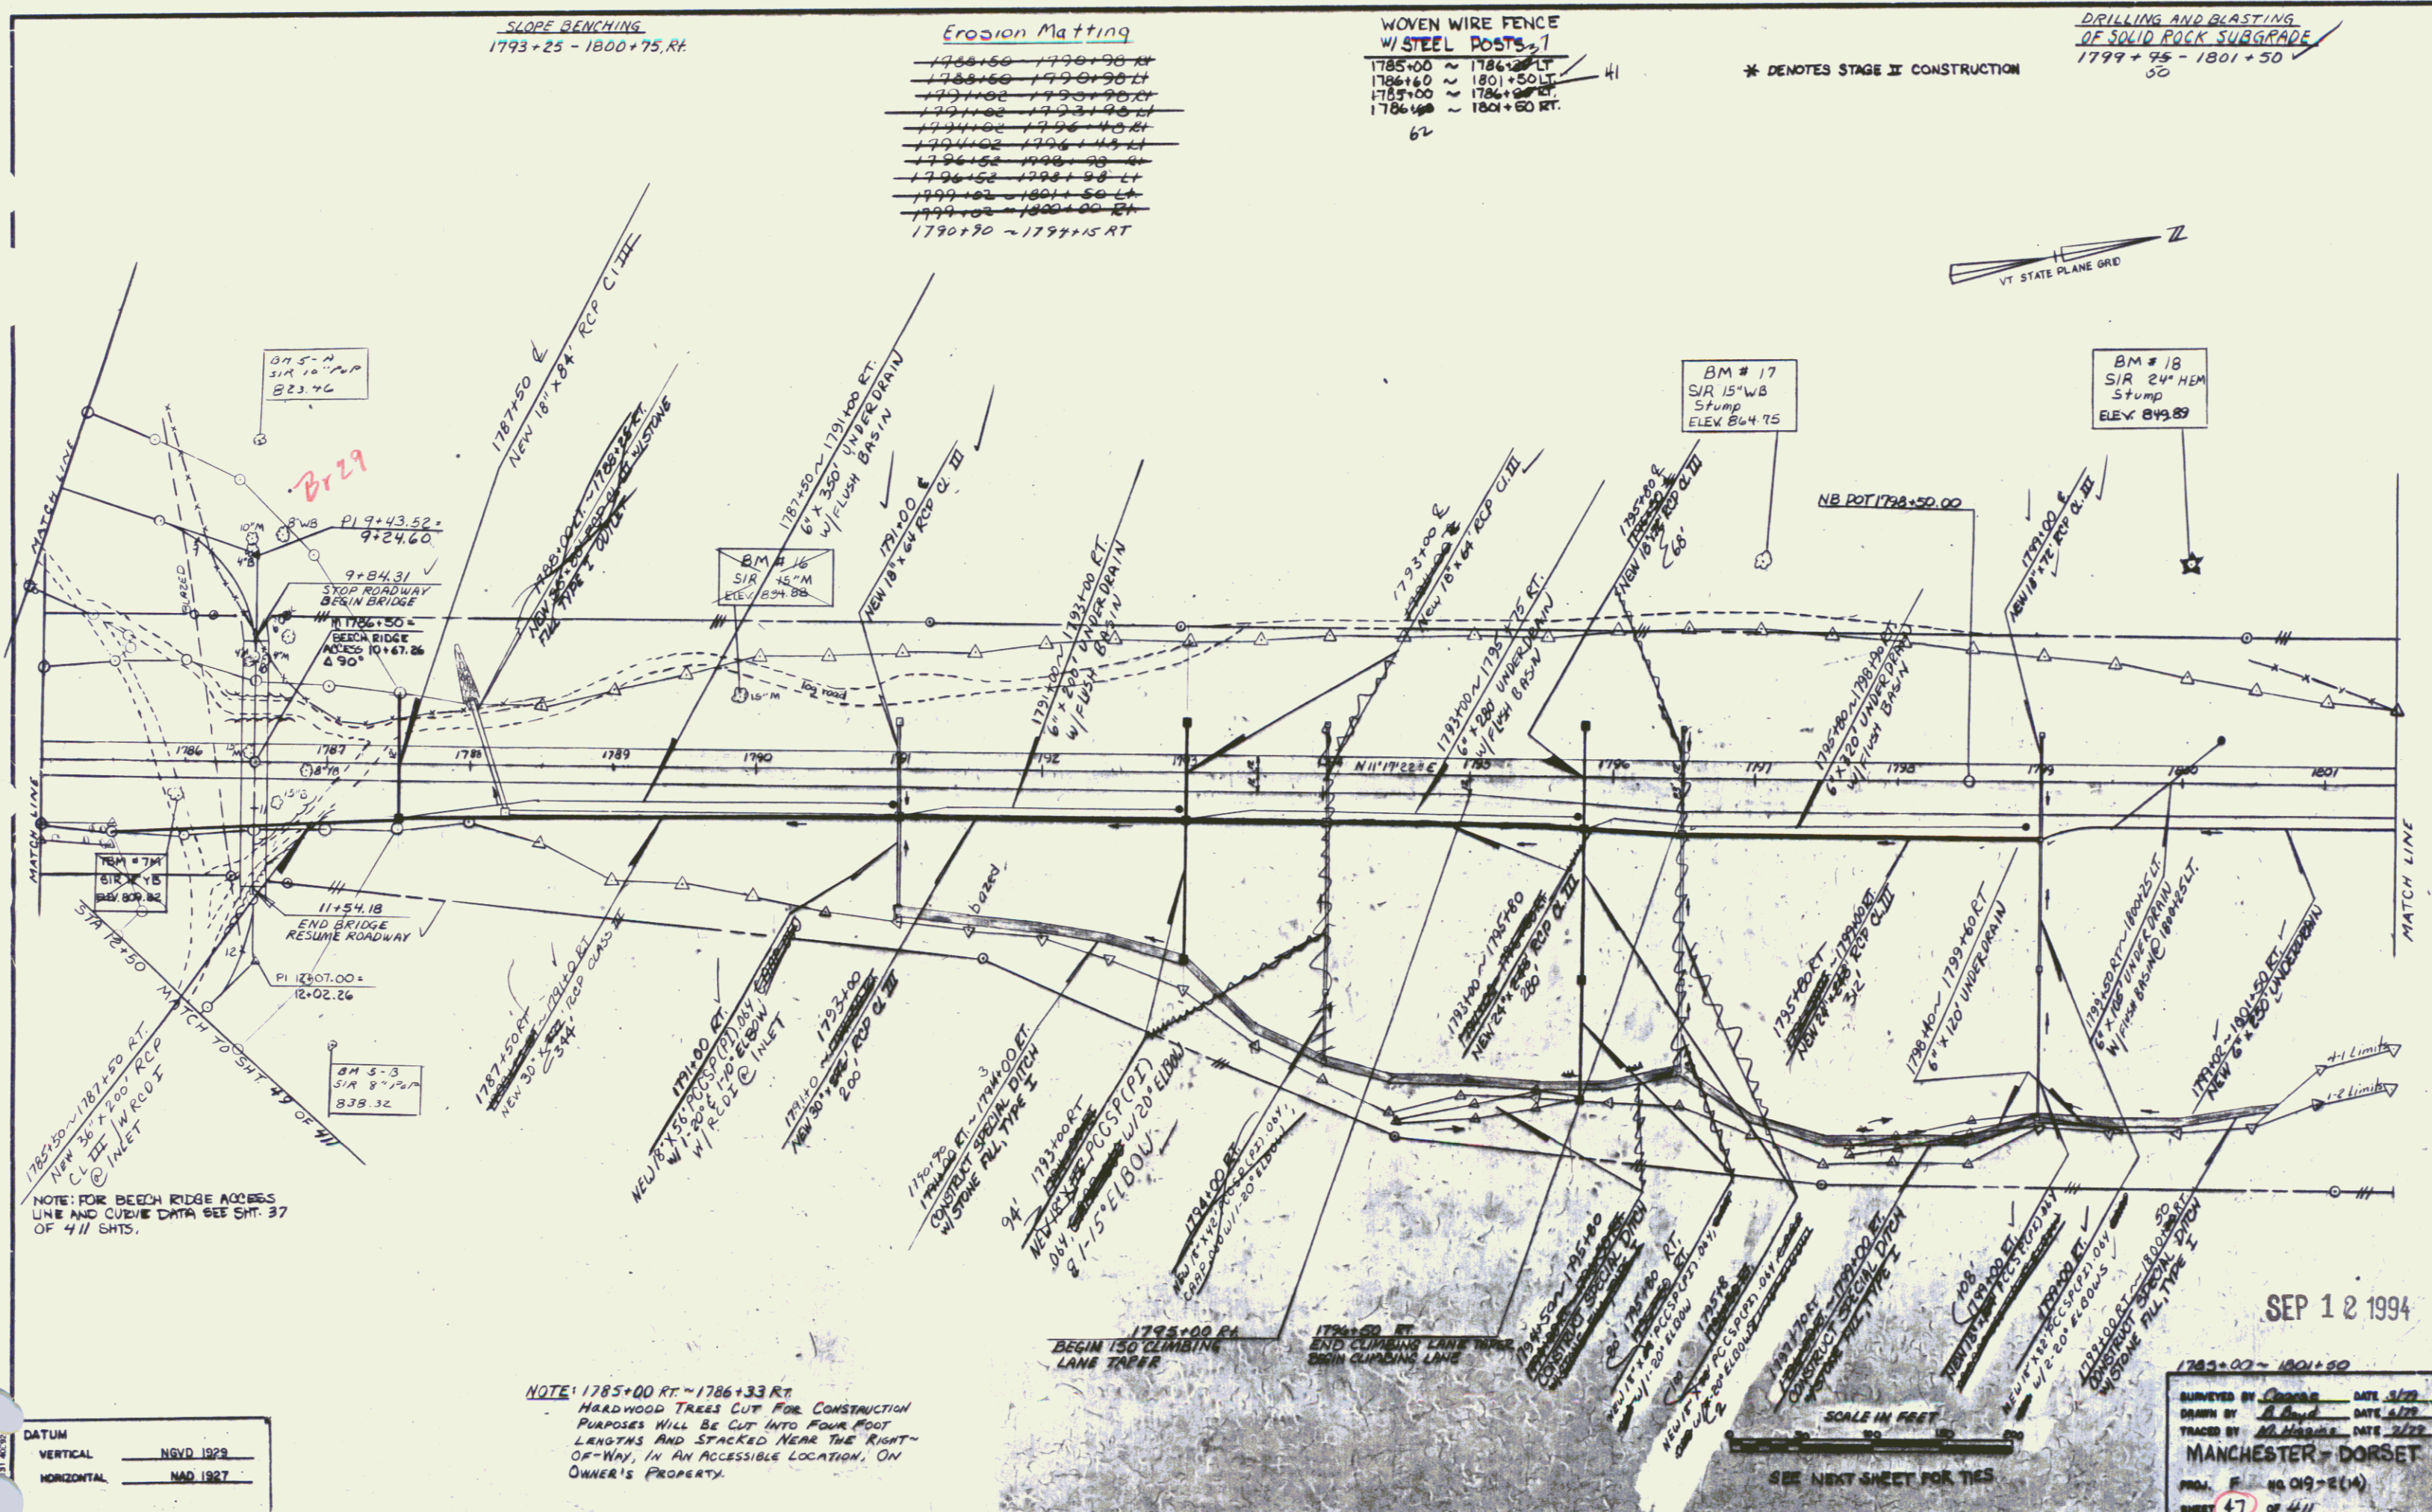

NOTE: FOR BEECH RIDGE BRIDGE
LINE AND CURVE DATA SEE SHEET 37
OF 411 SHEETS.

NOTE: 1785+00 RT - 1786+33 RT
HARDWOOD TREES CUT FOR CONSTRUCTION
PURPOSES WILL BE CUT INTO FOUR FOOT
LENGTHS AND STACKED NEAR THE RIGHT-
OF-WAY, IN AN ACCESSIBLE LOCATION, ON
OWNER'S PROPERTY.

DATUM

VERTICAL	NGVD 1929
HORIZONTAL	NAD 1927

SCALE IN FEET
0 50 100
SEE NEXT SHEET FOR TIES

1785+00 - 1801+50

DESIGNED BY	DATE 3/92
DRAWN BY	DATE 3/92
TRACED BY	DATE 2/92
MANCHESTER - DORSET	
PROJ. #	40 019-2(14)
SHEET	47 of 411