



DRILLING AND BLASTING
OF SOLID ROCK SUBGRADE
1834+00 - 1834+75 1836+00
1835+25 - 1844+25
1836+50 - 1850+00

* TREATED TIMBER CURB
1834+00 ~ 1850+00 LT.

* STEEL BEAM GUARD RAIL
1834+0 ~ 1850+0 LT

CONSTRUCT CONCRETE
SAFETY BARRIER
1838+69 ~ 1838+81 RT.
1841+43 ~ 1841+57 RT.
1843+44 ~ 1843+56 RT.
1845+42 ~ 1845+58 RT.
1846+14 ~ 1847+06 RT.

WOVEN WIRE FENCE
W/ STEEL POSTS
1834+00 ~ 1850+00 LT.
1834+00 ~ 1850+00 RT.

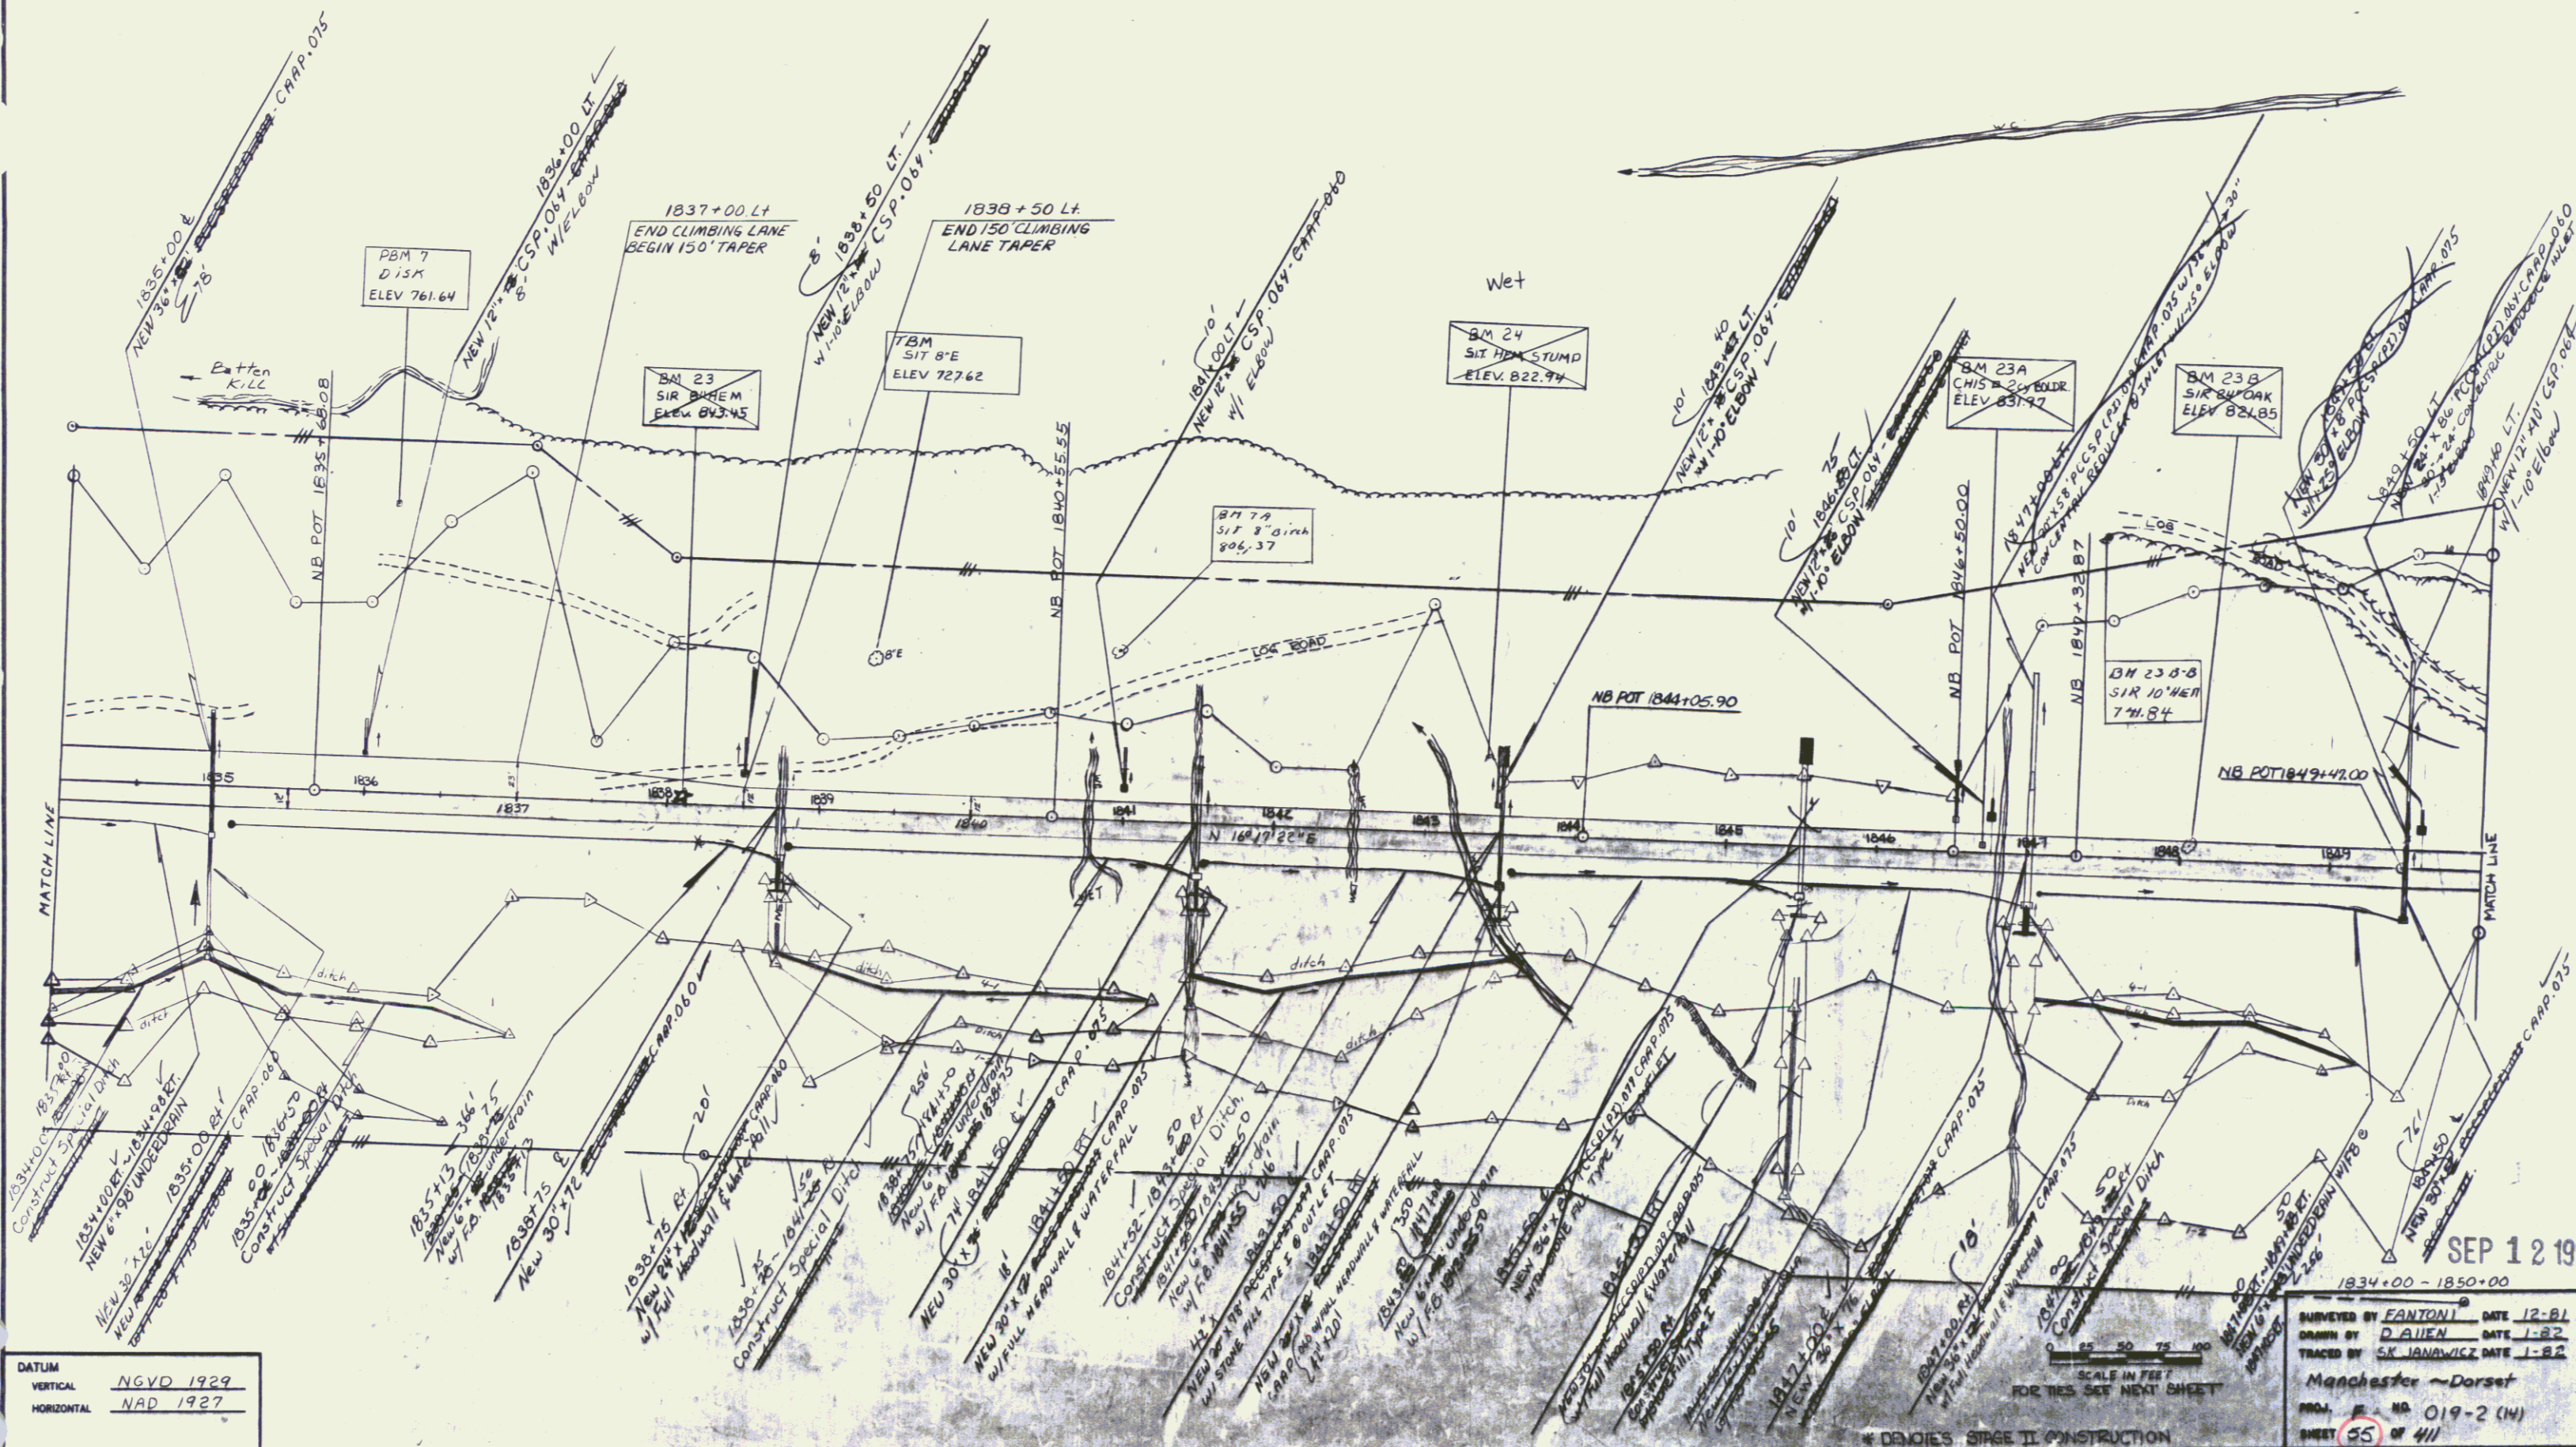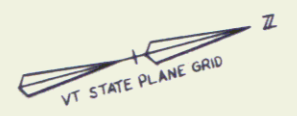

DATUM
VERTICAL NGVD 1929
HORIZONTAL NAD 1927

SCALE IN FEET
FOR RES SET NEXT SHEET

SEP 12 1994
1834+00 - 1850+00
SURVEYED BY FANTONI DATE 12-81
DRAWN BY D AIEN DATE 1-82
TRACED BY SK JANOWICZ DATE 1-82
Manchester - Dorset
PROJ. # NO 019-2 (14)
SHEET 55 OF 411