*STEEL BEAM GUARD RAIL
REV. 1867+25 RT. ~ REV. 1871+87.5 RT.
REV. 1866+10 LT. ~ REV. 1872+50 LT.

*TREATED TIMBER CURB
REV. 1866+10 LT. ~ REV. 1871+22 LT.

WOVEN WIRE FENCE
W/ STEEL POSTS
~~REV. 1866+10 ~ REV. 1870+44 LT.~~
~~REV. 1870+93 ~ REV. 1881+50 LT.~~
~~REV. 1866+10 ~ REV. 1870+52 RT.~~
~~REV. 1870+93 ~ REV. 1881+50 RT.~~
1866+10 ~ 1870+52 RT.
1870+93 ~ 1881+50 RT.
1866+10 ~ 1870+43 LT.
1870+95 ~ 1881+50 LT.
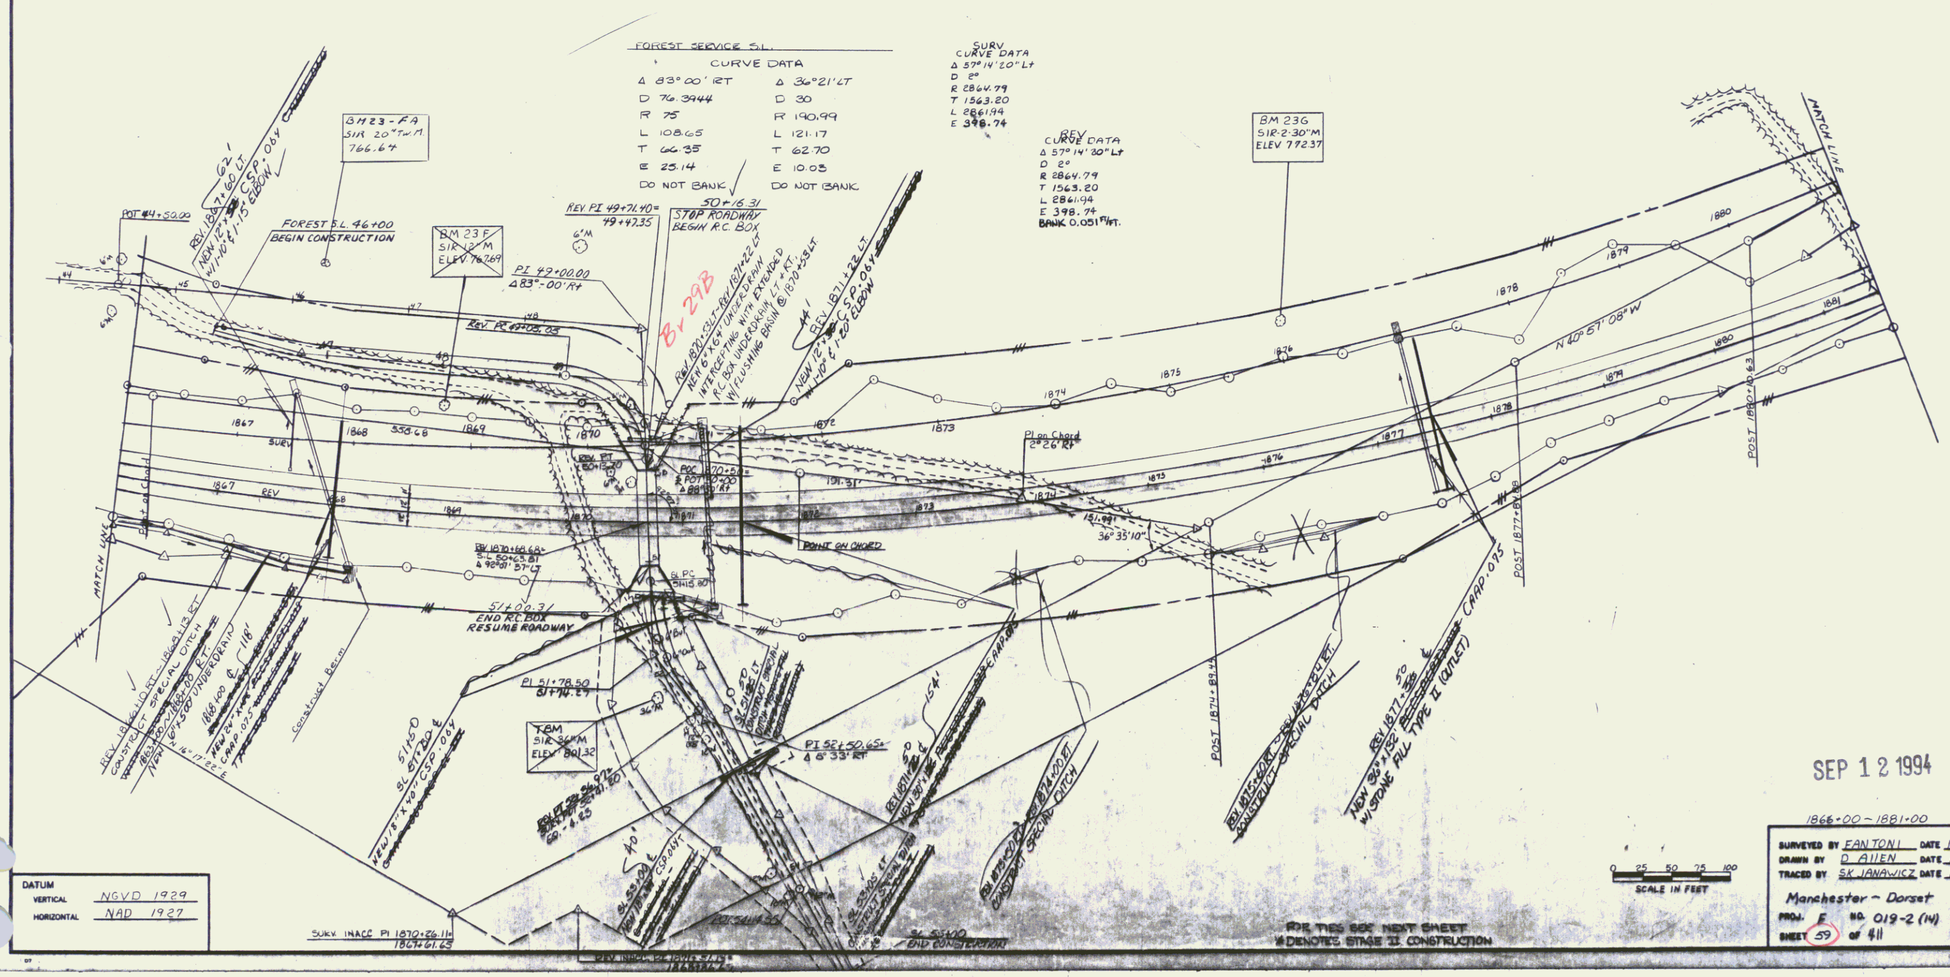
VT STATE PLANE GRID
N