WEST R.O.W.

POINT #	NORTH	EAST	BEARING	DIST.
B 71 A	461677.86	354464.86		
			S04°-05'-51" E	857.03
B 72	460823.02	354526.10		
			ON 2914.29' RADIUS CURVE	404.37
B 72 A	460422.98	354582.84		
			S12°-02'-53" E	373.27
B 73	460057.96	354660.75		

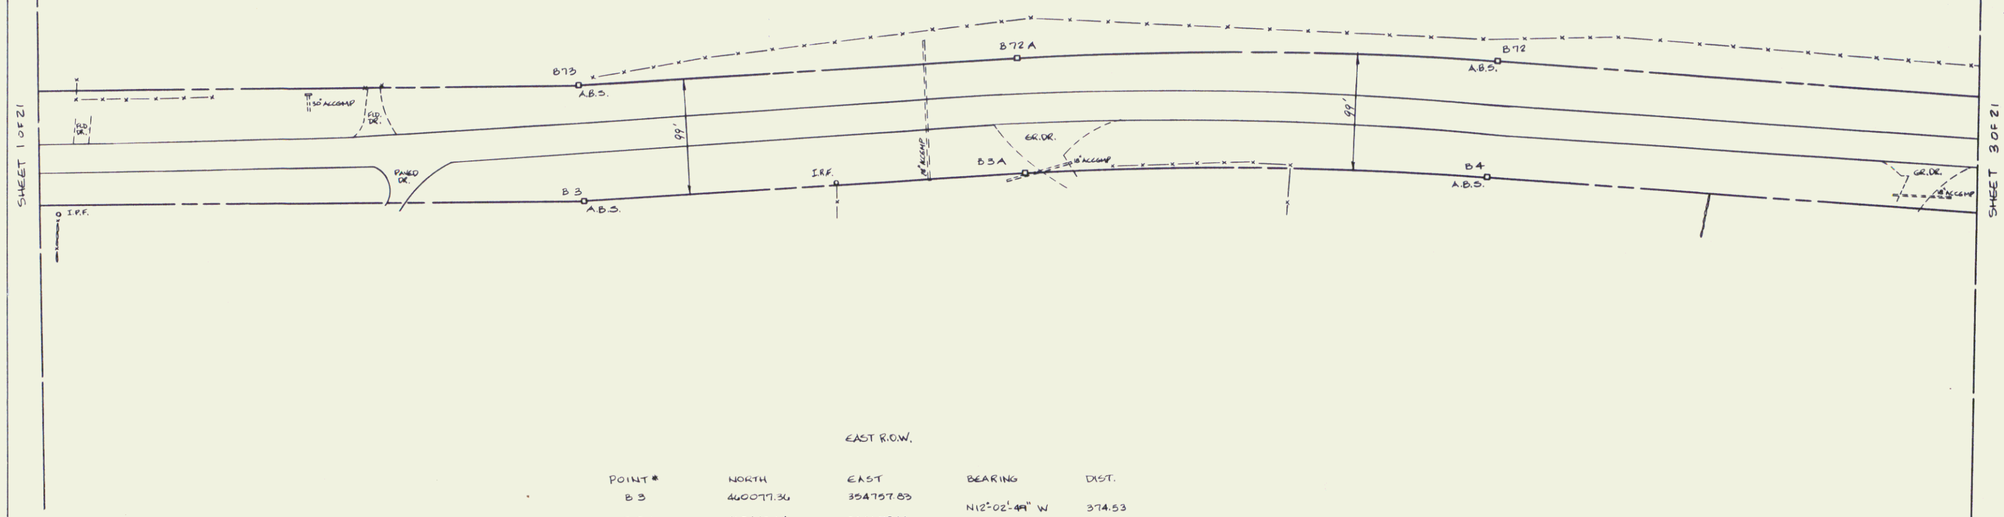

EAST R.O.W.

POINT #	NORTH	EAST	BEARING	DIST.
B 3	460077.36	354757.83		
			N12°-02'-49" W	374.53
B 3 A	460443.64	354679.66		
			ON 2815.29' RADIUS CURVE	390.63
B 4	460830.10	354624.85		
			N04°-05'-51" W	857.03
B 4 A	461684.94	354563.61		

ALL BEARINGS ARE REFERENCED TO THE VERMONT STATE PLANE COORDINATE SYSTEM.

50 0 50 100 150 200
SCALE IN FEET

100' R.O.W

STATE OF VERMONT
US ROUTE 7 RIGHT-OF-WAY
BRANDON FEGC F 019-5(29)

VERMONT SURVEY CONSULTANTS, INC.
58 EAST STATE ST.
MONTPELIER, VT.

DATE:	SCALE:	SHEET:
JULY 1989	1" = 50'	2 OF 21

3