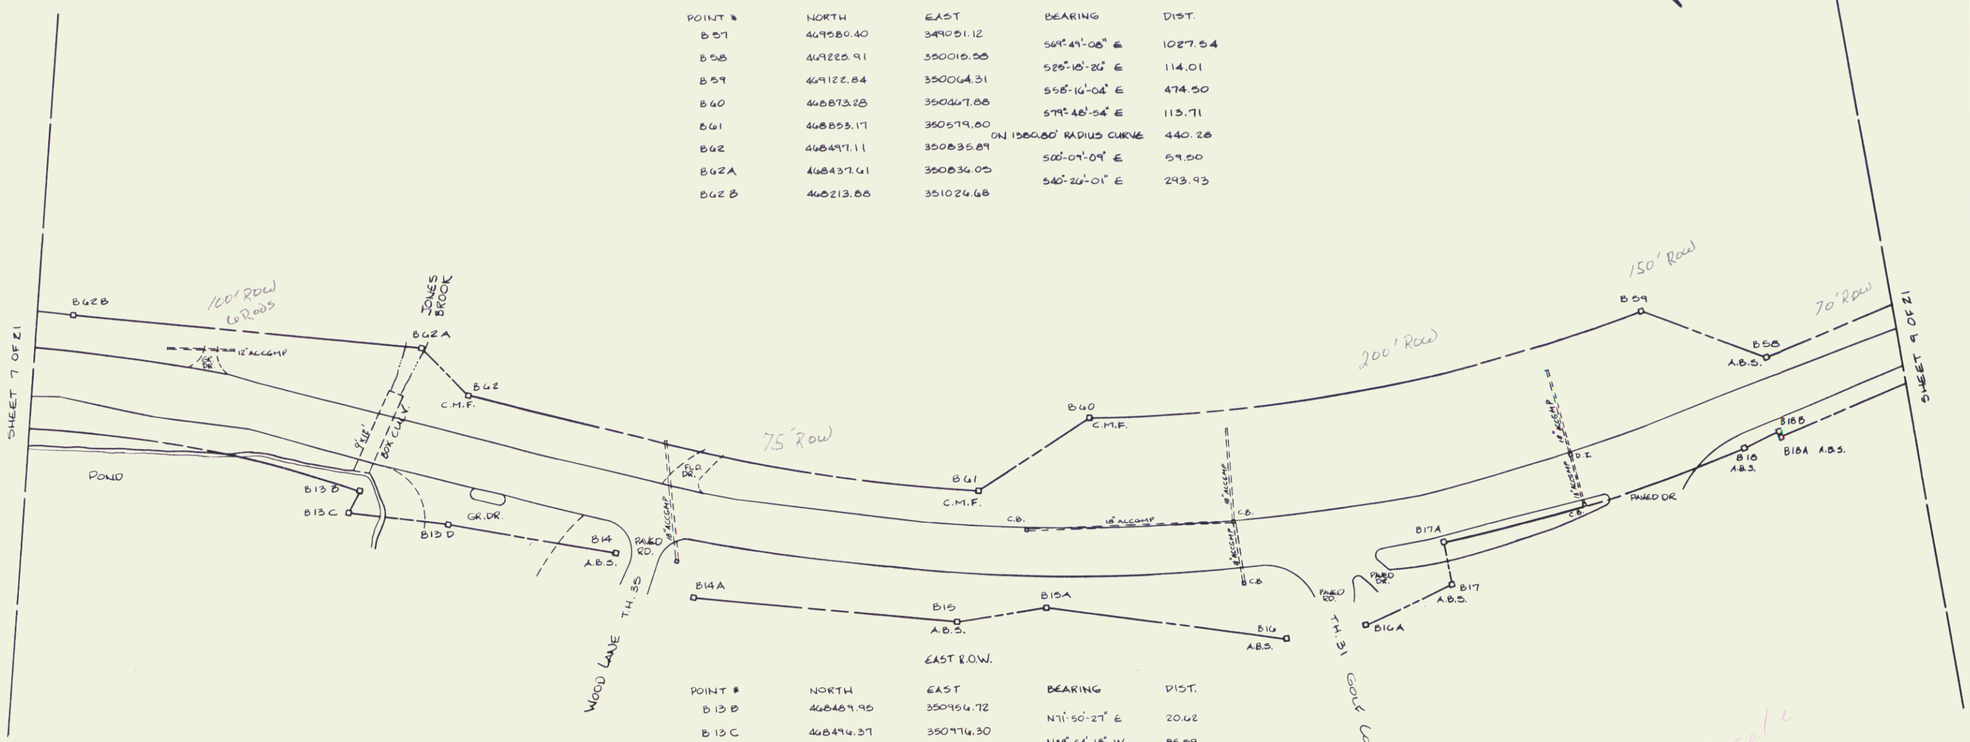

WEST R.O.W.

POINT #	NORTH	EAST	BEARING	DIST.
B57	469580.40	349051.12		
			S69°-49'-08" E	1027.54
B58	469228.91	350015.58		
			S20°-18'-26" E	114.01
B59	469122.84	350064.31		
			S58°-16'-04" E	474.50
B60	468873.28	350467.88		
			S79°-48'-54" E	113.71
B61	468853.17	350579.80		
			ON 1380.80' RADIUS CURVE	440.28
B62	468497.11	350835.89		
			S00°-09'-09" E	59.50
B62A	468437.61	350836.05		
			S40°-26'-01" E	293.93
B62B	468213.88	351024.68		

EAST R.O.W.

POINT #	NORTH	EAST	BEARING	DIST.
B13B	468489.98	350956.72		
			N71°-50'-27" E	20.62
B13C	468496.37	350976.30		
			N58°-54'-18" W	85.59
B13D	468542.98	350922.55		
			N36°-35'-38" W	143.42
B14	468678.13	350837.05		
			N15°-54'-17" W	76.29
B14A	468751.49	350816.15		
			N40°-56'-30" W	227.03
B15	468922.99	350667.38		
			N56°-34'-14" W	74.25
B15A	468963.89	350605.41		
			N39°-14'-17" W	205.80
B16	469123.29	350475.23		
			N60°-04'-06" W	77.17
B16A	469161.79	350408.36		
			N68°-43'-17" W	71.76
B17	469187.83	350341.49		
			S30°-22'-11" W	37.00
B17A	469155.91	350322.78		
			ON 1463.80' RADIUS CURVE	268.22
B18	469269.61	350080.28		
			N70°-07'-43" W	31.78
B18B	469280.42	350050.39		
			N19°-52'-17" E	5.00
B18A	469285.12	350052.09		
			N69°-56'-18" W	1041.39
B19	469442.35	349073.89		

50 0 50 100 150 200

SCALE IN FEET

ALL BEARINGS ARE REFERENCED TO THE VERMONT STATE PLANE COORDINATE SYSTEM.

STATE OF VERMONT
US ROUTE 7 RIGHT-OF-WAY
BRANDON FEGC F 019-5 (29)

VERMONT SURVEY CONSULTANTS, INC.
58 EAST STATE ST.
MONTPELIER, VT.

DATE:	SCALE:	SHEET:
JULY 1989	1" = 50'	8 OF 21