WEST R.O.W.

POINT #	NORTH	EAST	BEARING	DIST.
B48	477074.11	341407.28	S31°-38'-00" E	449.35
B48 A	476691.54	341642.97	S30°-59'-11" E	68.79
B48 B	476632.56	341678.38	S30°-49'-13" E	63.91
B48 C	476577.68	341711.12	S30°-39'-25" E	67.01
B49	476520.03	341748.29	S30°-25'-00" E	149.78
B49A	476390.83	341821.05	S30°-11'-51" E	134.96
B50	476274.18	341888.94	S30°-44'-00" E	450.60
B50A	475904.06	342109.00	S31°-16'-21" E	622.00
B51	475372.43	342431.89		

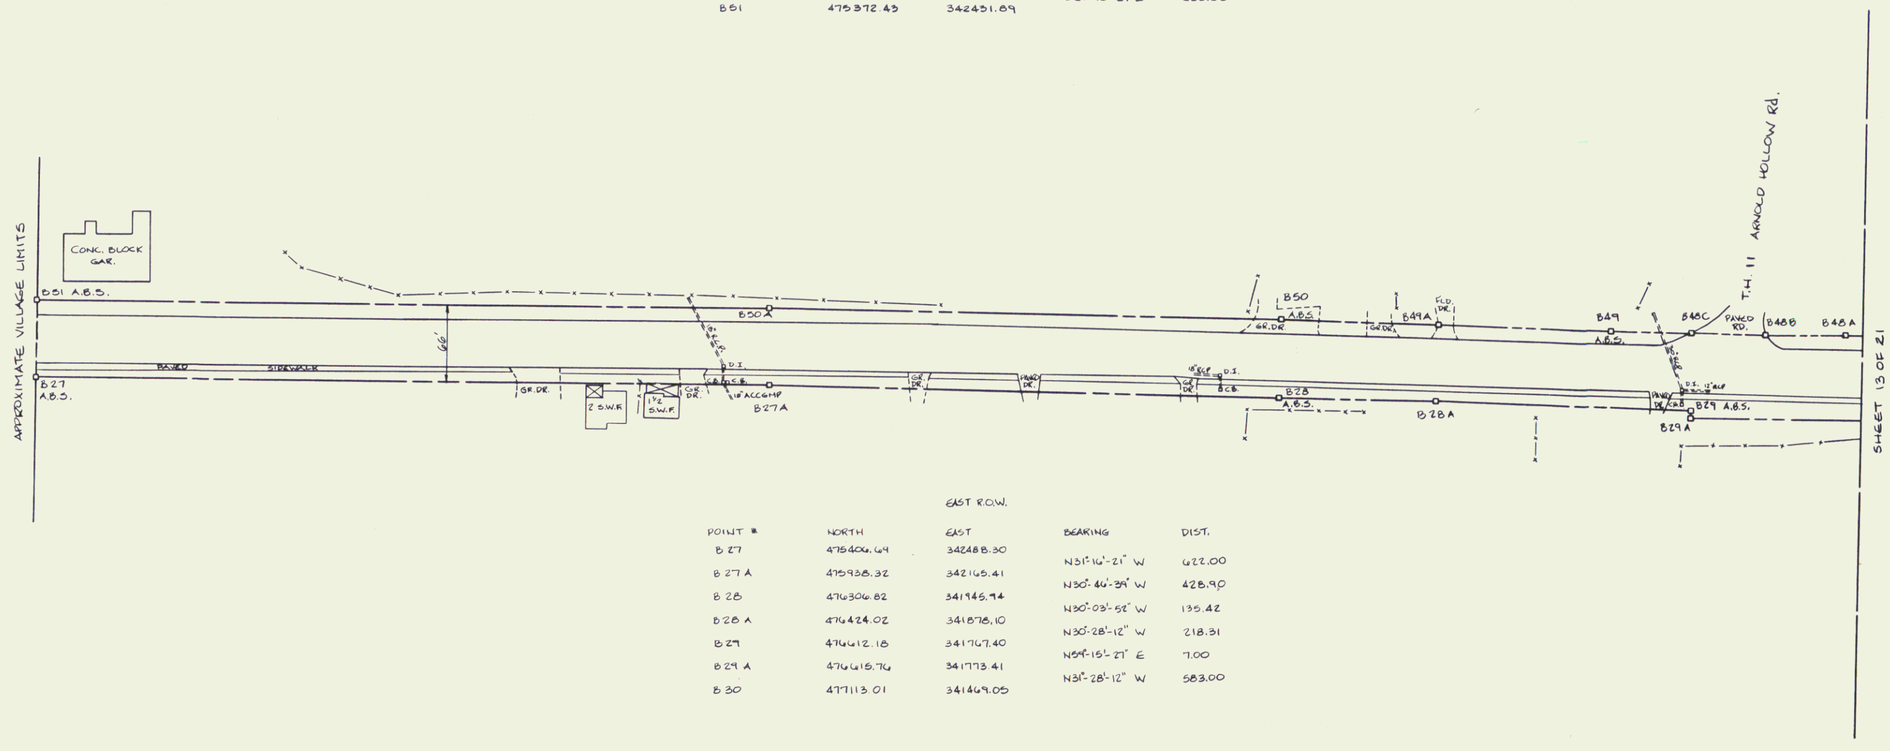

EAST R.O.W.

POINT #	NORTH	EAST	BEARING	DIST.
B 27	475400.64	342488.30	N31°-16'-21" W	622.00
B 27 A	475938.32	342165.41	N30°-46'-39" W	428.90
B 28	476306.82	341945.94	N30°-03'-58" W	135.42
B 28 A	476424.02	341878.10	N30°-28'-12" W	218.31
B 29	476612.18	341767.40	N54°-15'-27" E	7.00
B 29 A	476615.76	341773.41	N31°-28'-12" W	583.00
B 30	477113.01	341469.05		

ALL BEARINGS ARE REFERENCED TO THE VERMONT STATE PLANE COORDINATE SYSTEM.

50 0 50 100 150 200
SCALE IN FEET

STATE OF VERMONT
US ROUTE 7 RIGHT-OF-WAY
BRANDON FEGC F 019-3 (29)

VERMONT SURVEY CONSULTANTS, INC.
58 EAST STATE ST.
MONTPELIER, VT.

DATE:	SCALE:	SHEET:
JULY 1989	1" = 50'	12 OF 21

13