WEST R.O.W.

POINT #	NORTH	EAST	BEARING	DIST.
B43	479679.80	340616.24	S02°-56'-55" E	1130.83
B44	478550.46	340674.40		

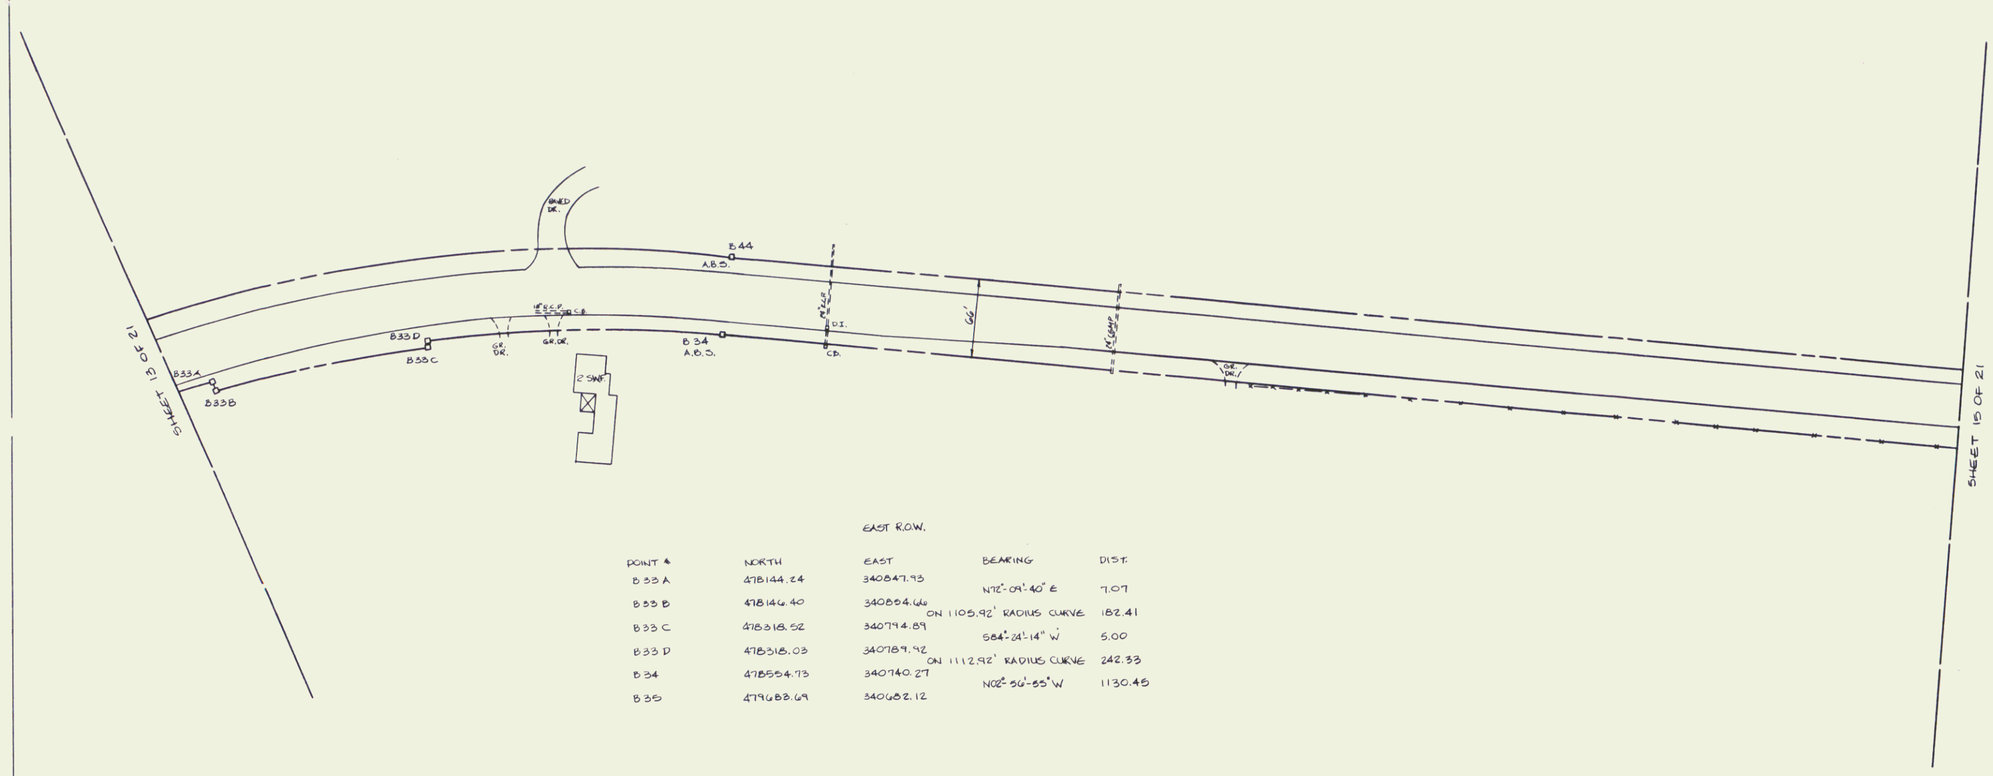

EAST R.O.W.

POINT #	NORTH	EAST	BEARING	DIST.
B33A	478144.24	340847.93	N72°-09'-40" E	7.07
B33B	478146.40	340854.66	ON 1105.92' RADIUS CURVE	182.41
B33C	478318.52	340794.89	S84°-24'-14" W	5.00
B33D	478318.03	340789.92	ON 1112.92' RADIUS CURVE	242.33
B34	478554.73	340740.27	N02°-56'-55" W	1130.45
B35	479683.69	340682.12		

50 0 50 100 150 200

SCALE IN FEET

ALL BEARINGS ARE REFERENCED TO THE VERMONT STATE PLANE COORDINATE SYSTEM.

STATE OF VERMONT
U.S ROUTE 7 RIGHT-OF-WAY
BRANDON FEGC F 019-5(29)

VERMONT SURVEY CONSULTANTS, INC.
58 EAST STATE ST.
MONTPELIER, VT.

DATE:	SCALE:	SHEET:
JULY 1989	1" = 50'	14 OF 21

15