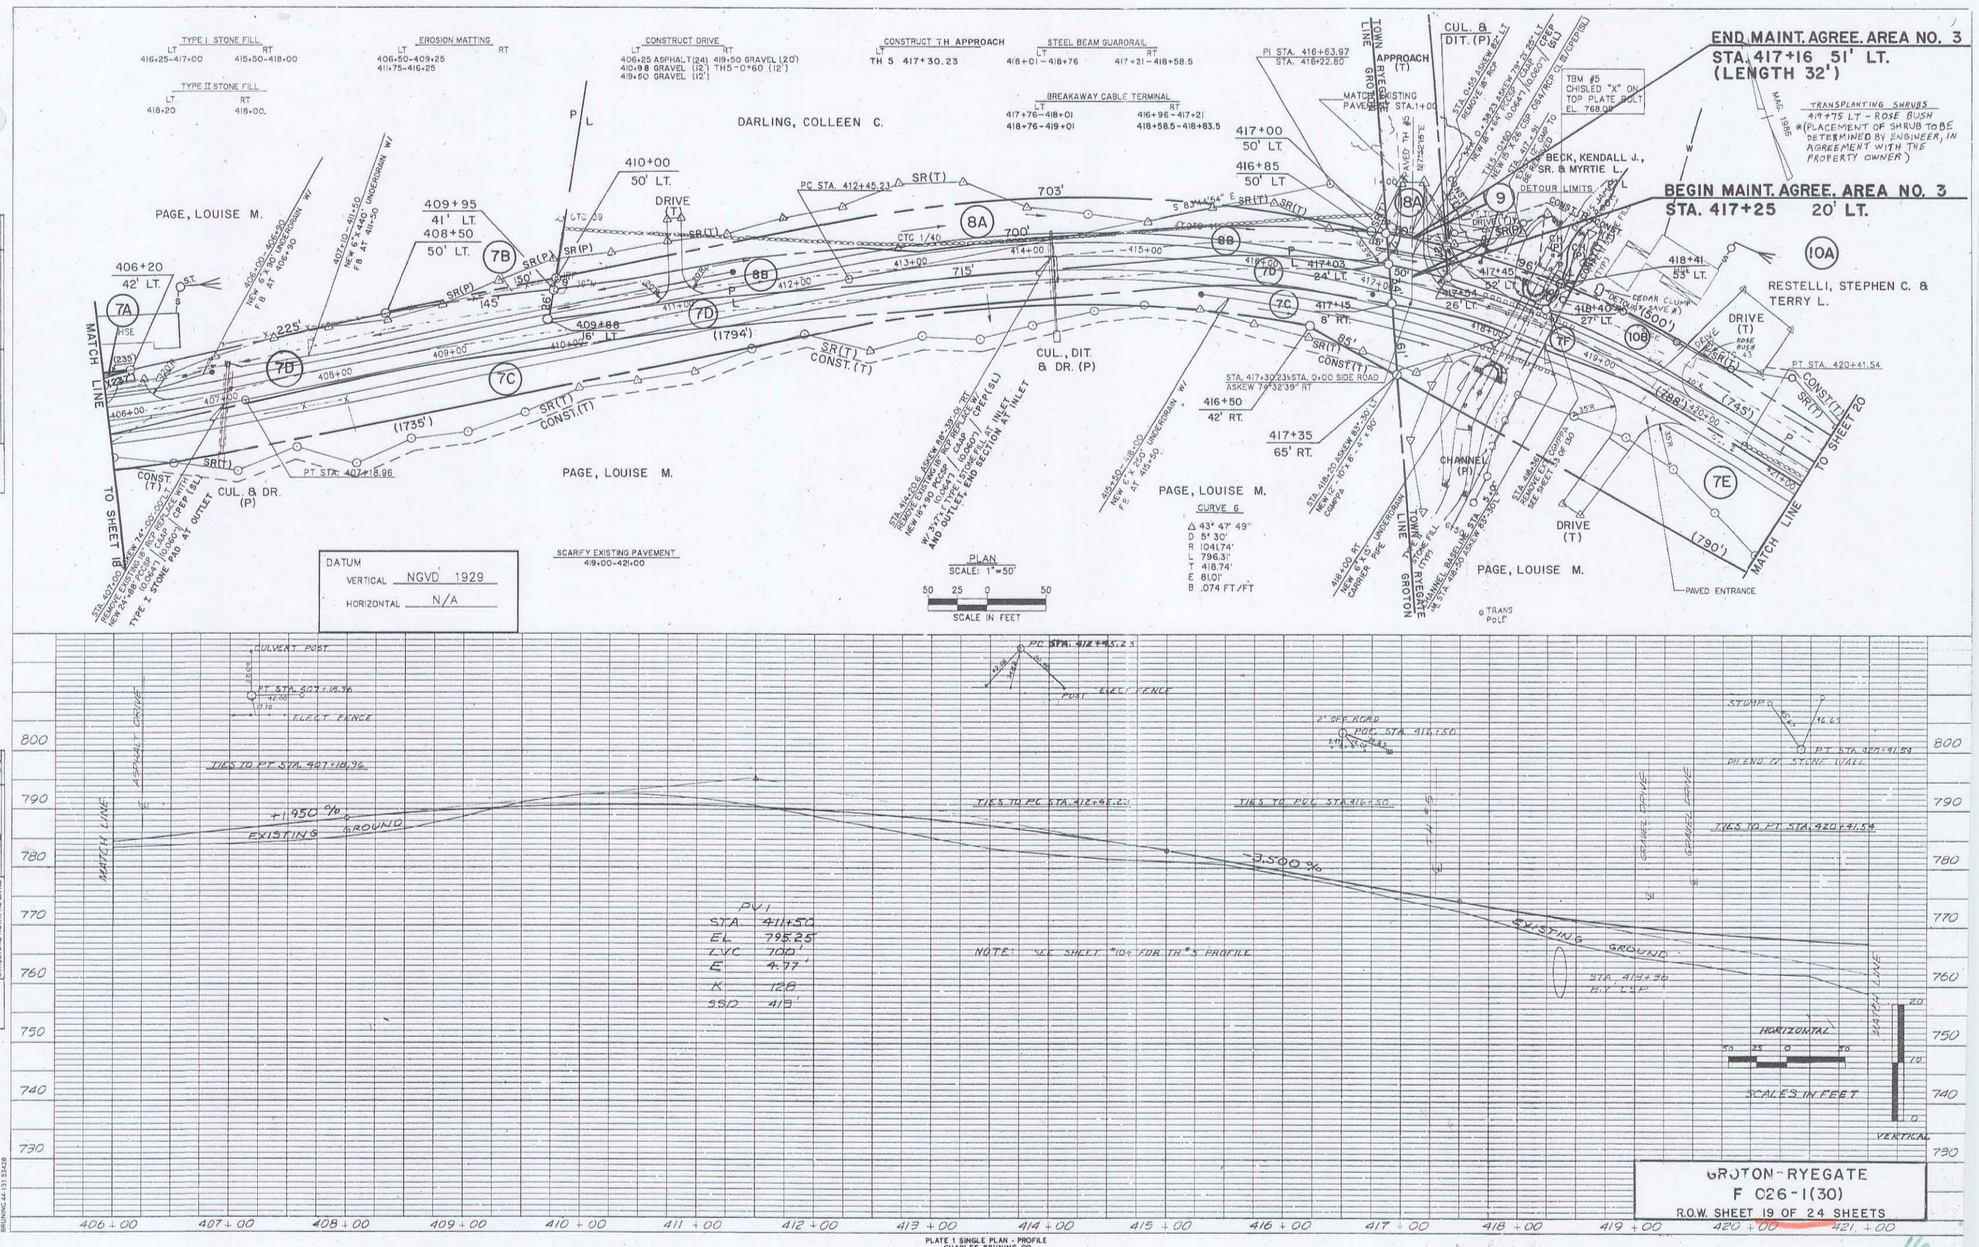

PLATE 1 SINGLE PLAN - PROFILE
CHARLES BRUNING CO.