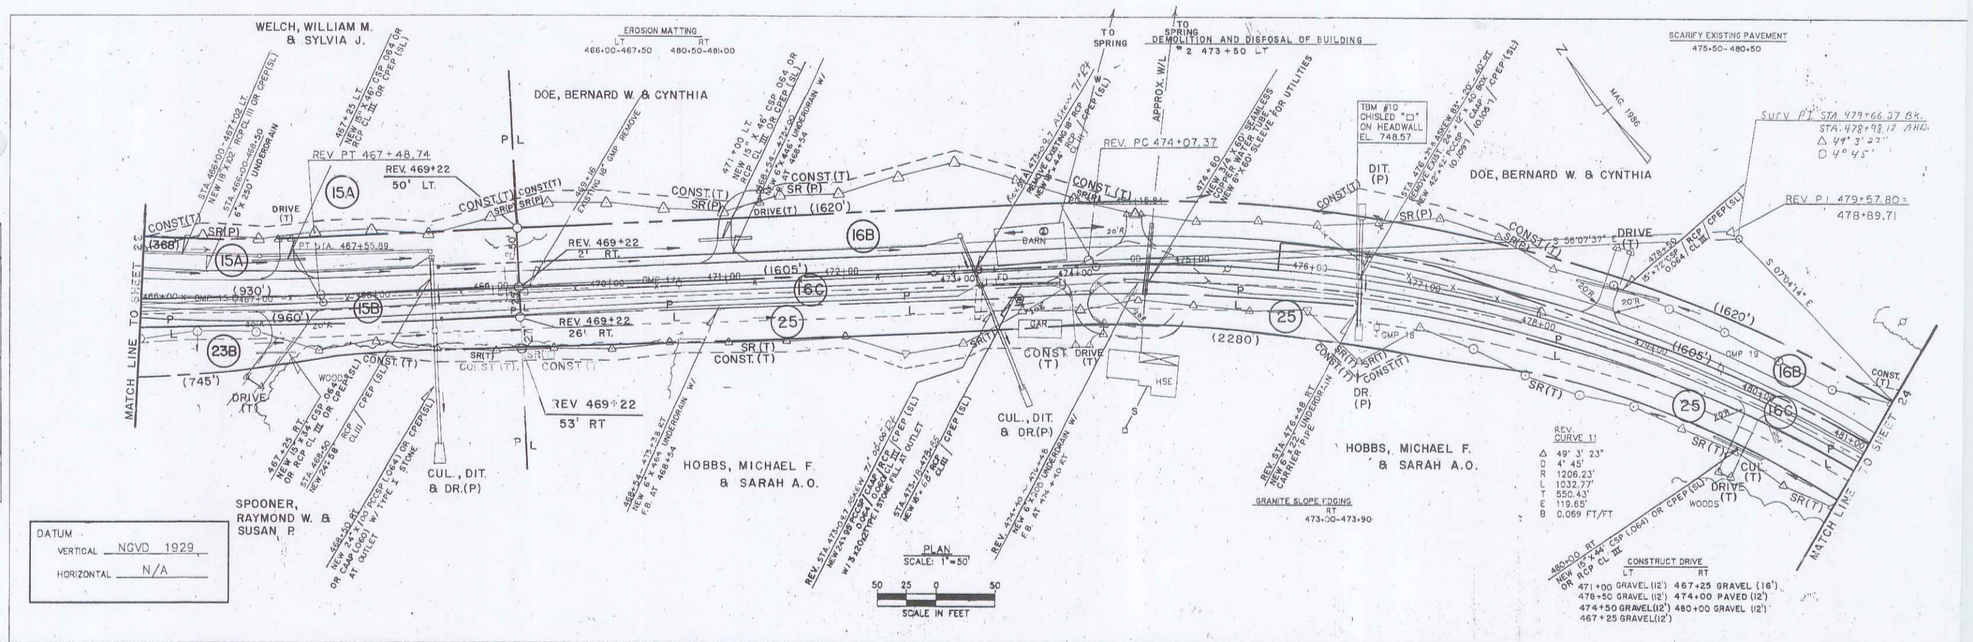
WELCH, WILLIAM M. & SYLVIA J.
DOE, BERNARD W. & CYNTHIA
HOBBS, MICHAEL F. & SARAH A.O.
SPOONER, RAYMOND W. & SUSAN P.
CUL., DIT. & DR.(P)
EROSION MATTING
DEMOLITION AND DISPOSAL OF BUILDING
SCARIFY EXISTING PAVEMENT
GRANITE SLOPE FACING
MATCH LINE TO SHEET 24
MATCH LINE TO SHEET 22
REV PT 467+48.74
REV. 469+22 50' LT.
REV. 469+22 21' RT.
REV. 469+22 26' RT.
REV 469+22 53' RT
REV. PC 474+07.37
REV. PI 479+57.80 = 478+89.71
Surv PI STA 479+66.37 BK.
TBM #10 CHISELED "□" ON HEADWALL EL. 748.57
DATUM
VERTICAL NGVD 1929
HORIZONTAL N/A
PLAN
SCALE: 1"=50'
SCALE IN FEET
REV. CURVE 1
Δ 49° 3' 23"
D 4° 45'
R 1206.23'
L 1032.77'
T 550.43'
E 119.65'
B 0.069 FT/FT
CONSTRUCT DRIVE
LT RT
471+00 GRAVEL (12') 467+25 GRAVEL (16')
478+50 GRAVEL (12') 474+00 PAVED (12')
474+50 GRAVEL(12') 480+00 GRAVEL (12')
467+25 GRAVEL(12')
PROFILE
EXISTING GROUND
PVI
STA 467+00
EL. 758.15
LVC 300'
E 0.60
K 1.87
PVI
STA 475+50
EL. = 751.40
LVC = 400'
E = 1.9
K = 1.5
HORIZONTAL
SCALES IN FEET
VERTICAL
GROTON RYEGATE
F 026-1(30)
ROW SHEET 23 OF 24 SHEETS
PLATE 1 SINGLE PLAN - PROFILE
CHARLES BRUNING CO.