POOR ORIGINAL COPY

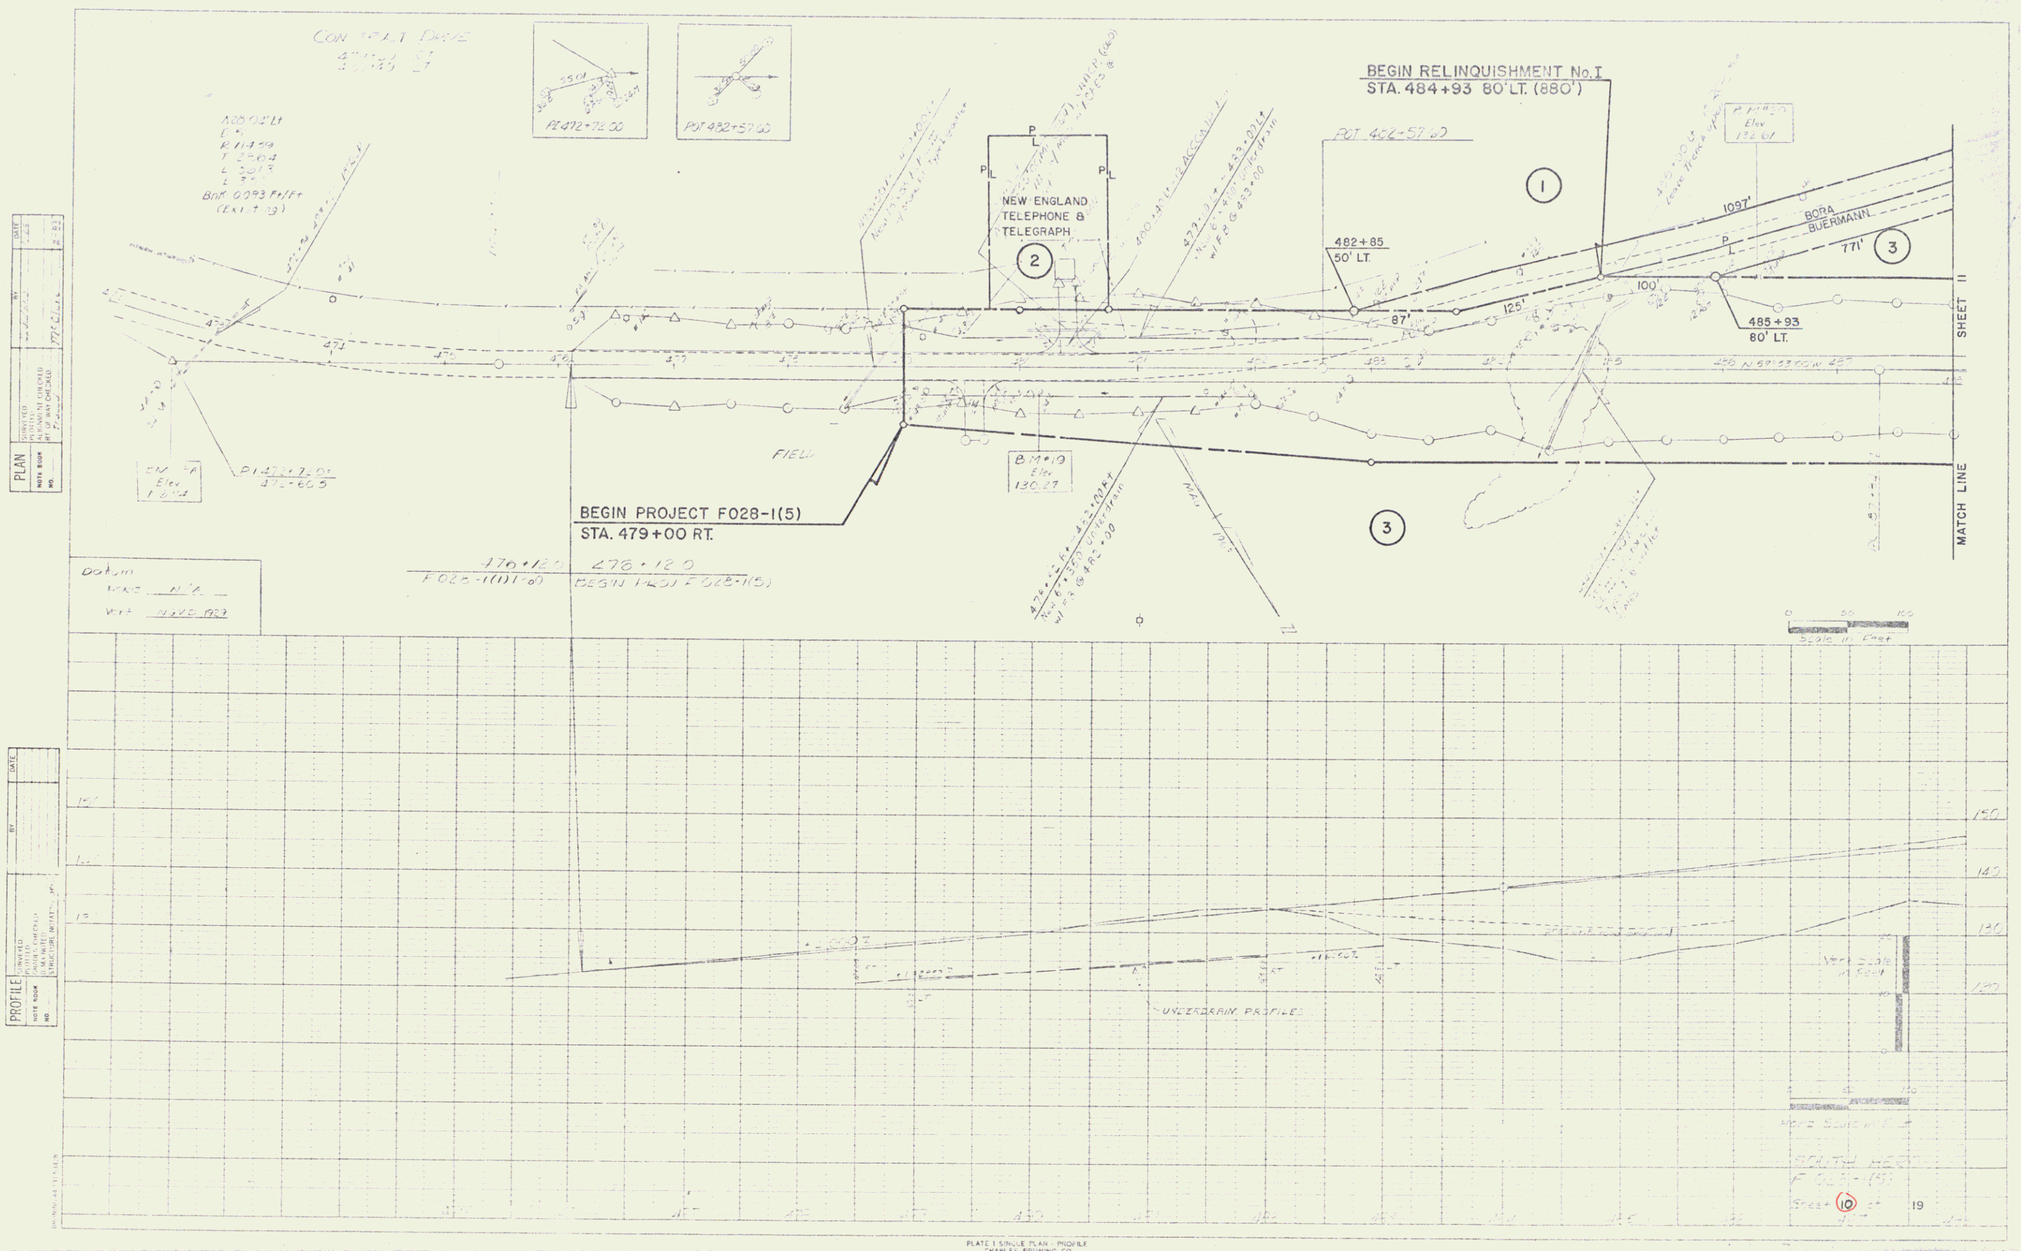

PLATE I SINGLE PLAN - PROFILE
CHARLES BRUNING CO.

7