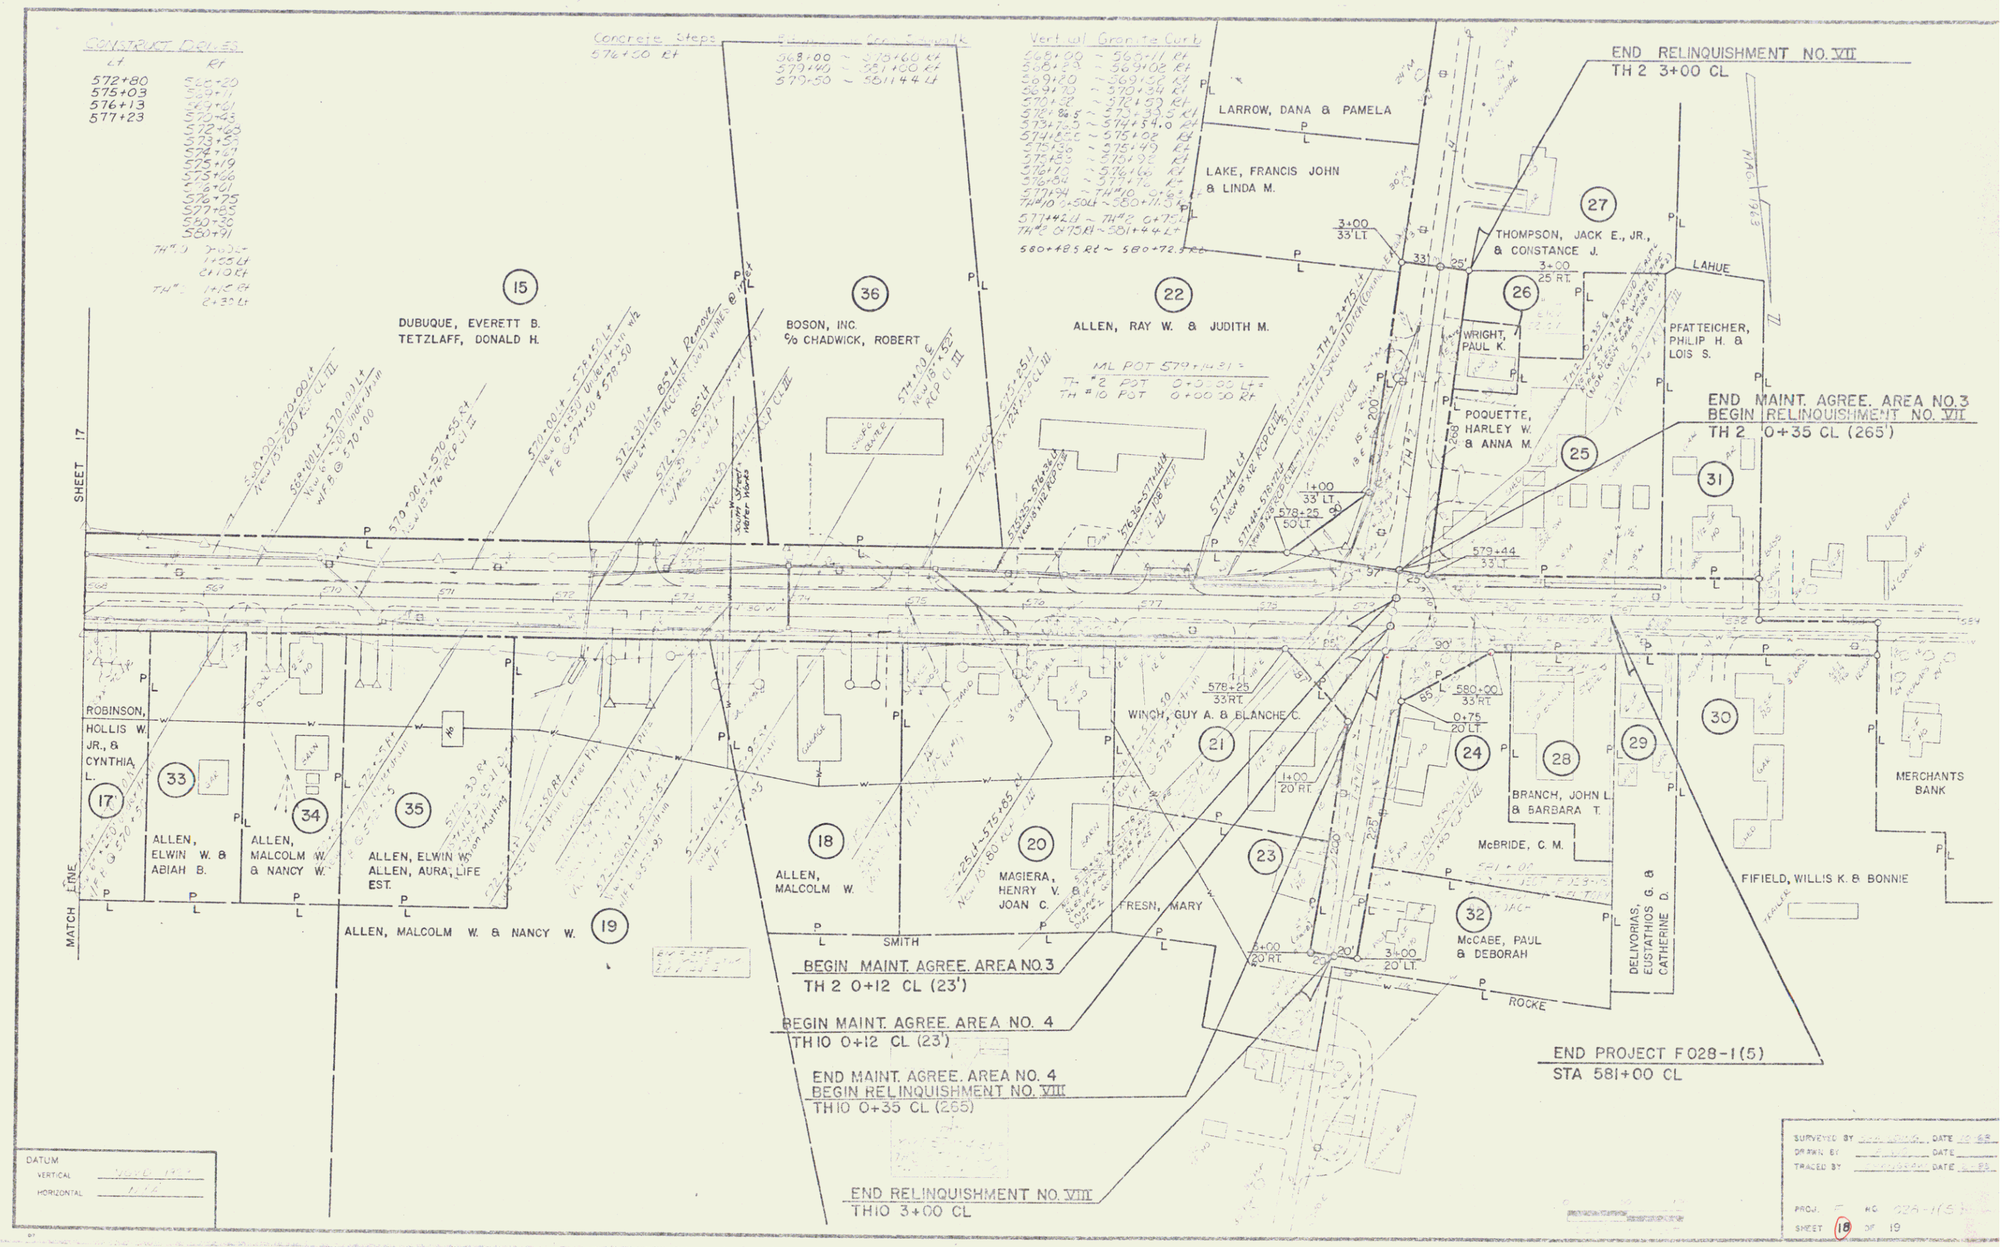
END RELINQUISHMENT NO. VII
TH 2 3+00 CL
LARROW, DANA & PAMELA
LAKE, FRANCIS JOHN & LINDA M.
THOMPSON, JACK E., JR., & CONSTANCE J.
LAHUE
WRIGHT, PAUL K.
PFATTEICHER, PHILIP H. & LOIS S.
POQUETTE, HARLEY W. & ANNA M.
END MAINT. AGREE. AREA NO. 3
BEGIN RELINQUISHMENT NO. VII
TH 2 0+35 CL (265')
DUBUQUE, EVERETT B.
TETZLAFF, DONALD H.
BOSON, INC.
% CHADWICK, ROBERT
ALLEN, RAY W. & JUDITH M.
SHEET 17
ROBINSON, HOLLIS W. JR., & CYNTHIA L.
ALLEN, ELWIN W. & ABIAH B.
ALLEN, MALCOLM W. & NANCY W.
ALLEN, ELWIN W. ALLEN, AURA, LIFE EST.
ALLEN, MALCOLM W.
MAGIERA, HENRY V. & JOAN C.
WINCH, GUY A. & BLANCHE C.
BRANCH, JOHN L. & BARBARA T.
McBRIDE, C. M.
McCABE, PAUL & DEBORAH
DELIVORIAS, EUSTATHIOS G. & CATHERINE D.
FIFIELD, WILLIS K. & BONNIE
MERCHANTS BANK
MATCH LINE
SMITH
ROCKE
BEGIN MAINT. AGREE. AREA NO. 3
TH 2 0+12 CL (23')
BEGIN MAINT. AGREE. AREA NO. 4
TH 10 0+12 CL (23')
END MAINT. AGREE. AREA NO. 4
BEGIN RELINQUISHMENT NO. VIII
TH 10 0+35 CL (265)
END RELINQUISHMENT NO. VIII
TH 10 3+00 CL
END PROJECT F 028-1(5)
STA 581+00 CL
DATUM
VERTICAL
HORIZONTAL
SURVEYED BY
DRAWN BY
TRACED BY
PROJ.
SHEET 18 OF 19

14