STATE OF VERMONT
AGENCY OF TRANSPORTATION

R.O.W. PLANS

PROPOSED IMPROVEMENT

TOWN OF MORRISTOWN
COUNTY OF LAMOILLE
VT. ROUTE 100 (MINOR ARTERIAL)

BEGINNING AT A POINT APPROXIMATELY 3.475 MILES NORTHERLY OF THE STOWE - MORRISTOWN TOWN LINE AND EXTENDING NORTHERLY 0.189 MILES.

LENGTH OF ROADWAY	945	FEET=	0.179 MILES
LENGTH OF BRIDGE	55	FEET=	0.010 MILES
LENGTH OF PROJECT	1000	FEET=	0.189 MILES
LENGTH OF ROW PROJECT	1345	FEET=	0.255 MILES

WORK TO BE PERFORMED UNDER THIS PROJECT CONSISTS OF REPLACEMENT OF AN EXISTING BRIDGE AND NECESSARY APPROACH RECONSTRUCTION.

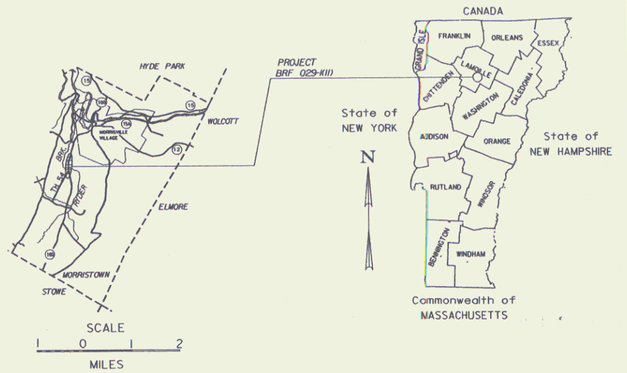

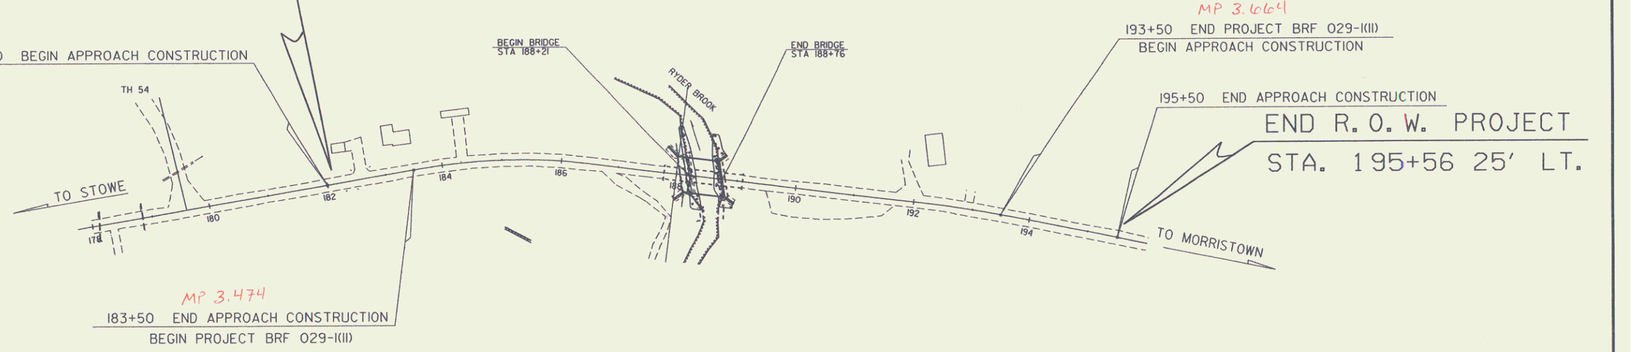

CONVENTIONAL SIGNS

COUNTY LINE
TOWN LINE
LIMITS OF ACCESS
POINT OF ACCESS
FENCE LINE
STONE WALL
TRAVELED WAY
GUARD RAIL
RAILROAD
SURVEY LINE
CULVERT
POWER POLE
TELEPHONE POLE
TREES
CONTROL OF ACCESS
PROPERTY LINE
R.O.W. TAKING LINE
SLOPE RIGHTS
TOP OF CUT
TOE OF SLOPE

DATUM
VERTICAL NGVD 1929
HORIZONTAL N/A

THESE PLANS ARE SUBJECT TO SUCH ENGINEERING CHANGES AS MAY BE REQUIRED BY THE FEDERAL HIGHWAY ADMINISTRATION OR THE CHIEF ENGINEER.

CONSTRUCTION IS TO BE CARRIED ON IN ACCORDANCE WITH THESE PLANS AND THE STANDARD SPECIFICATIONS FOR CONSTRUCTION DATED 1990, AS APPROVED BY THE FEDERAL HIGHWAY ADMINISTRATION ON MARCH 15, 1990 FOR USE ON THIS PROJECT, INCLUDING ALL SUBSEQUENT REVISIONS AND SUCH REVISED SPECIFICATIONS AND SPECIAL PROVISIONS AS ARE INCORPORATED IN THESE PLANS.

1-NOV-1994

Pin # 78D111 12/19/97

APPROVED _____ DATE _____
Director of Engineering

APPROVED _____ DATE _____
Chief of Right of Way

MORRISTOWN
BRF 029-1(11)
R.O.W. SHEET (1) OF 7 SHEETS

JUN 01 2004