INDEX OF SHEETS

SEE SHEET 2

STATE OF VERMONT
AGENCY OF TRANSPORTATION

CONTRACTOR: BLOW & COTE, INC, MORRISVILLE, VT.
CONTRACT DATED: MAY 11, 1989
CONSTRUCTION BEGAN: MAY 15, 1989
CONSTRUCTION COMPLETED:
[illegible] DETAILS
[illegible] JR.

[illegible]

PROPOSED IMPROVEMENT
TOWN OF ST. ALBANS
COUNTY OF FRANKLIN
JUNCTION VT. RTE. 104 & VT. RTE. 36 (F. A. S.)

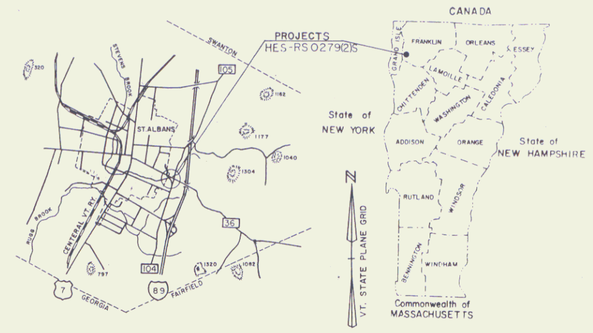

ON VT. RTE. 104 BEGINNING AT A POINT 2.178 MILES NORTHERLY OF THE FAIRFIELD - ST. ALBANS TOWN LINE AND EXTENDING NORTH EASTERLY 0.213 MILES.

WORK TO BE PERFORMED UNDER THIS PROJECT INCLUDES IMPROVING VERTICAL SIGHT DISTANCE, ELIMINATING SIGHT OBSTRUCTIONS, AND IMPROVING SIGN AND SIGNALIZATION.

LENGTH OF ROADWAY 1125 FT. = 0.213 MILE

LENGTH OF PROJECT 1125 FT. = 0.213 MILE

VT. 36	TRAFFIC DATA	VT. 104
1989 ADT = 2385		1989 ADT = 2470
1989 DHV = 335		1989 DHV = 350
2009 ADT = 3240		2009 ADT = 3355
2009 DHV = 455		2009 DHV = 465
D = 51%		D = 53%
T = 4%		T = 14%
V = 40 MPH		V = 40 MPH

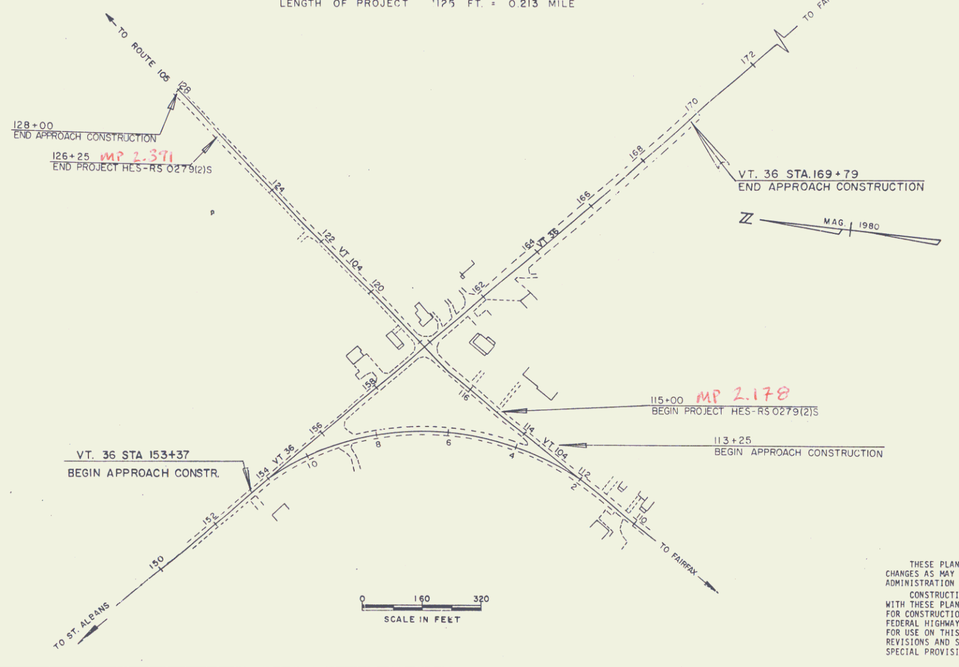

CONVENTIONAL SIGNS

COUNTY LINE
TOWN LINE
LIMITS OF ACCESS
POINT OF ACCESS
FENCE LINE
STONE WALL
TRAVELED WAY
GUARD RAIL
RAILROAD
SURVEY LINE
CULVERT
POWER POLE
TELEPHONE POLE
TREES
CONTROL OF ACCESS
PROPERTY LINE
R.O.W. TAKING LINE
SLOPE RIGHTS
TOP OF CUT
TOE OF SLOPE

DATUM
VERTICAL NGVD 1929
HORIZONTAL N/A

THESE PLANS ARE SUBJECT TO SUCH ENGINEERING CHANGES AS MAY BE REQUIRED BY THE FEDERAL HIGHWAY ADMINISTRATION OR THE CHIEF ENGINEER.

CONSTRUCTION IS TO BE CARRIED ON IN ACCORDANCE WITH THESE PLANS AND THE STANDARD SPECIFICATIONS FOR CONSTRUCTION DATED 1986, AS APPROVED BY THE FEDERAL HIGHWAY ADMINISTRATION ON NOVEMBER 21, 1985 FOR USE ON THIS PROJECT, INCLUDING ALL SUBSEQUENT REVISIONS AND SUCH REVISED SPECIFICATIONS AND SPECIAL PROVISIONS AS ARE INCORPORATED IN THESE PLANS.

PROJECT PROCESSED UNDER SECONDARY ROAD PLAN

SUBMITTED BY ORDER OF THE STATE TRANSPORTATION BOARD

APPROVED David B. Kelley DATE 8/23/88
CHIEF ENGINEER

DEPARTMENT OF TRANSPORTATION
FEDERAL HIGHWAY ADMINISTRATION

APPROVED _____ DATE _____
DIVISION ADMINISTRATOR

PROJECT HES-RS# 0279(2)S
ST. ALBANS
SHEET 1A OF 130 SHEETS

ST ALBANS
HES-RS 0279(2)S

DRAWING 44-131