





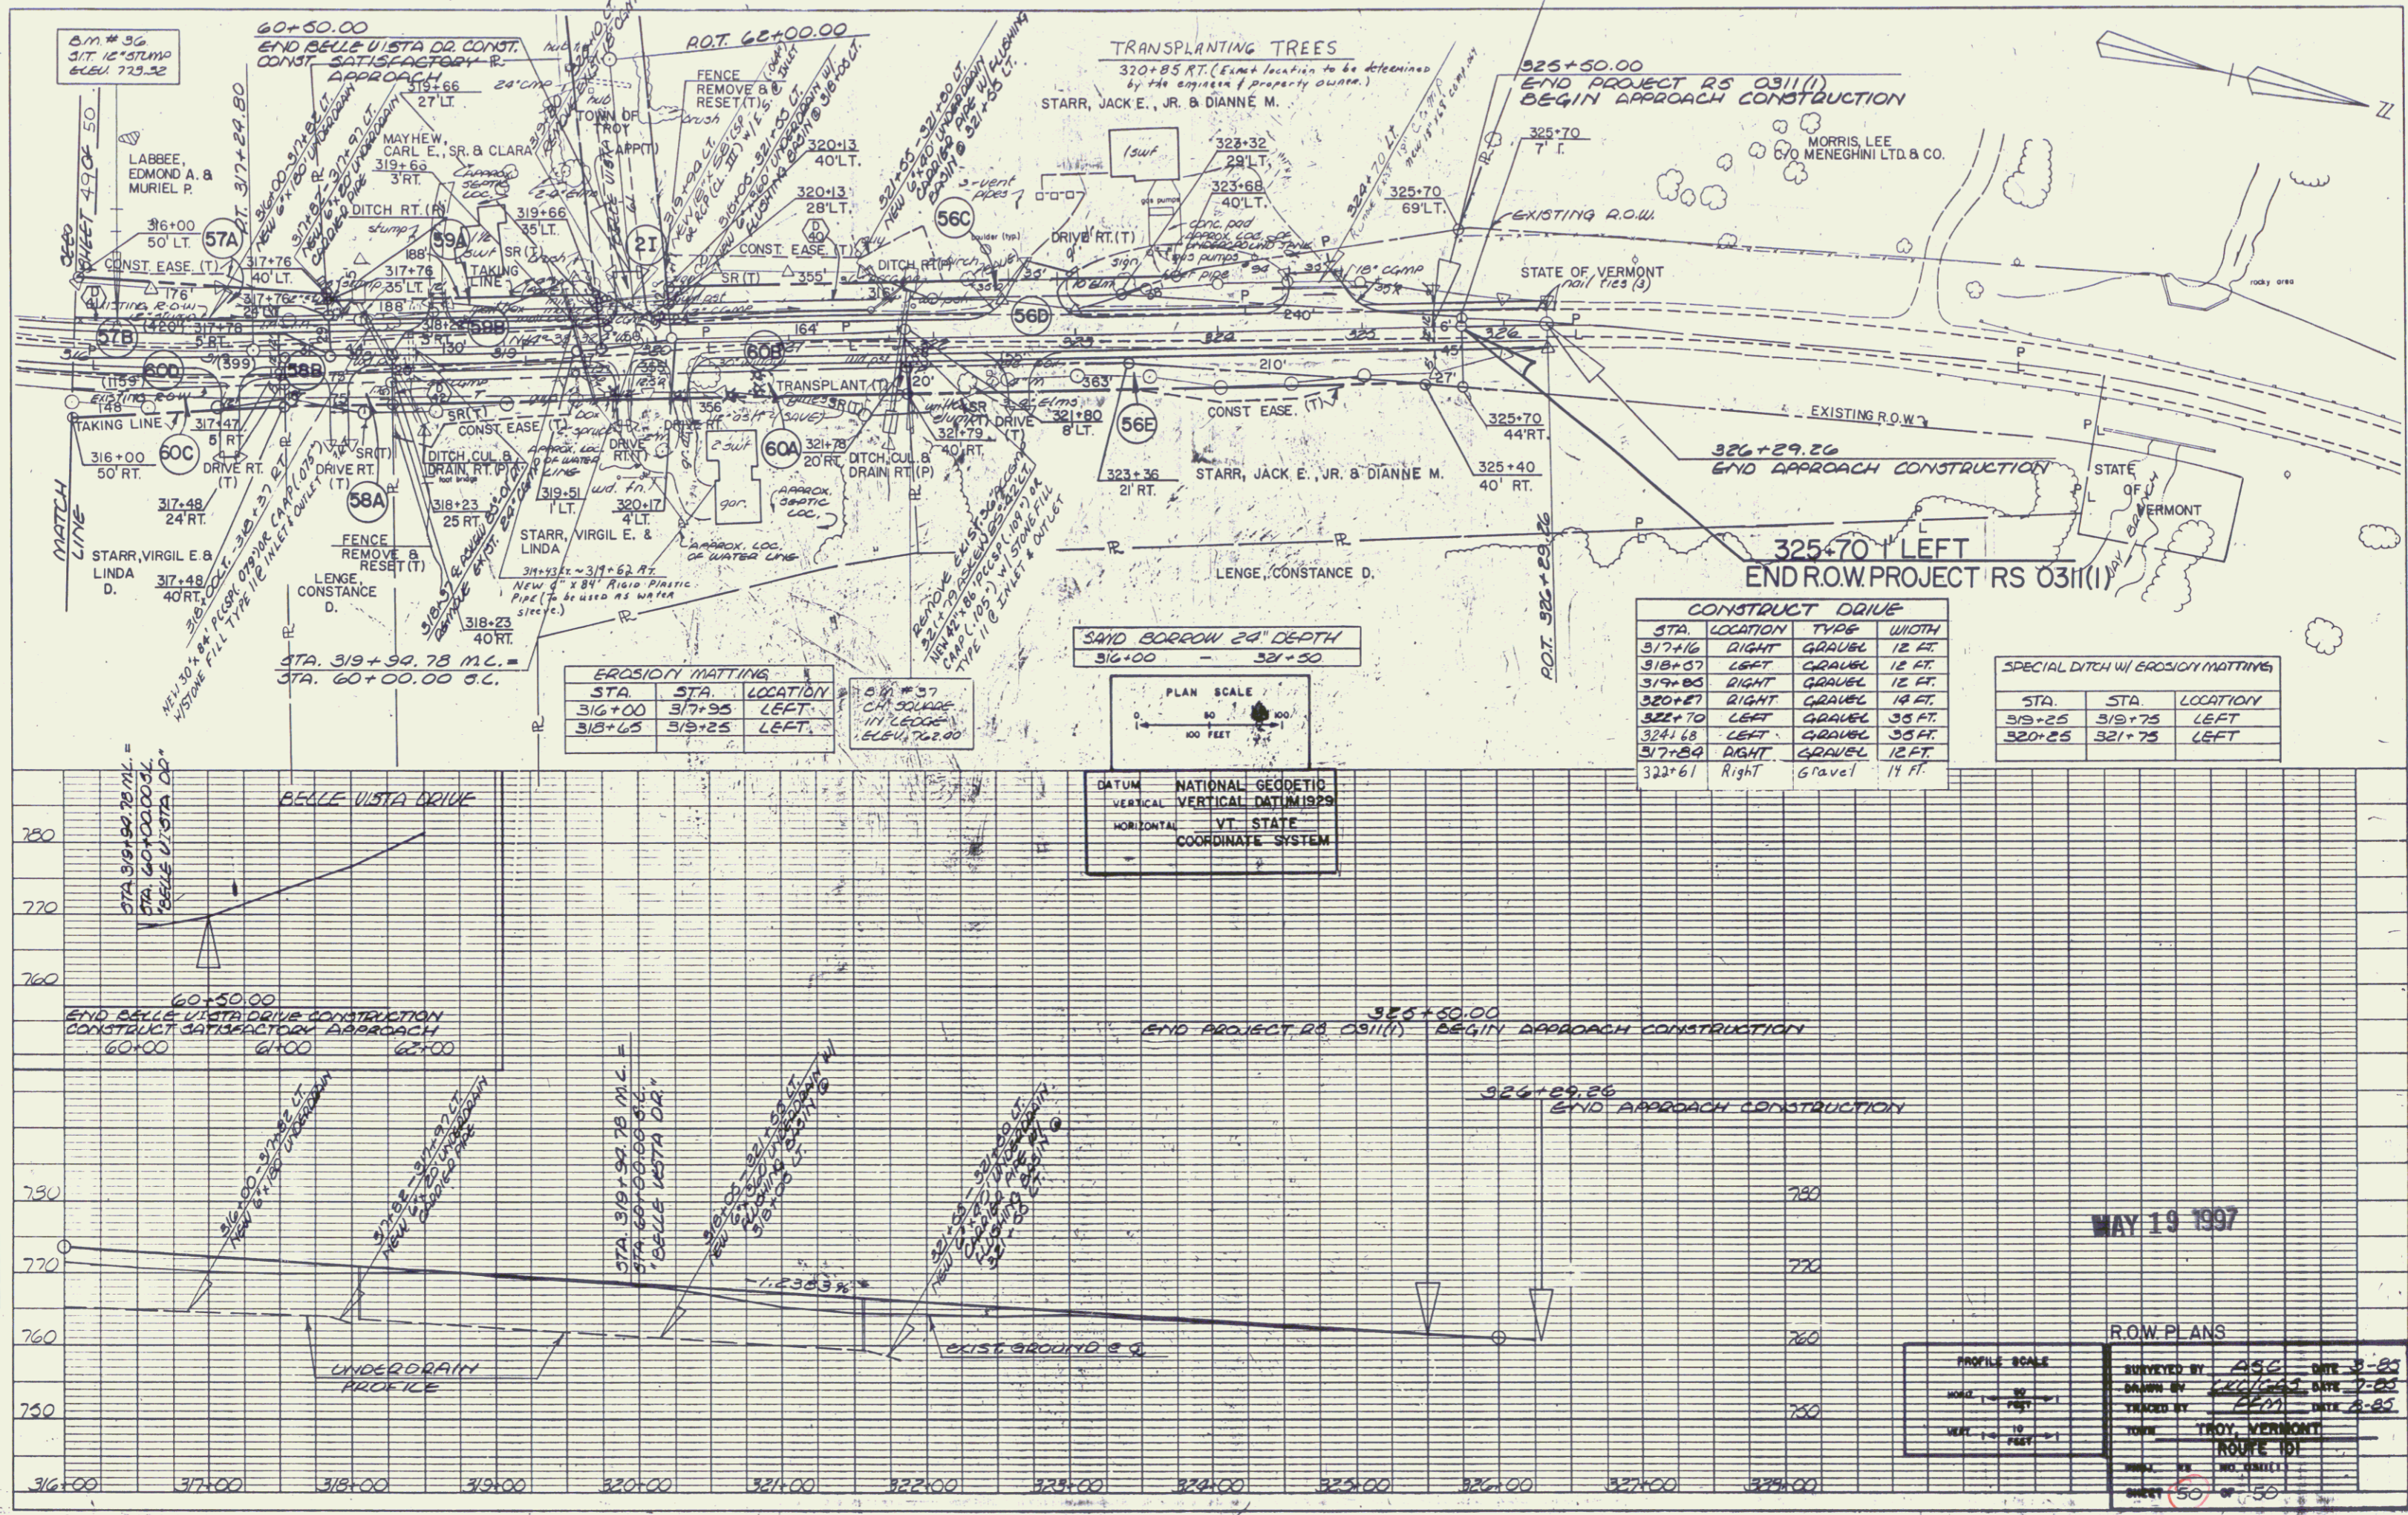

EROSION MATTING

STA.	STA.	LOCATION
316+00	317+95	LEFT

SAND BORROW 24" DEPTH
 316+00 - 321+50

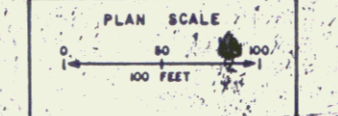

DATUM NATIONAL GEODETIC
 VERTICAL VERTICAL DATUM 1929
 HORIZONTAL VT STATE COORDINATE SYSTEM

CONSTRUCT DRIVE

STA.	LOCATION	TYPE	WIDTH
317+16	RIGHT	GRAVEL	12 FT.
318+07	LEFT	GRAVEL	12 FT.
319+05	RIGHT	GRAVEL	12 FT.
320+27	RIGHT	GRAVEL	14 FT.
322+70	LEFT	GRAVEL	35 FT.
317+24	RIGHT	GRAVEL	12 FT.
322+61	Right	Gravel	14 FT.

SPECIAL DITCH W/ EROSION MATTING

STA.	STA.	LOCATION
319+25	319+75	LEFT
320+25	321+75	LEFT

PROFILE SCALE
 HORIZ. 1" = 40'
 VERT. 1" = 10'

ROW PLANS
 TOWN: TROY, VERMONT
 ROUTE: 101
 SHEET: 50 OF 50

MAY 19 1997