

PLAN
DATE
BY
CHECKED
APPROVED
NOTE BOOK
NO. OF SHEETS
SHEET NO.

PROFILE
DATE
BY
CHECKED
APPROVED
NOTE BOOK
NO. OF SHEETS
SHEET NO.

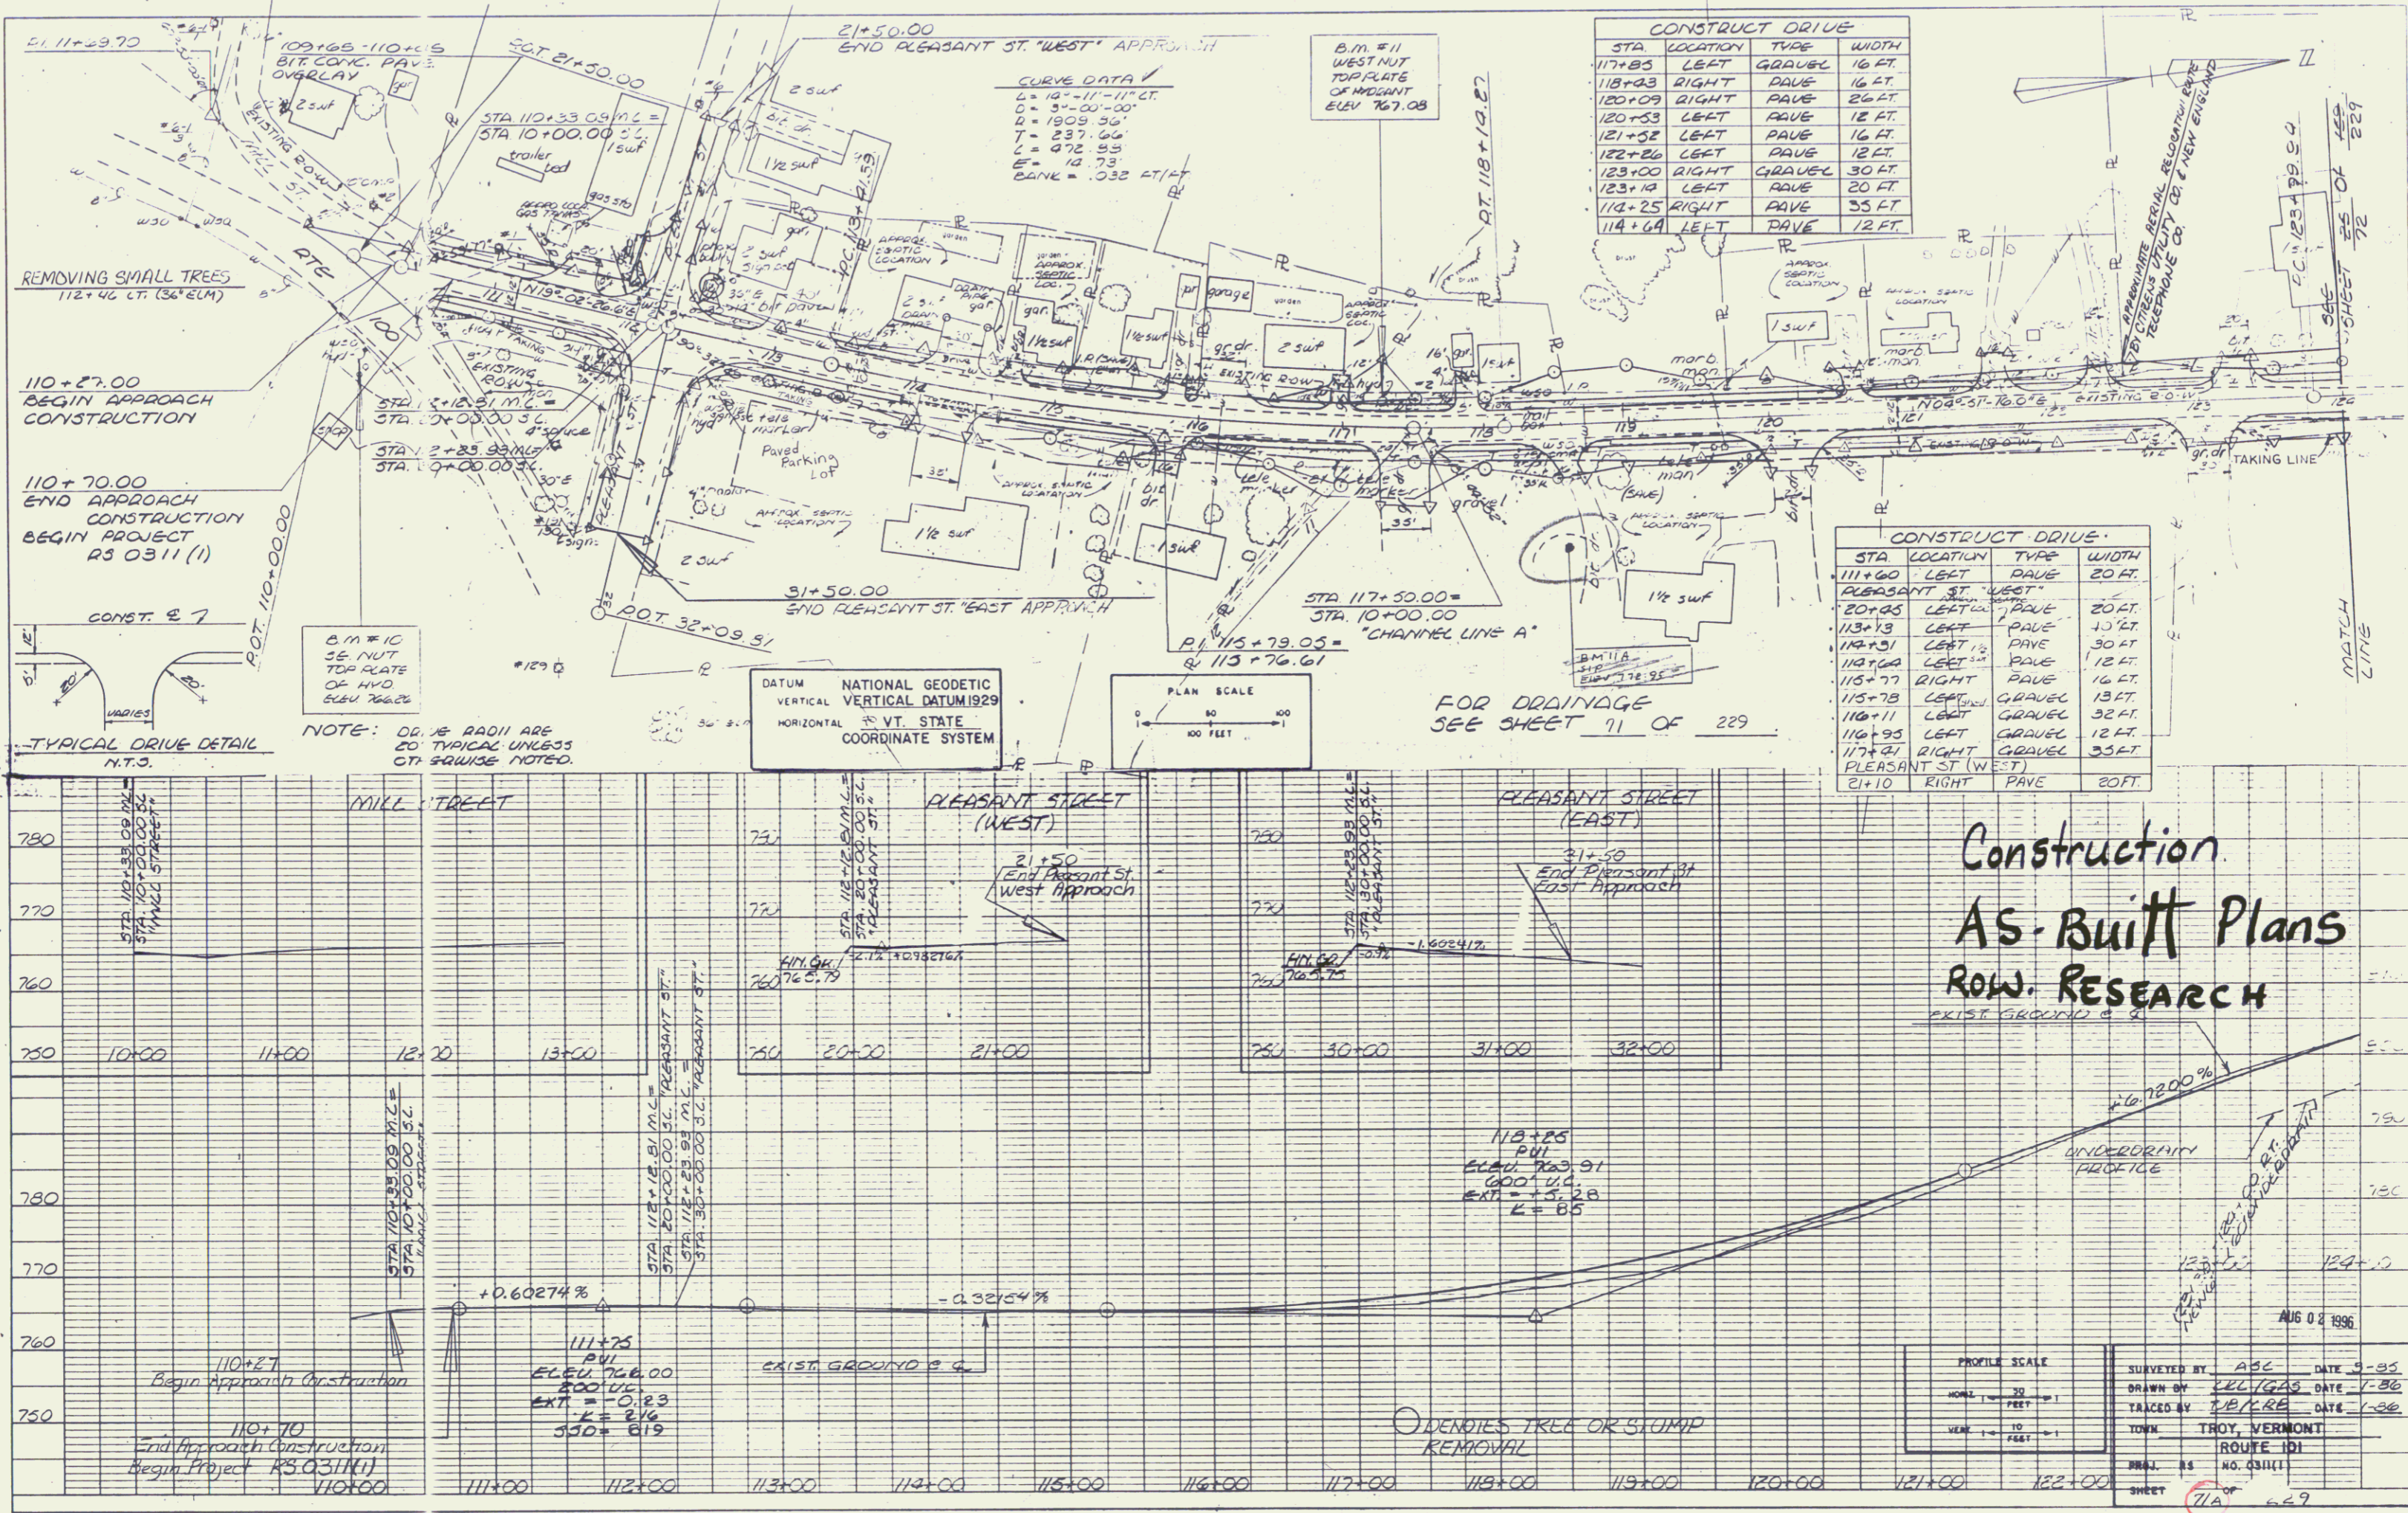


PLATE 1 PLAN PROFILE P.S. & S.I. STANDARD  
 SHEET NO. 629