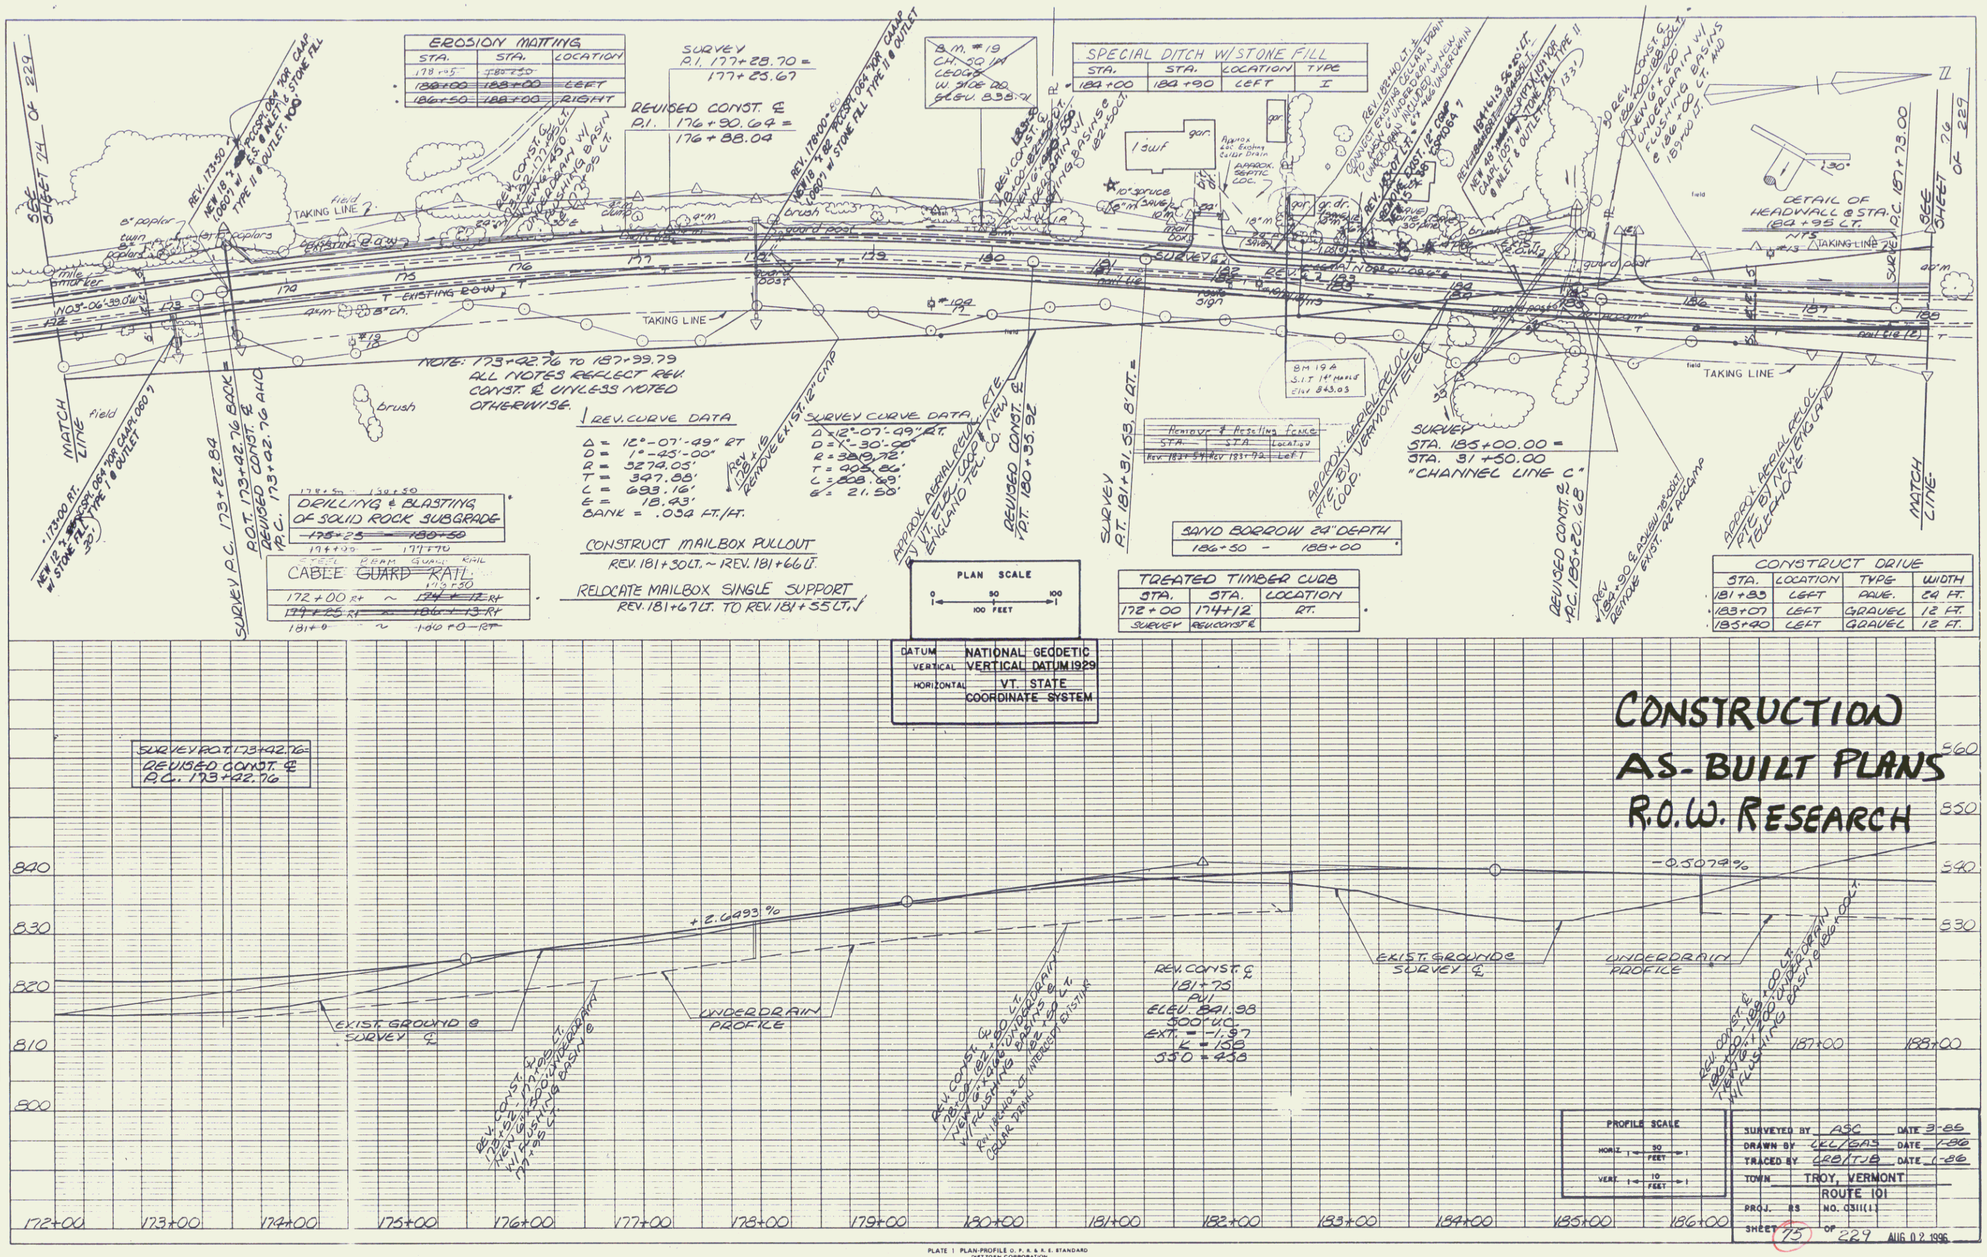
CONSTRUCTION
AS-BUILT PLANS
R.O.W. RESEARCH
EROSION MATTING
SPECIAL DITCH W/STONE FILL
DETAIL OF HEADWALL @ STA. 180+95 LT.
TAKING LINE
MATCH LINE
SURVEY P.C. 173+22.84
R.O.T. 173+02.76 BACK =
REVISED CONST. ℄
P.C. 173+02.76 AHD
SURVEY P.I. 177+28.70 =
177+25.67
REVISED CONST. ℄
P.I. 176+90.64 =
176+88.04
NOTE: 173+02.76 TO 187+99.79
ALL NOTES REFLECT REV.
CONST. ℄ UNLESS NOTED
OTHERWISE.
REV. CURVE DATA
SURVEY CURVE DATA
DRILLING & BLASTING OF SOLID ROCK SUBGRADE
CABLE GUARD RAIL
CONSTRUCT MAILBOX PULLOUT
REV. 181+30 LT. ~ REV. 181+66 LT.
RELOCATE MAILBOX SINGLE SUPPORT
REV. 181+67 LT. TO REV. 181+55 LT.
SURVEY
R.T. 181+81.58, 8' RT. =
REVISED CONST. ℄
P.C. 185+20.68
SURVEY
STA. 185+00.00 =
STA. 81+50.00
"CHANNEL LINE C"
SAND BORROW 24" DEPTH
TREATED TIMBER CURB
CONSTRUCT DRIVE
PLAN SCALE
DATUM
VERTICAL NATIONAL GEODETIC VERTICAL DATUM 1929
HORIZONTAL VT. STATE COORDINATE SYSTEM
SURVEY P.O.T. 173+42.76
REVISED CONST. ℄
P.C. 173+42.76
+2.6493%
-0.5079%
EXIST. GROUND @ SURVEY ℄
UNDERDRAIN PROFILE
REV. CONST. ℄
181+75
P.V.I.
ELEV. 841.98
EXT. = -1.97
K = 158
S50 = 438
PROFILE SCALE
SURVEYED BY ASC DATE 3-86
DRAWN BY JEL/GAS DATE 7-86
TRACED BY CRB/TJB DATE 10-86
TOWN TROY, VERMONT
ROUTE 101
PROJ. BS NO. 0311(1)
SHEET 75 OF 229
AUG 02 1996
PLATE I PLAN-PROFILE O. P. & R. E. STANDARD
DETZORN CORPORATION
PRINTED IN U.S.A.

57