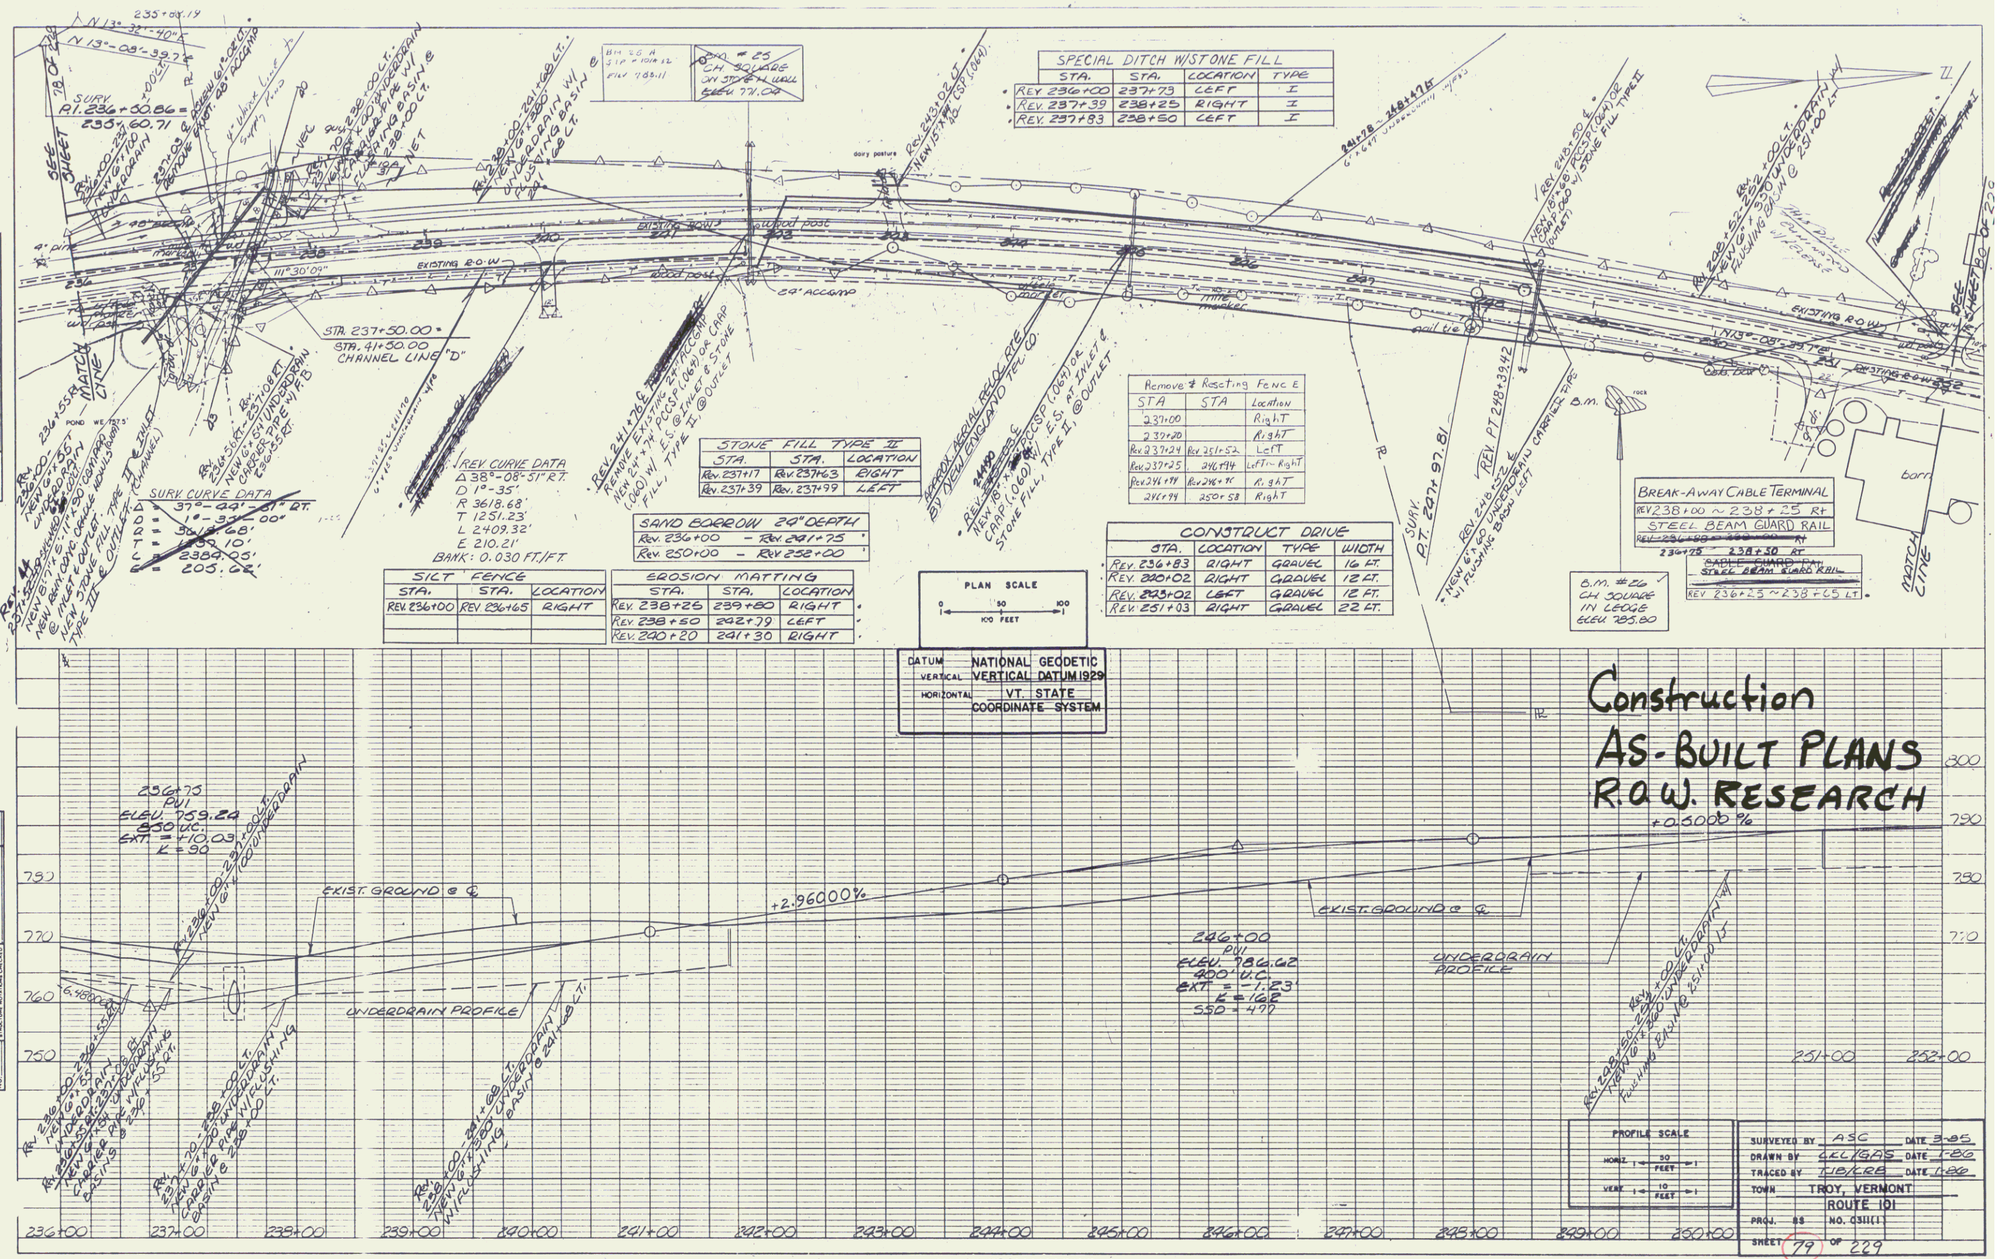
SPECIAL DITCH W/STONE FILL
STA. | STA. | LOCATION | TYPE
REV. 236+00 | 237+73 | LEFT | I
REV. 237+39 | 238+25 | RIGHT | I
REV. 237+83 | 238+50 | LEFT | I
STONE FILL TYPE II
STA. | STA. | LOCATION
Rev. 237+17 | Rev. 237+63 | RIGHT
Rev. 237+39 | Rev. 237+99 | LEFT
SAND BORROW 24" DEPTH
Rev. 236+00 - Rev. 241+75
Rev. 250+00 - Rev. 252+00
SILT FENCE
STA. | STA. | LOCATION
REV. 236+00 | REV. 236+65 | RIGHT
EROSION MATTING
STA. | STA. | LOCATION
REV. 238+25 | 239+80 | RIGHT
REV. 238+50 | 242+79 | LEFT
REV. 240+20 | 241+30 | RIGHT
CONSTRUCT DRIVE
STA. | LOCATION | TYPE | WIDTH
REV. 236+83 | RIGHT | GRAVEL | 16 FT.
REV. 240+02 | RIGHT | GRAVEL | 12 FT.
REV. 243+02 | LEFT | GRAVEL | 12 FT.
REV. 251+03 | RIGHT | GRAVEL | 22 FT.
Remove & Resetting Fence
STA | STA | Location
237+00 | | Right
237+20 | | Right
Rev 237+24 | Rev 251+52 | Left
Rev 237+25 | 246+94 | Left - Right
Rev 246+98 | Rev 248+76 | Right
246+94 | 250+58 | Right
BREAK-AWAY CABLE TERMINAL
REV 238+00 ~ 238+25 Rt
STEEL BEAM GUARD RAIL
238+50 ~ 238+75 Rt
CABLE GUARD RAIL
STEEL BEAM GUARD RAIL
REV 236+25 ~ 238+65 Lt
PLAN SCALE
0 50 100
100 FEET
DATUM VERTICAL NATIONAL GEODETIC VERTICAL DATUM 1929
HORIZONTAL VT. STATE COORDINATE SYSTEM
SURV. PT. 247+97.81
REV. PT 248+39.42
B.M. #26 CH SQUARE IN LEDGE ELEV. 785.80
SURV. CURVE DATA
Δ 37°-44'-51" = D.T.
D 1°-35'
R 3618.68'
T 1251.23'
L 2409.32'
E 210.21'
C = 2389.05'
= 205.62'
REV. CURVE DATA
Δ 38°-08'-51" RT.
D 1°-35'
R 3618.68'
T 1251.23'
L 2409.32'
E 210.21'
BANK: 0.030 FT./FT.
STA. 237+50.00 = STA. 41+50.00 CHANNEL LINE "D"
MATCH LINE
EXISTING R.O.W.
24" ACCGMP
barn
Construction
AS-BUILT PLANS
R.O.W. RESEARCH
PROFILE SCALE
HORIZ. 1" = 50 FEET
VERT. 1" = 10 FEET
+2.96000%
+0.5000%
EXIST. GROUND @ ℄
UNDERDRAIN PROFILE
236+00 PVI ELEV. 759.24 850 U.C. EXT. = +10.03' K = 90
246+00 PVI ELEV. 786.62 400' U.C. EXT. = -1.23' K = 162 SSD = 497
SURVEYED BY ASC DATE 3-85
DRAWN BY CEL/GAS DATE 1-86
TRACED BY JB/CRB DATE 1-86
TOWN TROY, VERMONT
ROUTE 101
PROJ. BS NO. C311(1)
SHEET 79 OF 229
PLATE 1 PLAN-PROFILE O. P. R. & R. E. STANDARD
DIETZGEN CORPORATION
PRINTER, U.S.A.
AUG 02 1996