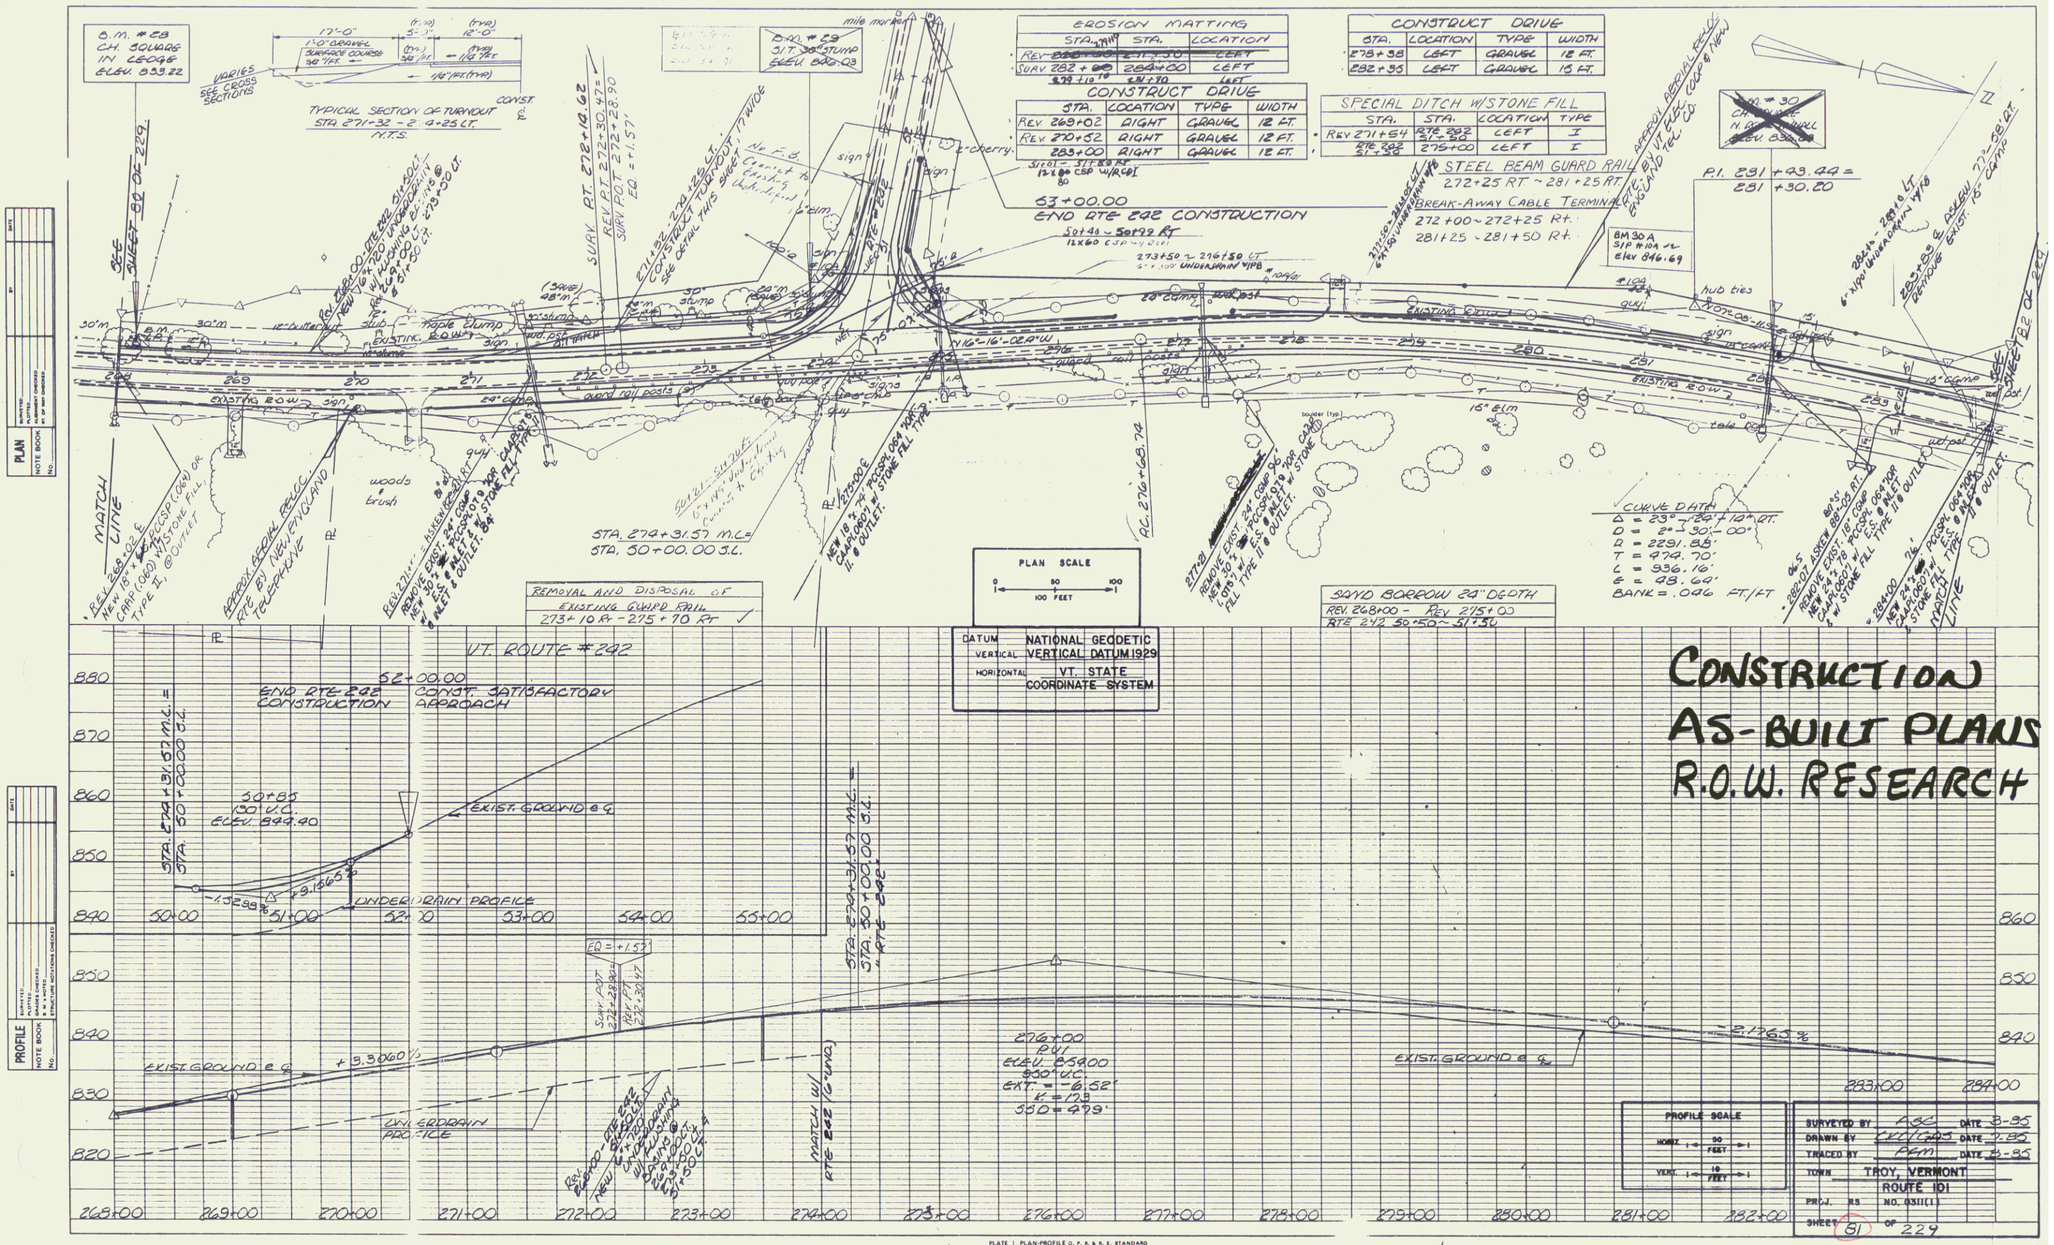

PLATE 1 PLAN-PROFILE O. P. R. & R. E. STANDARD
DIETZGEN CORPORATION
PRINTED IN U.S.A.